


17  
11  
8.5  
8.5  
11  
17

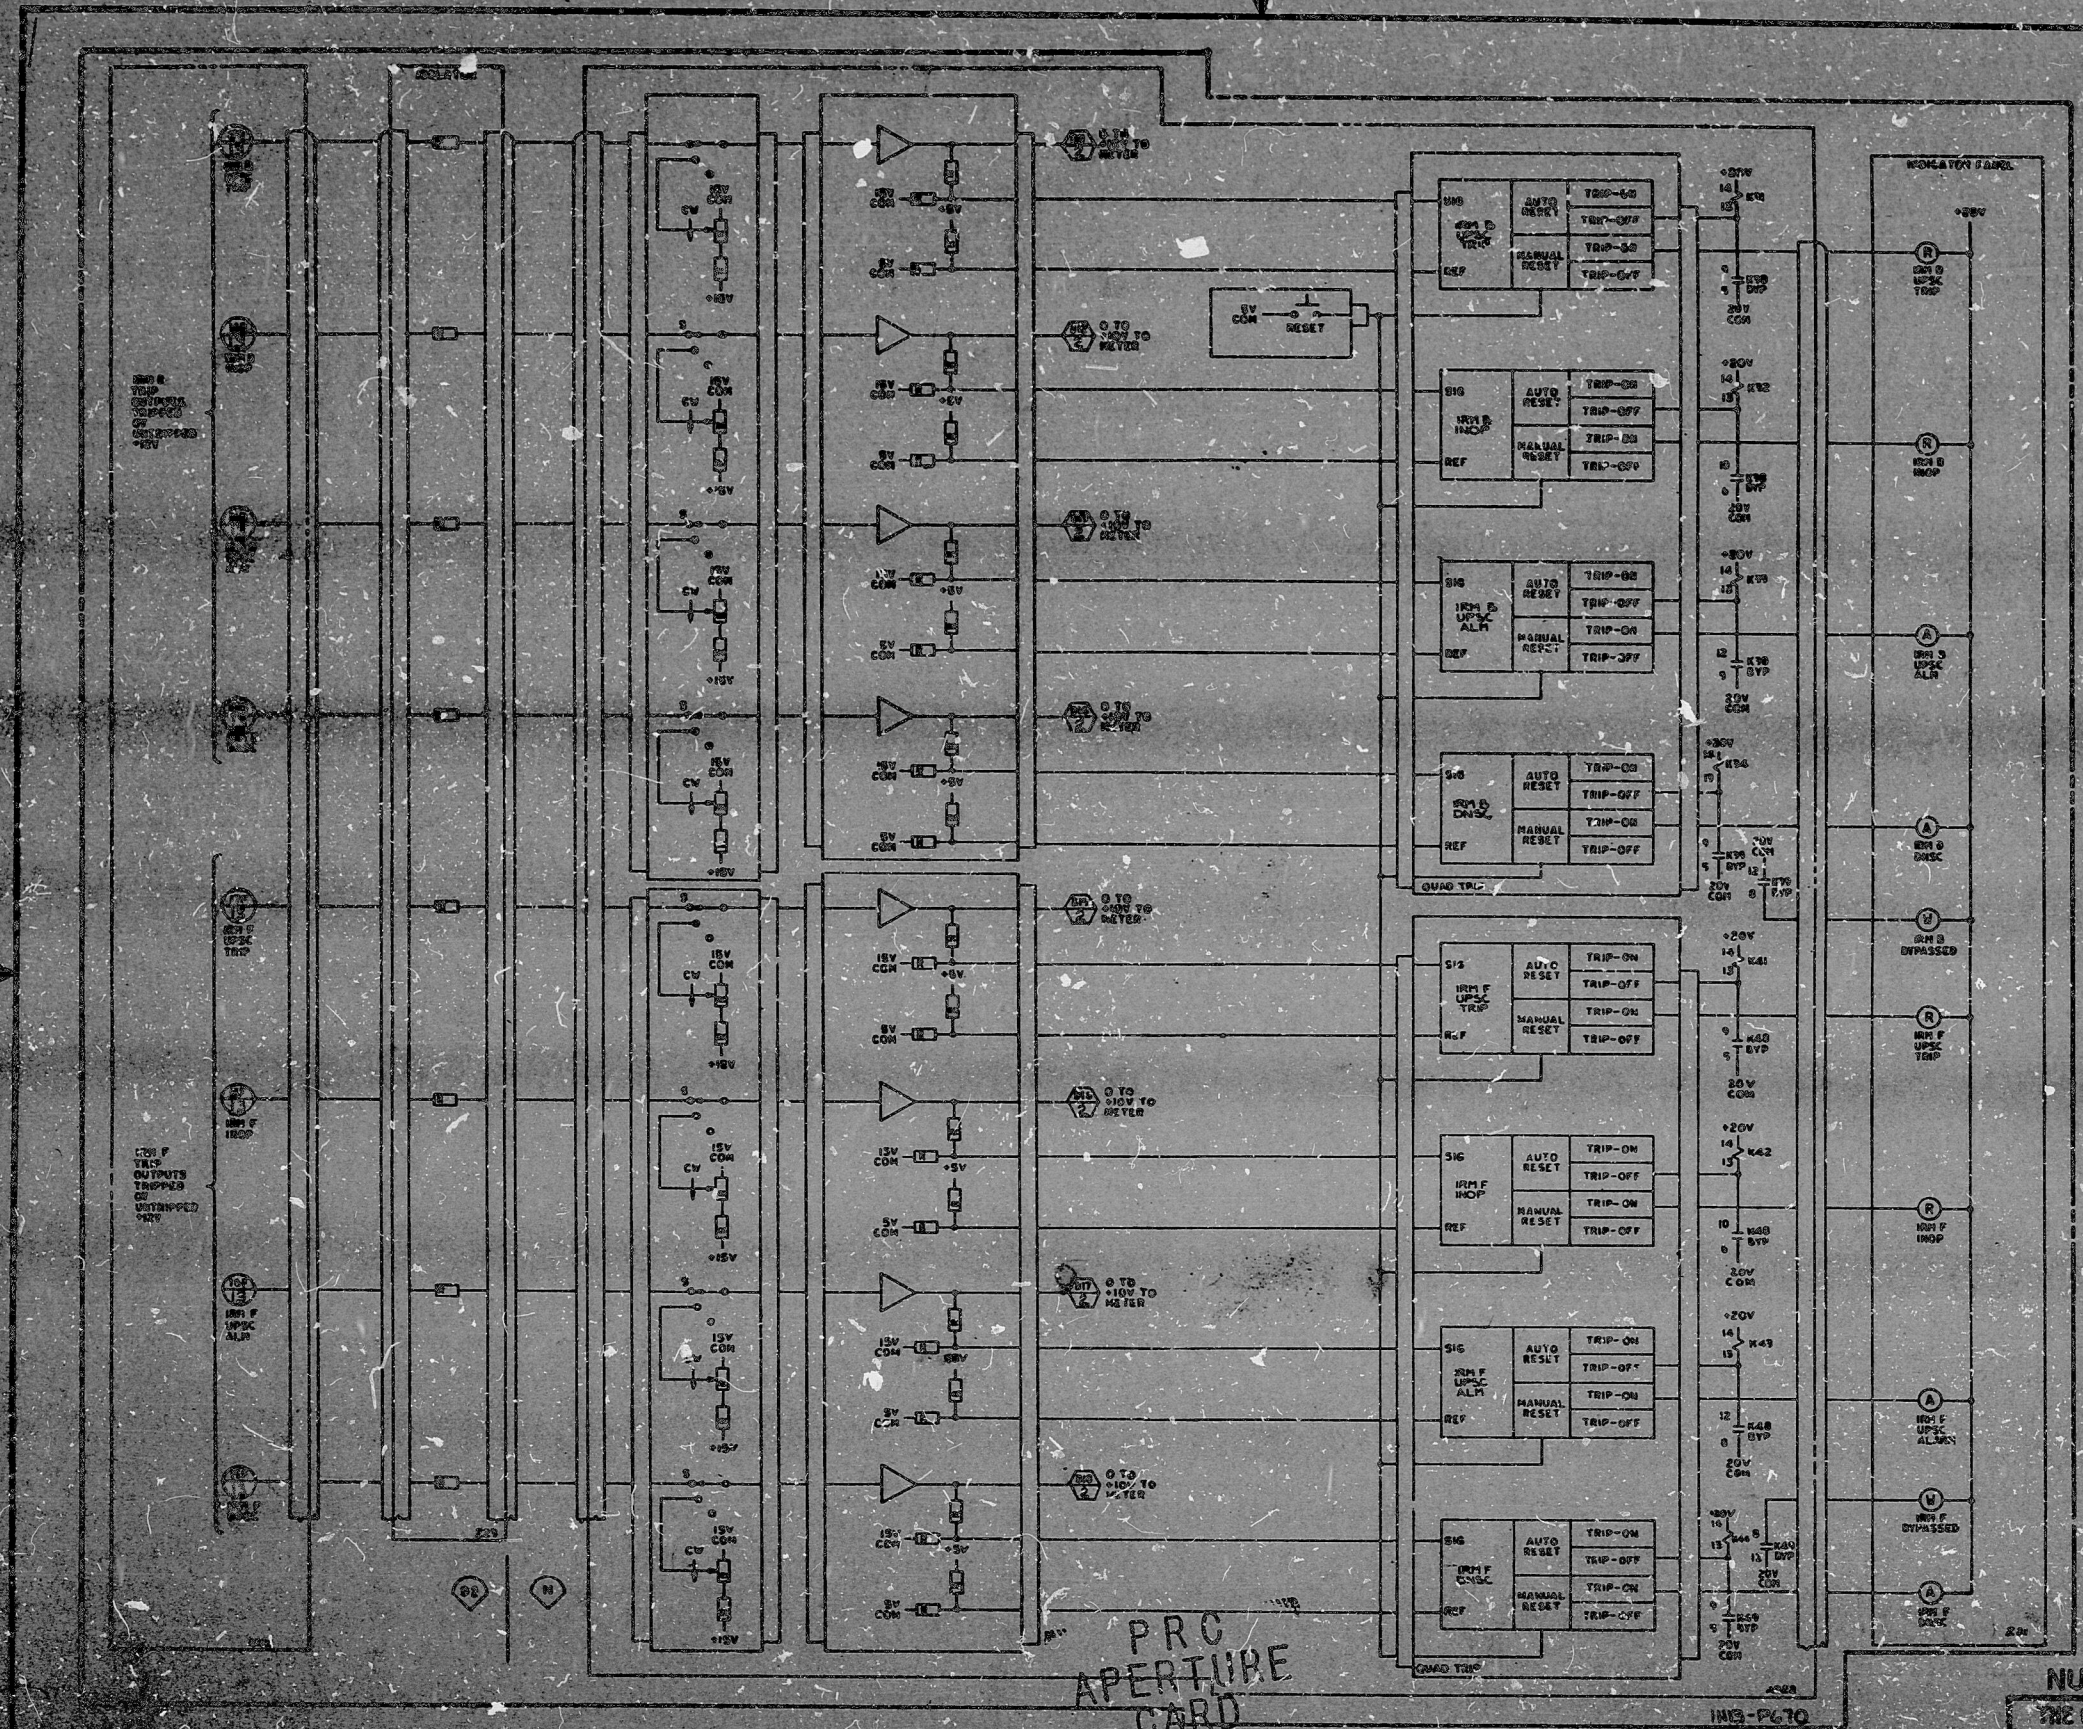

PRC APERTURE CARD

INIS-PC-10

INSTRUMENT FOR NEW DESIGN

REVISIONS  
REV. 17 REV. 0  
START-UP RANGE NEUTRON MONITORING SYS

NUCLEAR SAFETY RELATED  
THE CLEVELAND ELECTRIC POWER CO.

PERMIT CLEVELAND POWER PLANT  
DESIGN AND CONSTRUCTION

START-UP RANGE NEUTRON MONITORING SYS  
FOR CLEVELAND ELECTRIC POWER CO.

M  
MODIFIED INACTIVE LOGIC  
PER GE RELAY

2-77  
CONSTRUCTION  
PRELIMINARY  
FOR REVIEW

17  
11  
8.5  
8.5  
11  
17



Picks

8212140066

