
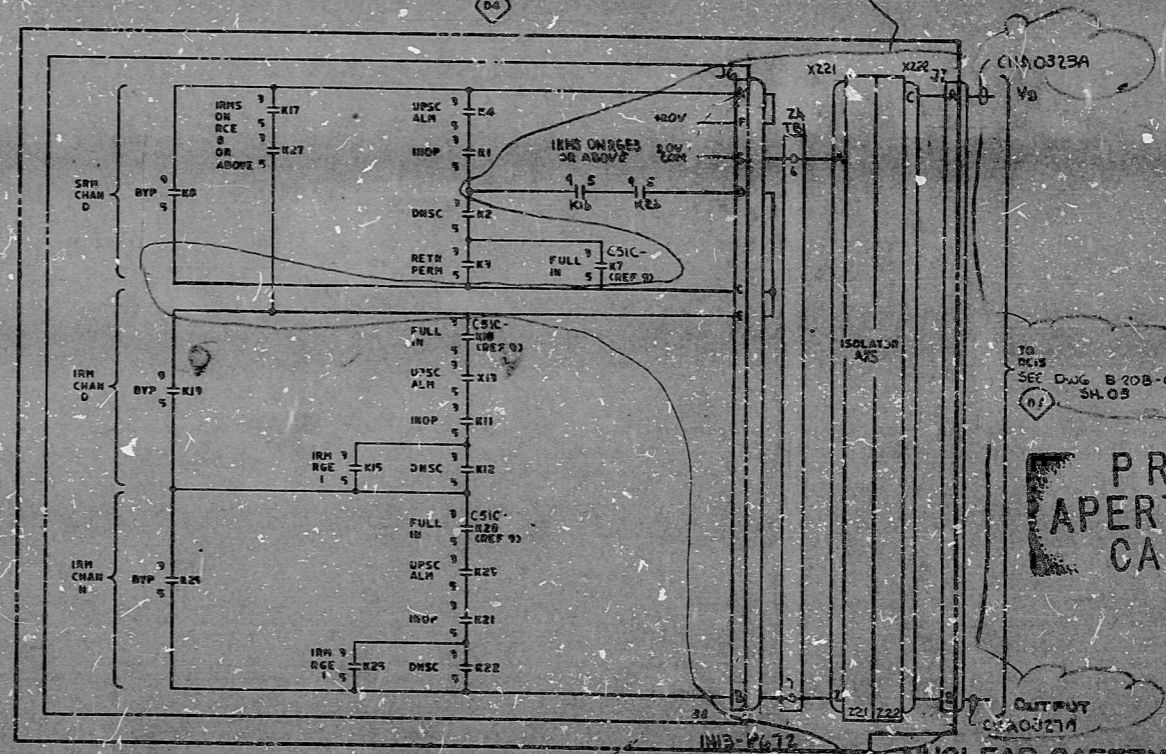
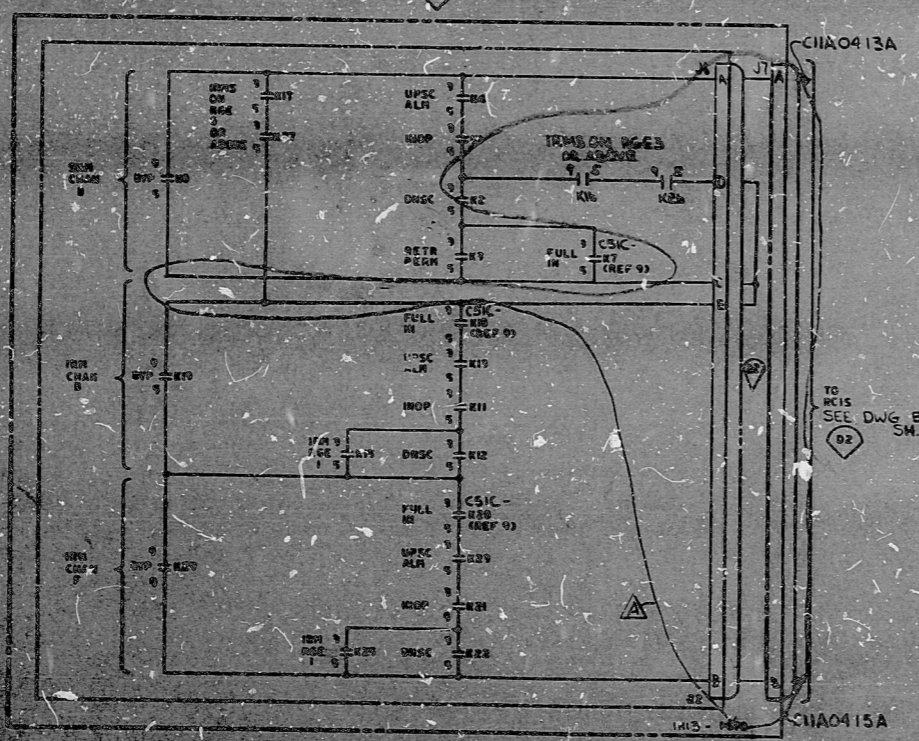
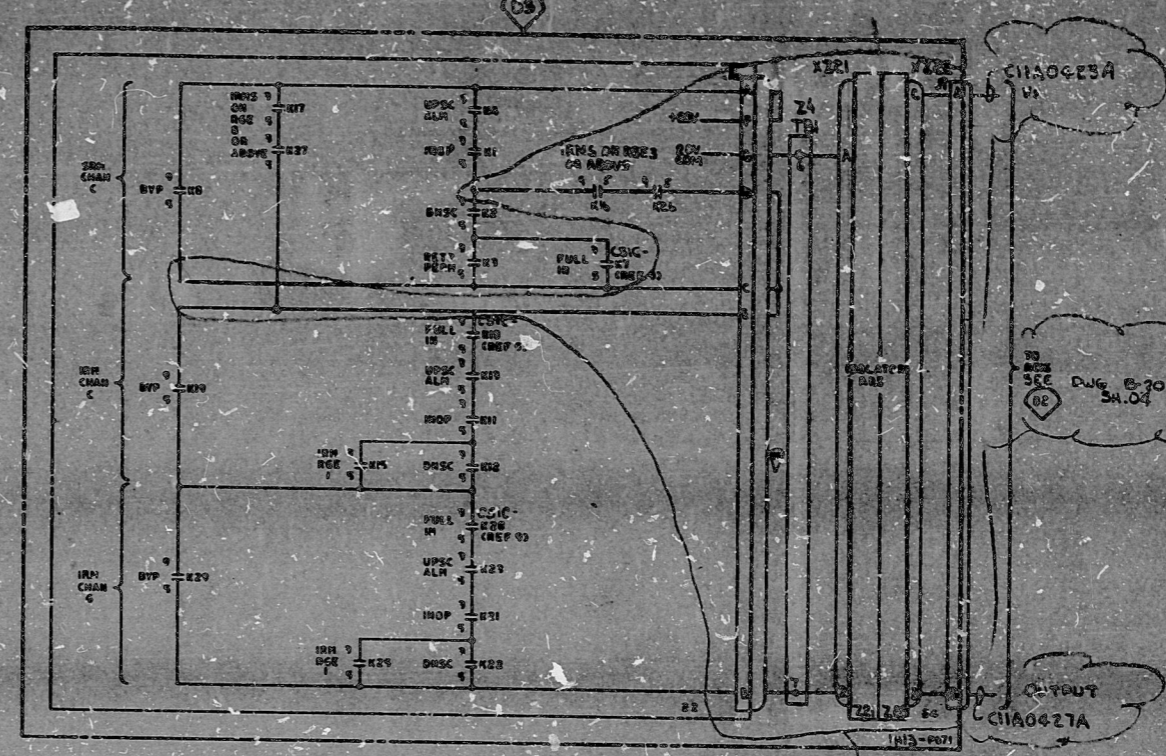


11
11
8.5
8.5
11
17

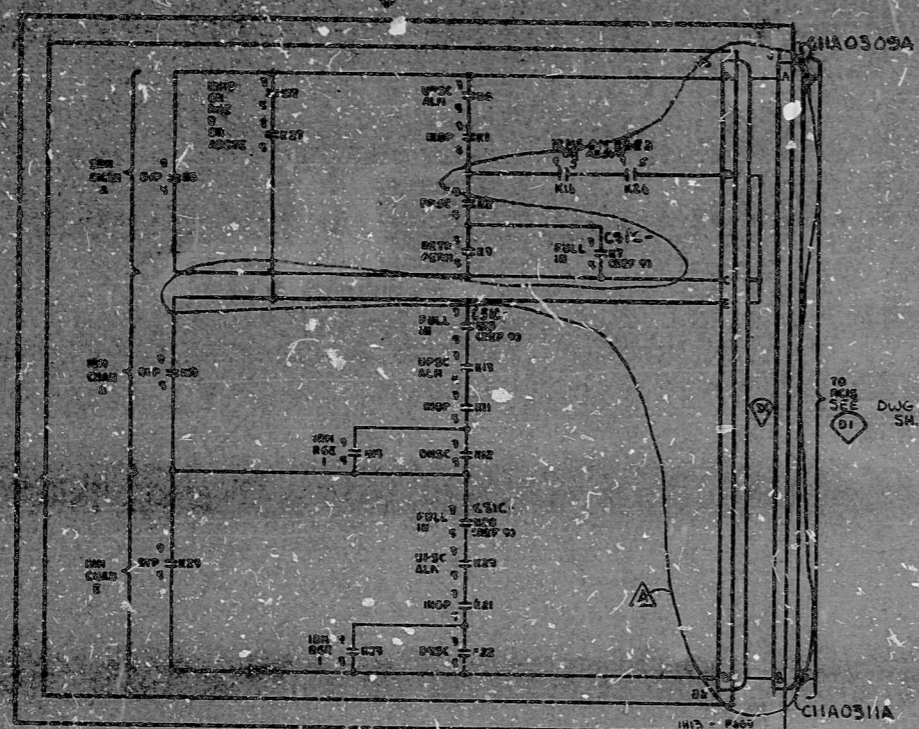

PRC APERTURE CARD

NUCLEAR SAFETY RELATED

GENERAL DESIGN 1251584 SH.25 REV.7 START-UP RANGE NEUTRON MON SYS

7-17	CONSTRUCTION	VAR
	PRELIMINARY	
DATE	RELEASED BY	NOV

THE CLEVELAND ELECTRIC ENGINEERING CO.
 PERRY POWER REACTOR PLANT
 INSTRUMENT ELECTRICAL SYSTEM
 START-UP RANGE NEUTRON MONITORING SYS
 PART OF THE INSTRUMENT ELECTRICAL SYSTEM

CHANGED JACK DESIGNATION ADDED TB1 AND TERMIN IMPOR

A Y 2 JAN DEC 2000

GEORGE ASSOCIATES, INC. ENGINEERS AND CONSULTANTS

11
11
8.5
8.5
11
17

Rids

8212140081

