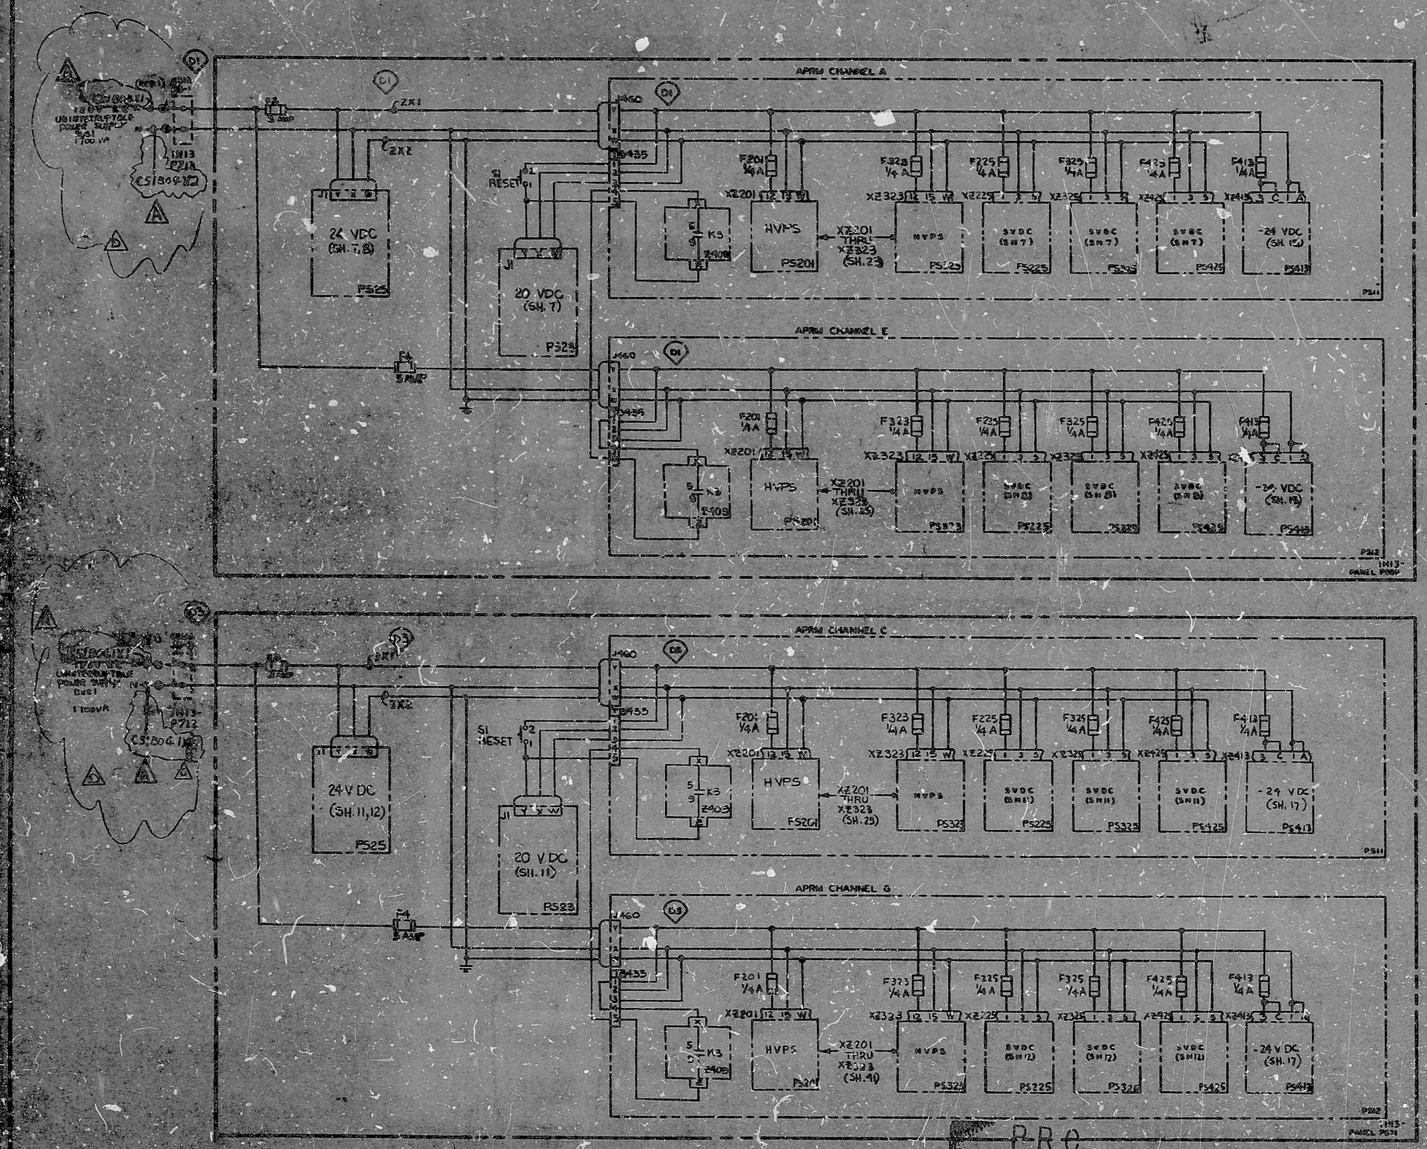
APRM CHANNEL A
APRM CHANNEL E
APRM CHANNEL C
APRM CHANNEL G
24 VDC (SH. 7,8)
20 VDC (SH. 7)
24 V DC (SH. 11,12)
20 V DC (SH. 11)
HVPS
-24 VDC (SH. 15)
-24 V DC (SH. 17)
LINE CODES NONE THIS SHEET
POWER RANGE NEUTRON MON SYS
NUCLEAR SAFETY RELATED
THE CLEVELAND ELECTRIC ILLUMINATING CO.
POWER RANGE NEUTRON MONITORING SYSTEM
CHANGED WIRE MARK
REDRAWN PER GE REVISION G
WIRE DESIGNATIONS ADDED PER DRAFTING CHANGE
GILBERT ASSOCIATES, INC.
CONSTRUCTION
PRELIMINARY
APERTURE CARD

Rids

8212140096

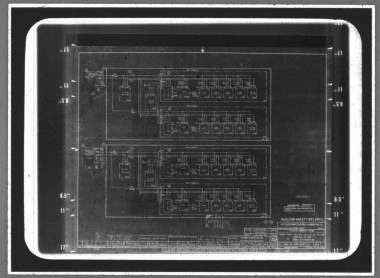

MMM 5824 — FILMSORT® Brand Aperture & Camera Cards and DUPLICARD® Brand Copy Cards — Product of 3M Company, St. Paul, Minn.