


DIVISIONAL DC POWER DISTRIBUTION
P672

ALL WRITING UNLESS OTHERWISE
INDICATED ON THIS SHEET

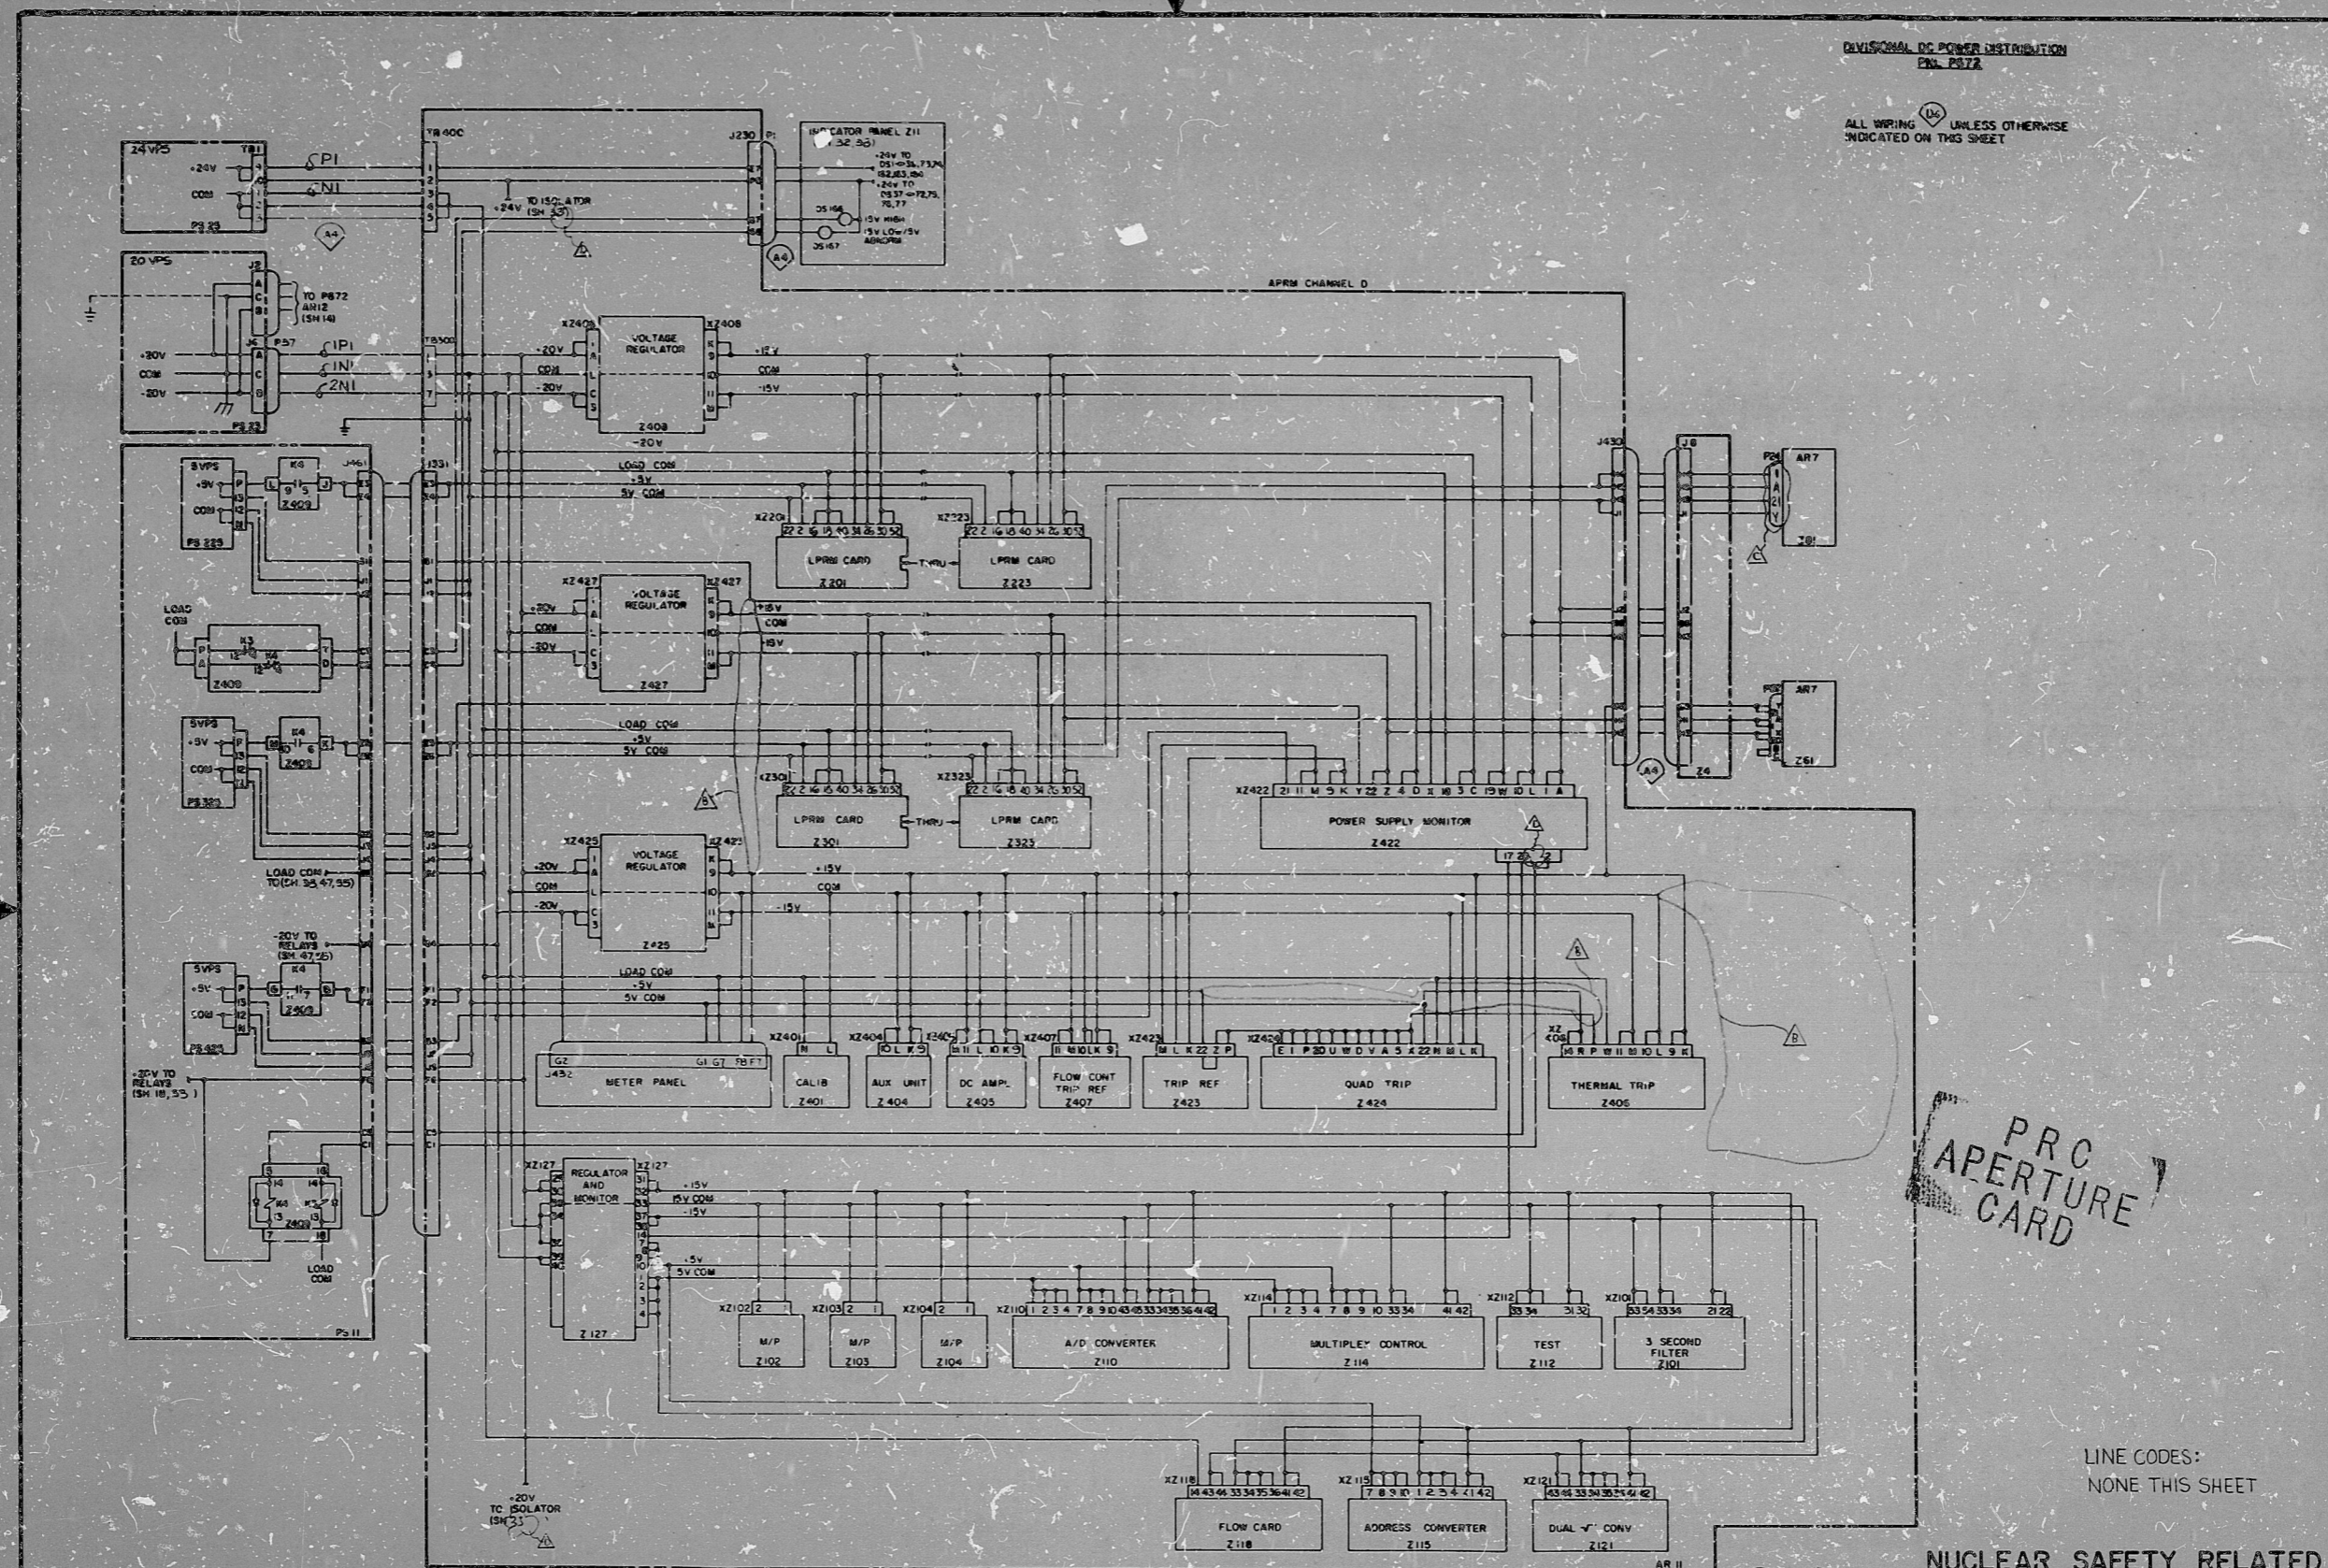

PRC
APERTURE
CARD

LINE CODES:
NONE THIS SHEET

NUCLEAR SAFETY RELATED

THE CLEVELAND ELECTRIC ILLUMINATING CO.
PERRY NUCLEAR POWER PLANT UNIT 1
ELECTRICAL-ELEMENTARY DIAGRAM
POWER RANGE NEUTRON MONITORING SYSTEM
DC POWER DISTRIBUTION PANEL P672

GENERAL ELECTRIC 828E230CJ
ELEM DIAG SH. 13 REV. 9
POWER RANGE NEUTRON MON. SYS.

9-1-77	CONSTRUCTION	
	PRELIMINARY	
	RELEASED FOR	ENGR.

GLBERT ASSOCIATES, INC.
ENGINEERS AND CONSULTANTS

REVISED PERGE DRAWING REV 9	CHANGED PLUG DESIGNATION	DELETED Z402 & Z403 & WIRE BETWEEN Z425 & Z427 CHANGED CONNECT BETWEEN Z428 & Z408	REDRAWN PERGE REVISION 6																	
D SLM TAM DEG RAM 7/19/82	C YZ PM DEG RAM 4-11-81	B YZ PM DEG RAM 11/1/80	A CAM RAM DEG RAM 1-30-80																	
REV	MADE	CHKD	APPROVALS	DATE	REV	MADE	CHKD	APPROVALS	DATE	REV	MADE	CHKD	APPROVALS	DATE	REV	MADE	CHKD	APPROVALS	DATE	

ELEM DIAG ICSIB DC PWR IH13-P672

17"

11"

8.5"

8.5"

11"

17"

17"

11"

8.5"

8.5"

11"

17"

Rids

8212140117

