


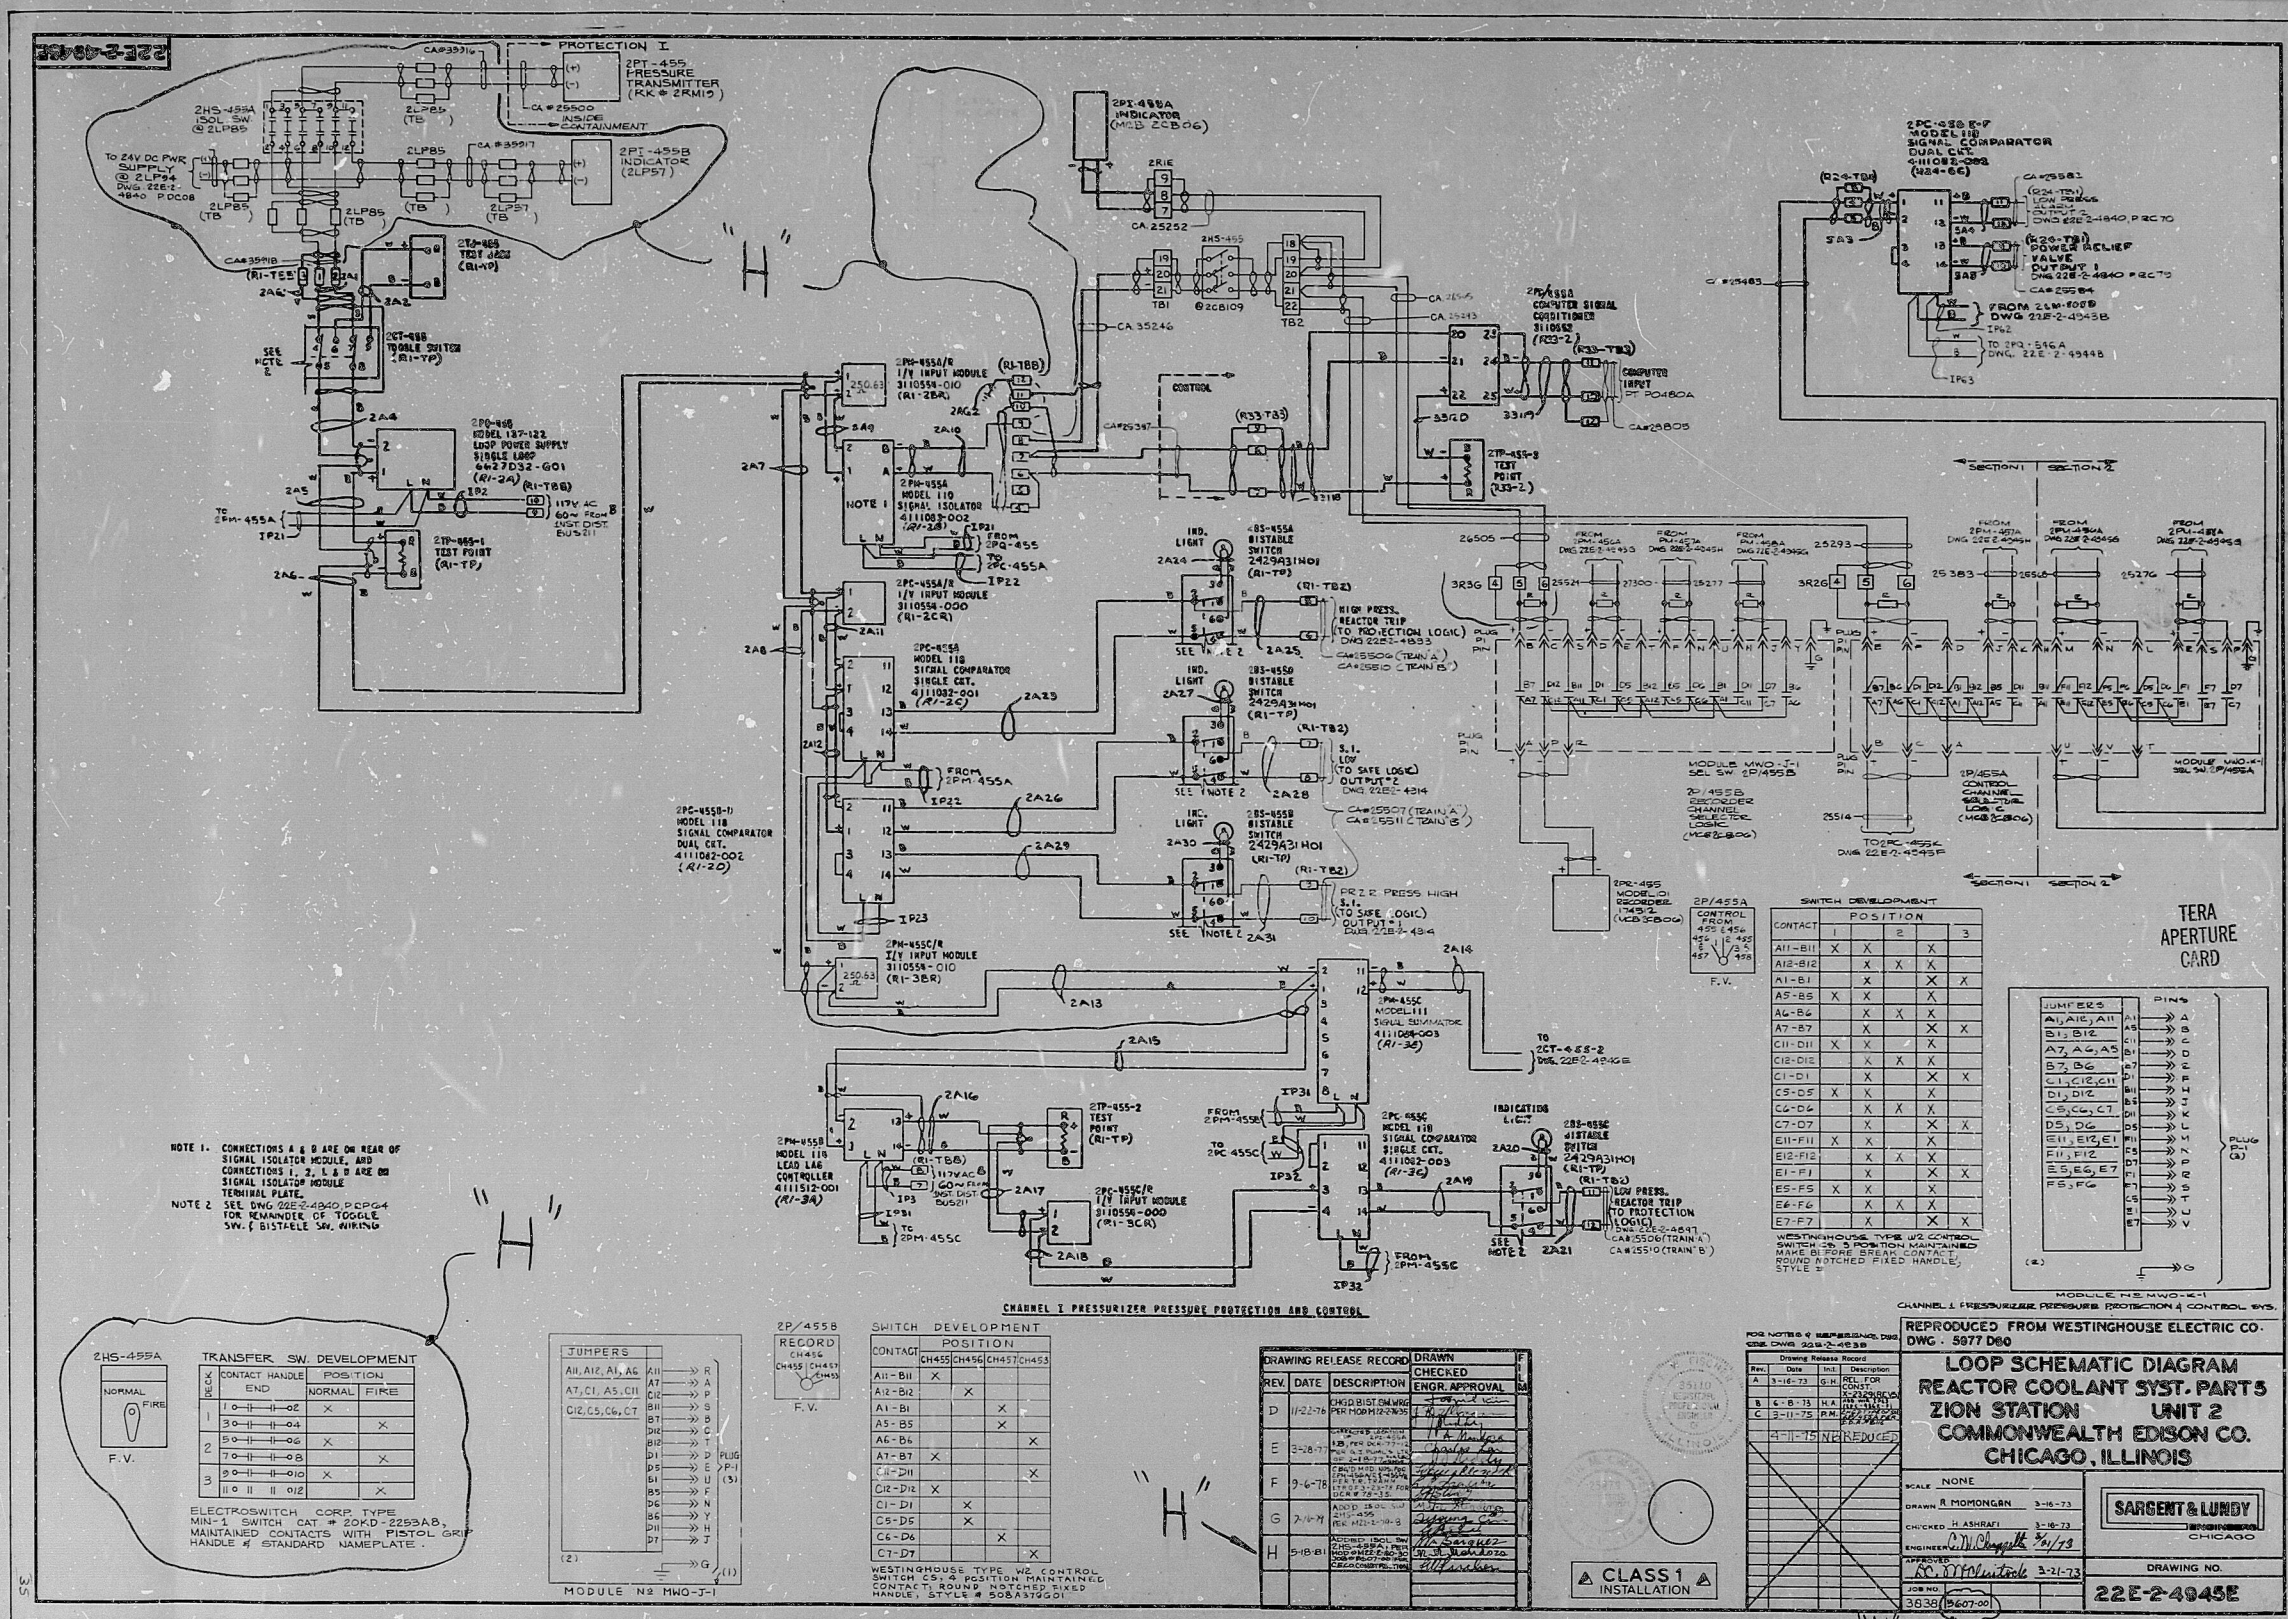



R+DS

8107010036

