

11

11

8.5

8.5

11

17

11

11

8.5

8.5

11

17

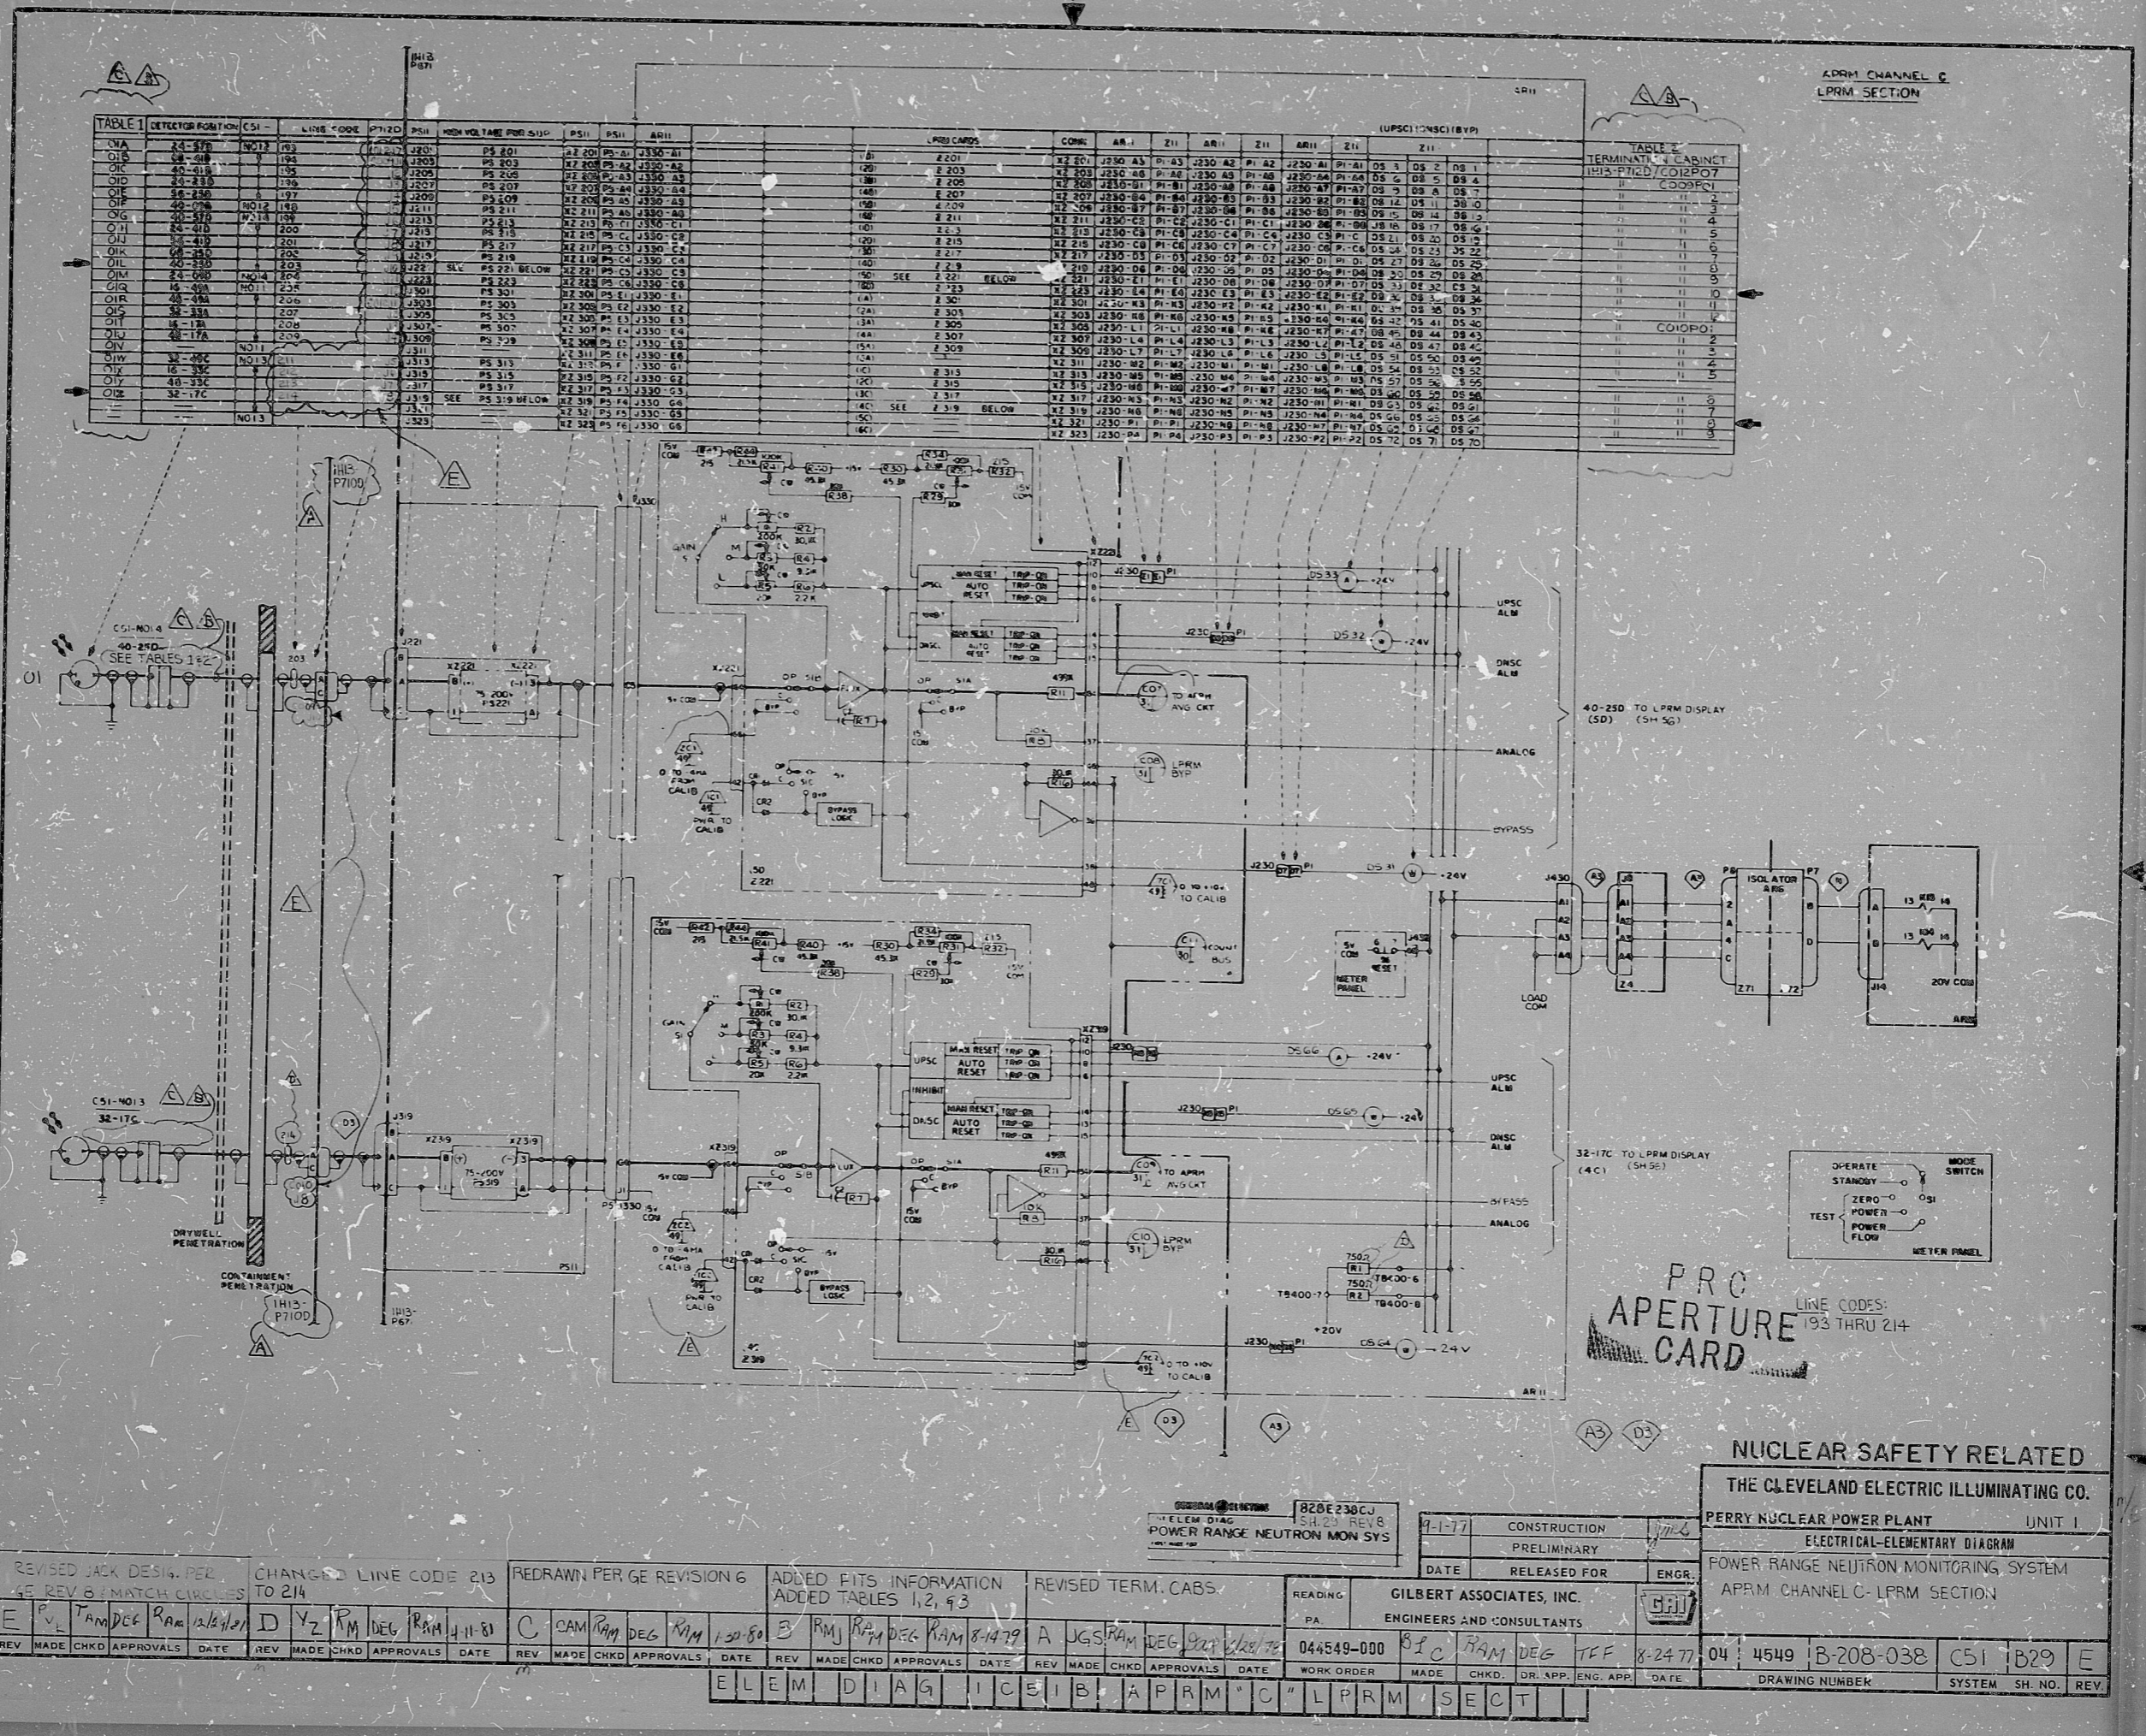


TABLE 1	DETECTOR FUNCTION	CSI	LINE CODE	PI-212	PSII	NON-VOLTAJE PWR SUPP	PSI	PSII	ABII	UPSC CARDS	COMP	AR I	ZII	ARI I	ZII	ARI I	ZII	(UPSC) NSC (BYPI)	TABLE 2	TERMINAL CABINET

NUCLEAR SAFETY RELATED

THE CLEVELAND ELECTRIC ILLUMINATING CO.

PERRY NUCLEAR POWER PLANT UNIT I


ELECTRICAL-ELEMENTARY DIAGRAM

POWER RANGE NEUTRON MONITORING SYSTEM

APRM CHANNEL C- LPRM SECTION

REVISED JACK DESIG. PER 45 REV B MATCH CIRCLES	CHANGED LINE CODE 213 TO 214	REDRAWN PER GE REVISION 6	ADDED FITS INFORMATION ADDED TABLES 1, 2, 3	REVISED TERM. CABS.	READING PA	CONSTRUCTION PRELIMINARY	DATE RELEASED FOR ENGR.
REV MADE CHKD APPROVALS DATE	REV MADE CHKD APPROVALS DATE	REV MADE CHKD APPROVALS DATE	REV MADE CHKD APPROVALS DATE	REV MADE CHKD APPROVALS DATE	044549-000	8-1-77	8-24-77
E V T AM D C G R AM 12/2/81	D Y Z R M DEG R AM 11-81	C CAM R AM DEG R AM 1-20-80	E R M R M DEG R AM 8-14-79	A J G S R AM DEG R AM 12/2/77	SI C R AM DEG T E F	04	4549 B-208-038 C51 B29 E
ELEM DIAG ICEIB APRM C LPRM SECT		DRAWING NUMBER		SYSTEM SH. NO. REV.			

PRO APERTURE CARD
LINE CODES: 193 THRU 214

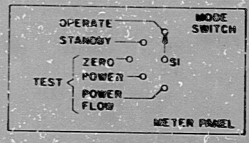

A3

D3

RIDS

8212140178

