

11

11

8.5

8.5

11

17

11


11

8.5

8.5

11

17

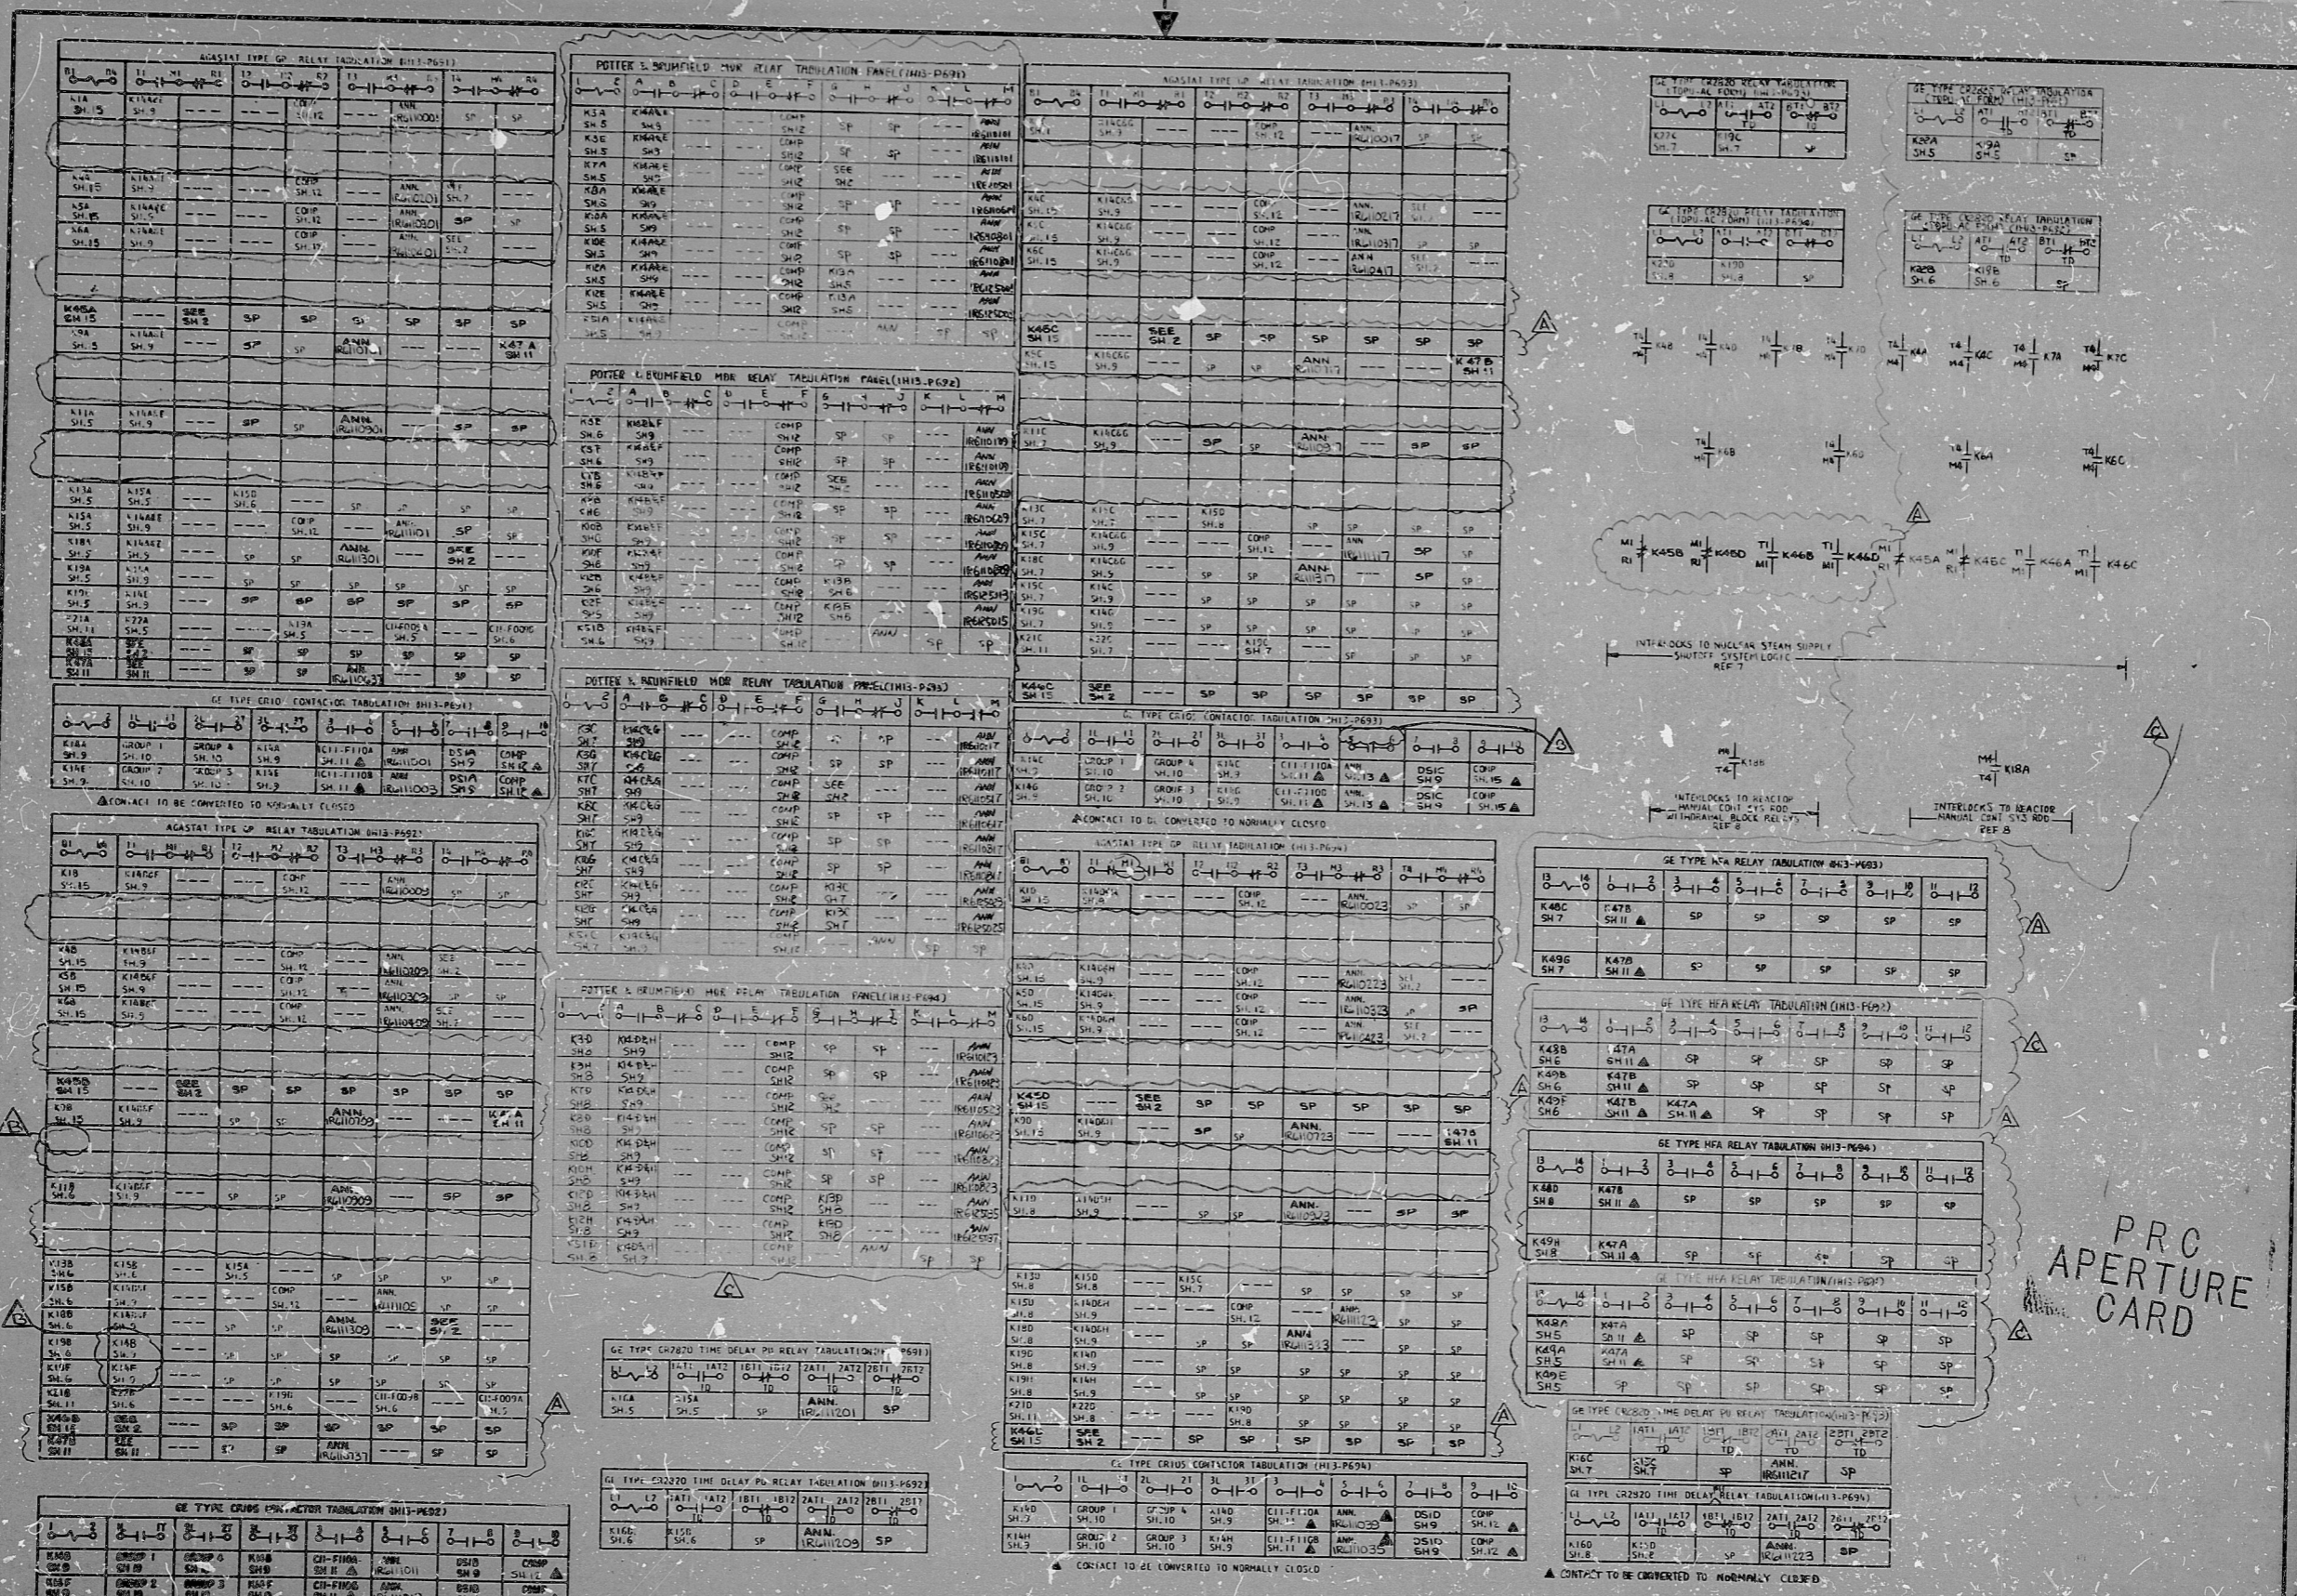

THE CLEVELAND ELECTRIC ILLUMINATING CO.
 PERRY NUCLEAR POWER PLANT UNIT 1
 ELECTRICAL-ELEMENTARY DIAGRAM
 REACTOR PROTECTION SYSTEM
 RELAY TABULATIONS

DATE: 4/30/77
 DRAWING NUMBER: 04 4549 18-208-040 C71 A02 C
 SYSTEM SH. NO. 000

RIDS

82/2140296

