

11

11

8.5"

8.5"

11"

17"

11


11

8.5"

8.5"

11"

17"

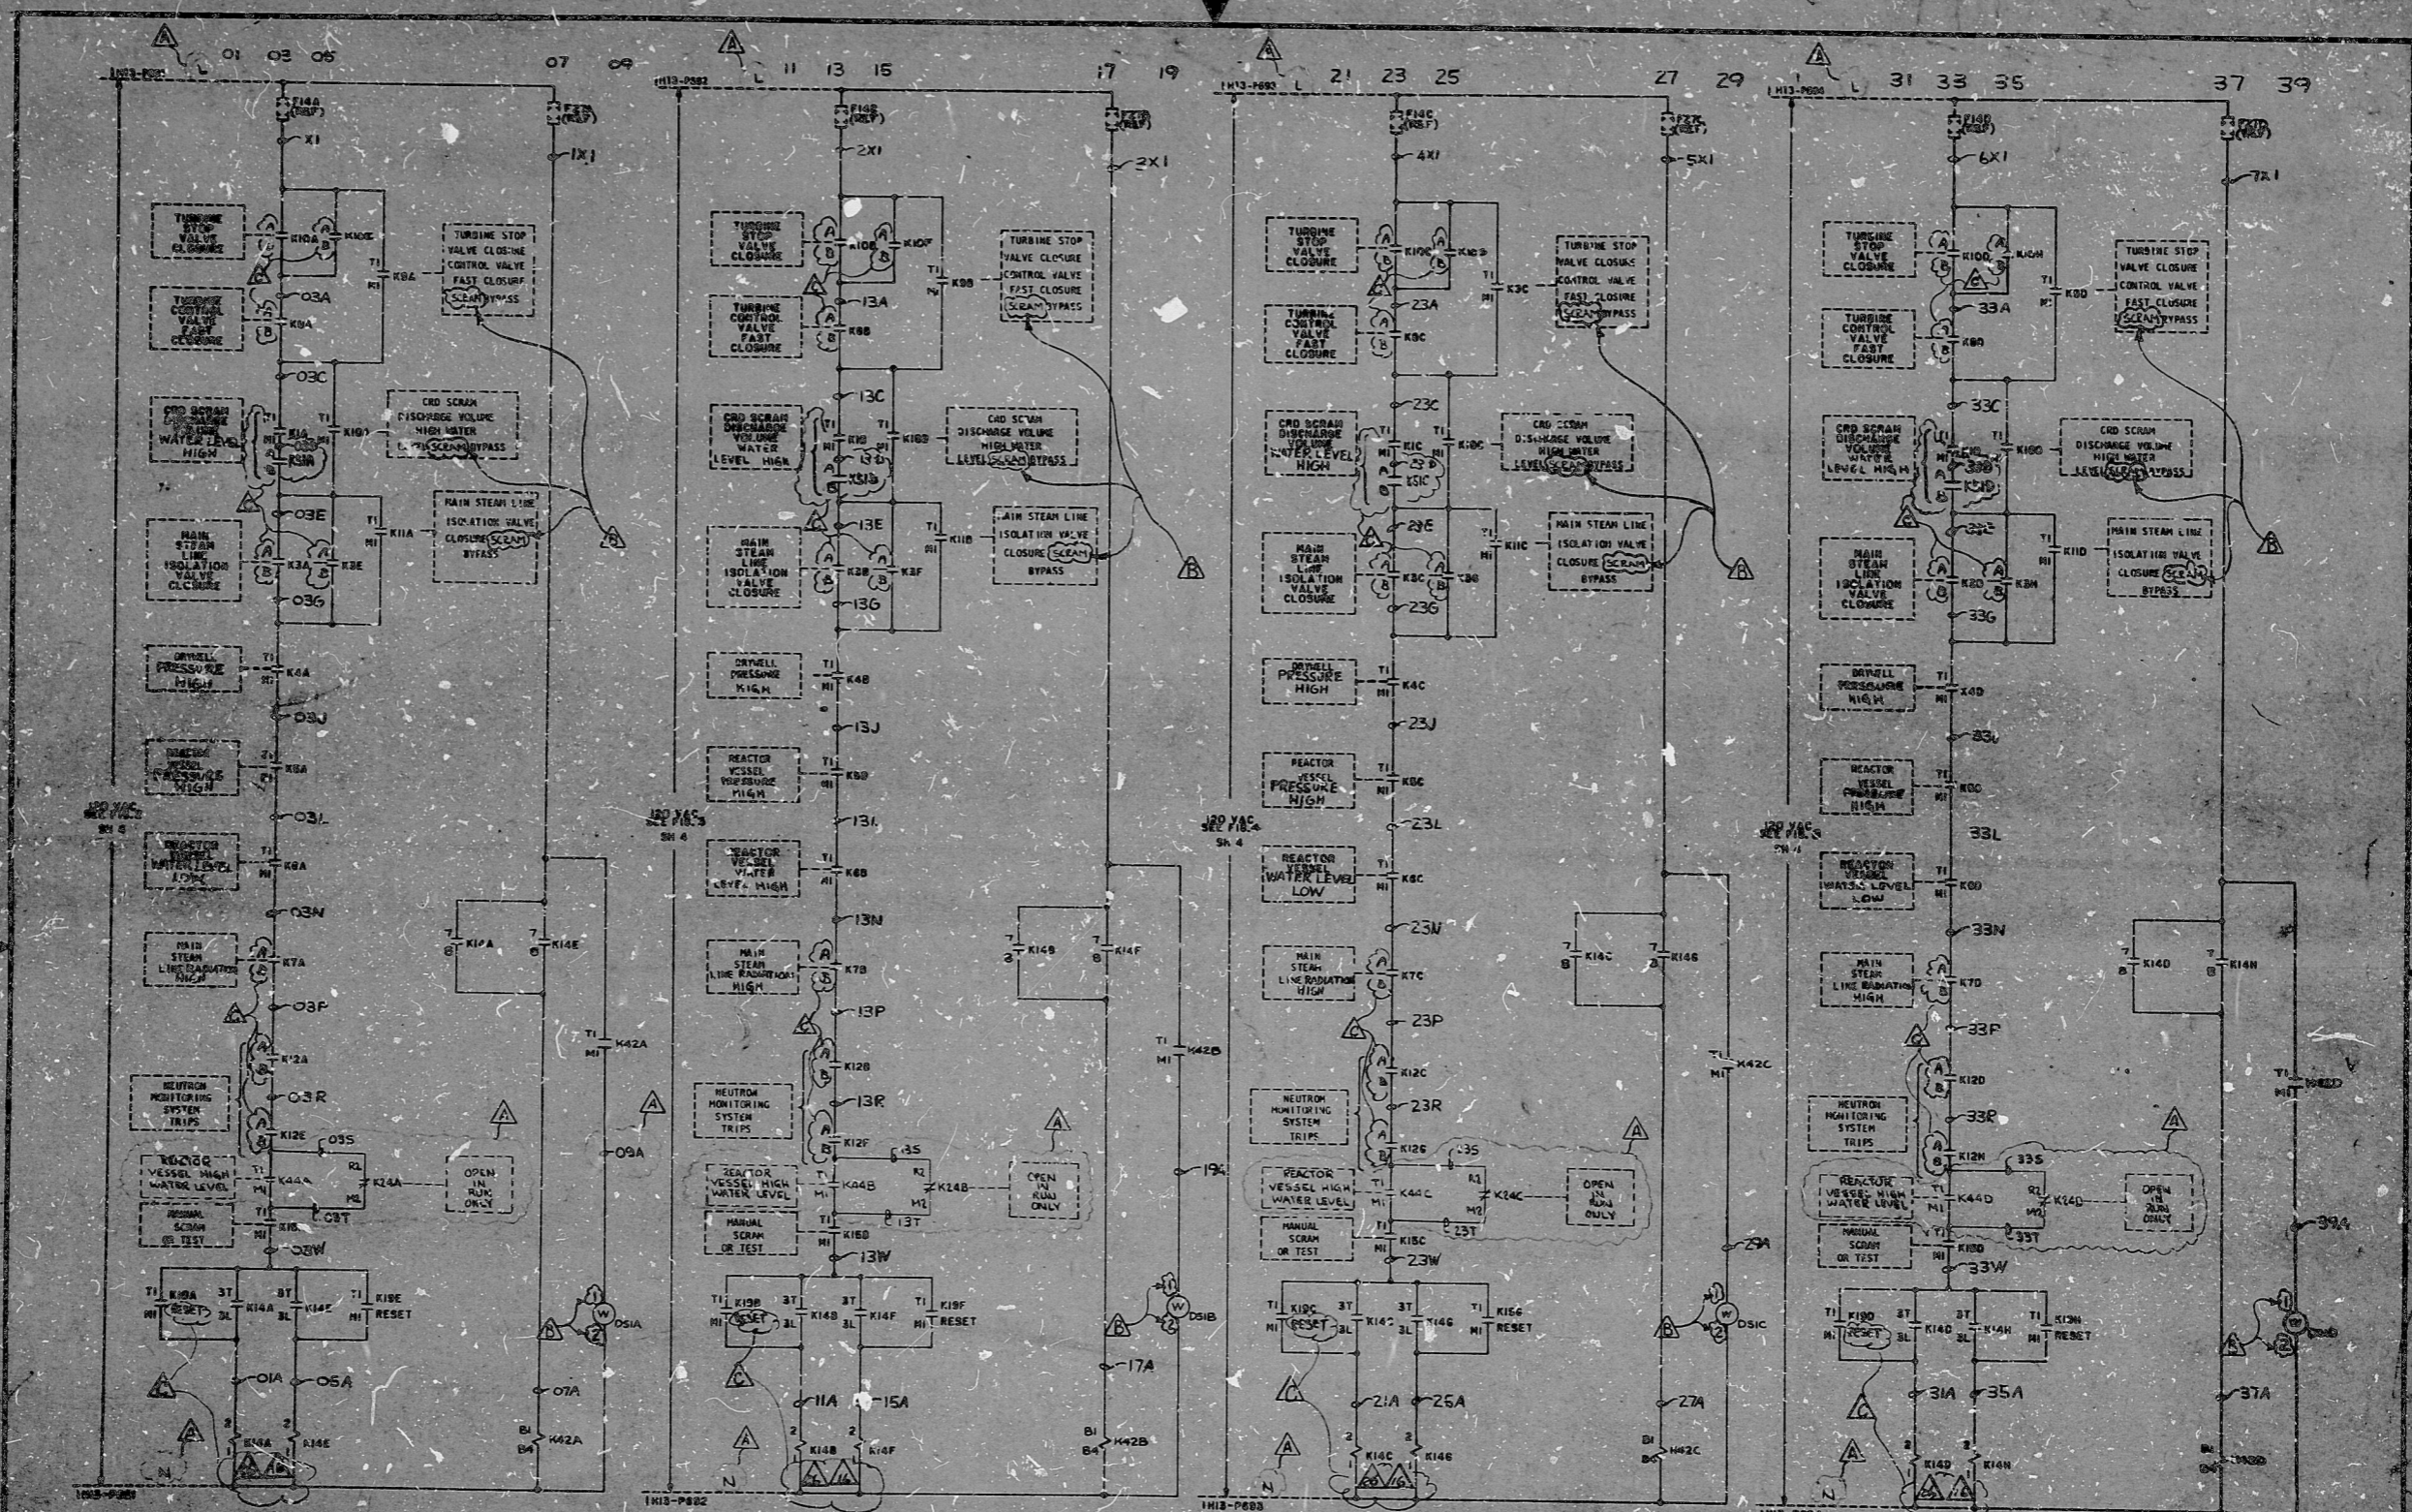

PRC  
APERTURE  
CARD

NUCLEAR SAFETY RELATED  
THE CLEVELAND ELECTRIC LUMINANCE CO.

REVISED PER GE DWS REV B, 9	REVISED LABELING PER GE REV 5	REVISED PER GE REV 1 CORRECTED WIRE MARK OSA TO DSIA CIRCUIT	DATE	CONSTRUCTION	DESIGN


RIDS

82.12140305

