


LEGEND
 LSO - LIMIT SWITCH OPENS IN FULL OPEN POSITION OF VALVE.
 LSC - LIMIT SWITCH OPENS IN FULL CLOSED POSITION OF VALVE.
 R - RED IND LIGHT (VALVE OPEN)
 G - GREEN IND LIGHT (VALVE CLOSED)

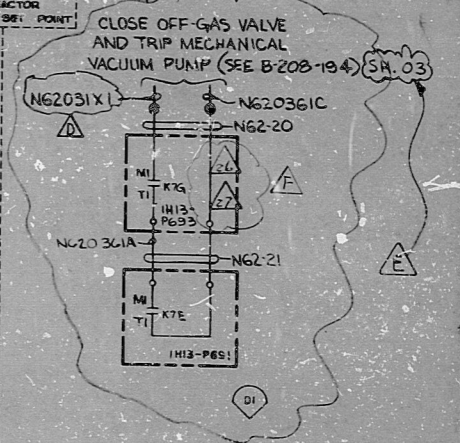

PRC APERTURE CARD

LINE CODES: 50-60,
 118, 122, 123, 130, 133, 134, 148,
 149, N62-20, N62-21,
 B35A-211, B35A-205

REVISED PER GE REV 7										REV N62031X2 TO N62031X1										REVISED PER GE REVISION 4										ADDED FITS INFORMATION ADDED TERM. CABINET										REVISED PER GE REV 2										REVISED PER GE DWS REV 20																			
ELEM DIAG										IC 71A										SZ										VLVS										RECR										TRIPS																			
REV 1										REV 2										REV 3										REV 4										REV 5										REV 6										REV 7									
DATE										DATE										DATE										DATE										DATE										DATE																			
APPROVALS										APPROVALS										APPROVALS										APPROVALS										APPROVALS										APPROVALS																			
MADE										MADE										MADE										MADE										MADE										MADE																			
CHKD										CHKD										CHKD										CHKD										CHKD										CHKD																			
DR. APP.										DR. APP.										DR. APP.										DR. APP.										DR. APP.										DR. APP.																			
ENG. APP.										ENG. APP.										ENG. APP.										ENG. APP.										ENG. APP.										ENG. APP.																			
DATE										DATE										DATE										DATE										DATE										DATE																			
04 1 4545										B-205-040										C71										A11										E																													
DRAWING NUMBER										SYSTEM										SHEET										OF										TOTAL																													

NUCLEAR SAFETY RELATED
 THE CLEVELAND ELECTRIC ILLUMINATING CO.
 PERRY NUCLEAR POWER PLANT UNIT 1
 ELECTRICAL-ELEMENTARY DIAGRAM
 REACTOR PROTECTION SYSTEM
 SCRAM DISCHARGE VOLUME ISOLATION AND
 BACKUP VALVES, RECIRCULATING PUMPS
 A AND B TRIP LOGIC

GENERAL ELECTRIC
 TITLE ELEM DIA
 REACTOR PROTECTION
 SYSTEM
 828E531CA
 S111 REV. 9
 SYSTEM

REVISED PER GE REV 7
 REV N62031X2 TO N62031X1
 REVISED PER GE REVISION 4
 ADDED FITS INFORMATION
 ADDED TERM. CABINET
 REVISED PER GE REV 2
 REVISED PER GE DWS REV 20

17"
 11"
 8.5"
 11"
 8.5"
 11"
 17"

17"
 11"
 8.5"
 11"
 8.5"
 11"
 17"

82.12140307

RIDS

