PRC APERTURE CARD

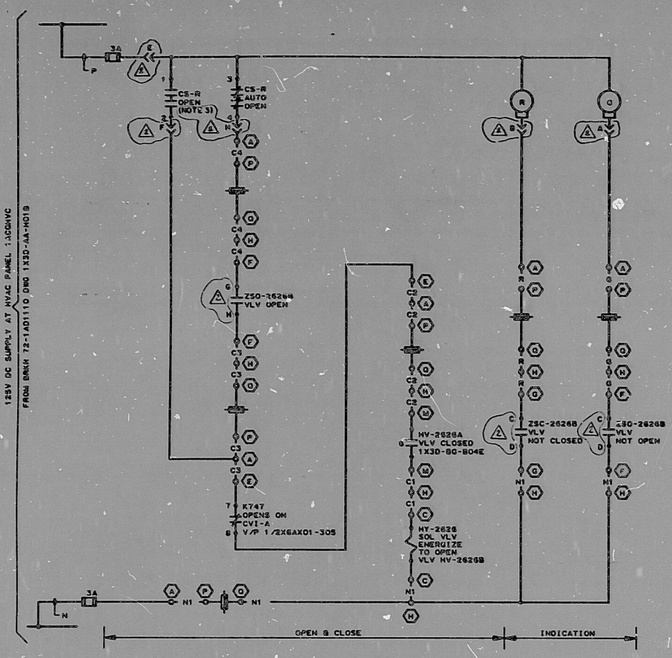

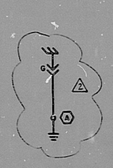

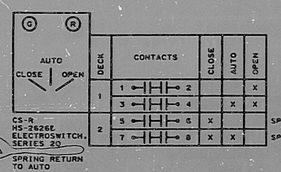

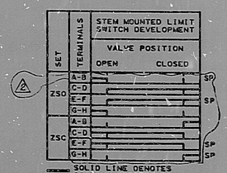

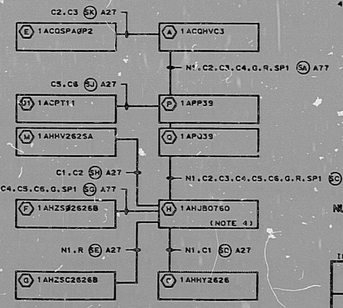

NOTES:
1. FOR SPECIAL NOTES AND SYMBOLS REFER TO O/L 1X30-AA-A00A,C,D,F THRU N.
2. ⬡ DENOTES EQUIPMENT LOCATION NUMBER FOR COMPLETE EQUIPMENT LOCATION NUMBER REFER TO CABLING BLOCK DIAGRAM.
3. TO OPEN VALVE, CONTROL SWITCH SHALL BE HELD ON OPEN POSITION UNTIL VALVE IS FULLY OPEN TO ALLOW THE CIRCUIT TO SEAL-IN THROUGH VALVE POSITION SWITCH.
4. JUNCTION BOX 1AHJB076G SHOWN ALSO ON DWG. 1X3D-BG-804E

NUCLEAR SAFETY RELATED [A]

INSIDE CTMT NORMAL PURGE ISOLATION VLV

DEVICE	MFR	TYPE	MODEL NO	REFERENCE DWGS NUMBER	DESCRIPTION	REV
				1X4DB213-4	P & I DIAGRAM	—
				N/A	ONE LINE DIAGRAM	—
				1X5DN022-1	LOGIC DIAGRAM	—
				N/A	BECHTEL V/P	—

REVISIONS	DATE	DR.	CHK.	SUPV.	EGS	CHP.E	P.E.	Q.A.E.	NO.
ADDED CONTROL NOTICE PER NCR ACCEPTANCE	8/15/84	GHD							2
REDRN. & REV. TO CONFORM WITH LOGIC DIAG. REV. 1	2/4/83	GHD	DHS						1

REVISIONS	DATE	DR.	CHK.	SUPV.	EGS	CHP.E	P.E.	Q.A.E.	NO.
ADDED 1AHJB076O & REVISED PER ECN 1-1	11/15/84	GHD	DHS						2
REVISED PER ECN 1-1	10/15/84	GHD	DHS						1

BECHTEL
LOS ANGELES

GEORGIA POWER COMPANY
ALVIN W. VOGTLE NUCLEAR PLANT

ELEMENTARY DIAGRAM
PURIFICATION & CLEAN-UP SYSTEM
1HY-2626

SCALE: NONE	DRAWING NO.	REV.
JOB NO. 7215	1X3D-BG-H059	2

ENGR. MGR. DATE

RIDS

8310040069

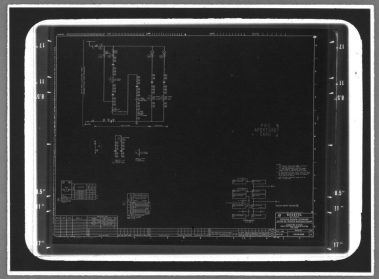

MMM 5824 — FILMSORT® Brand Aperture & Camera Cards and DUPLICARD® Brand Copy Cards — Product of 3M Company, St. Paul, Minn.