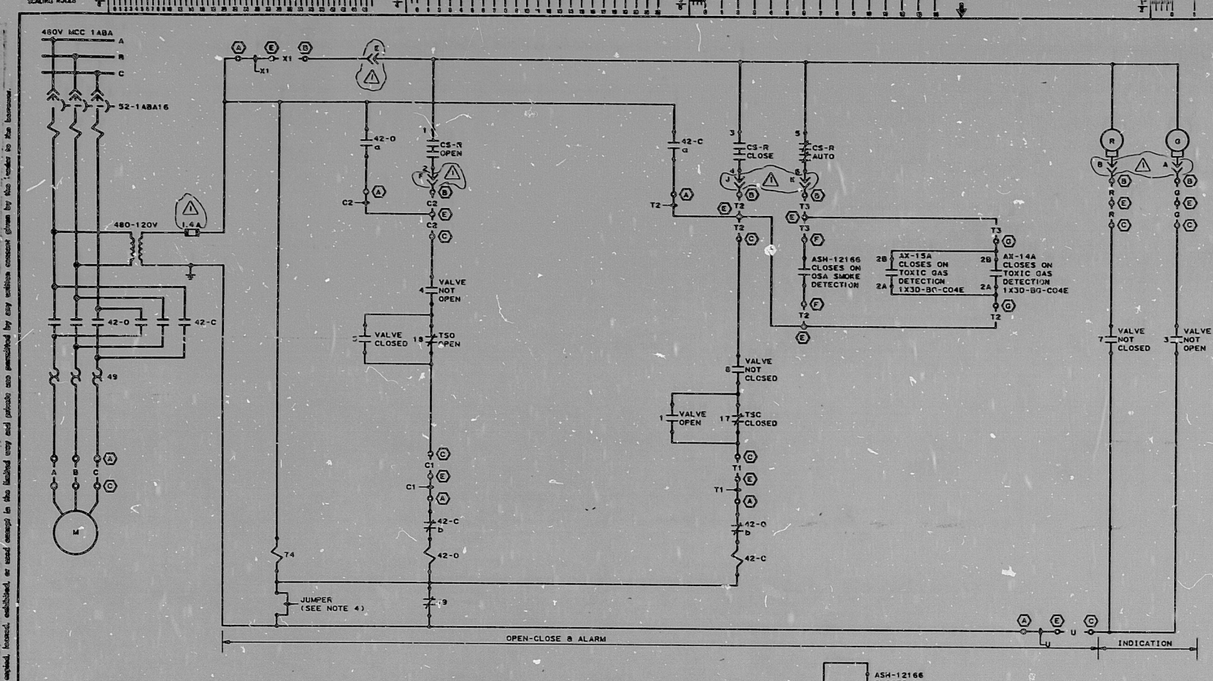

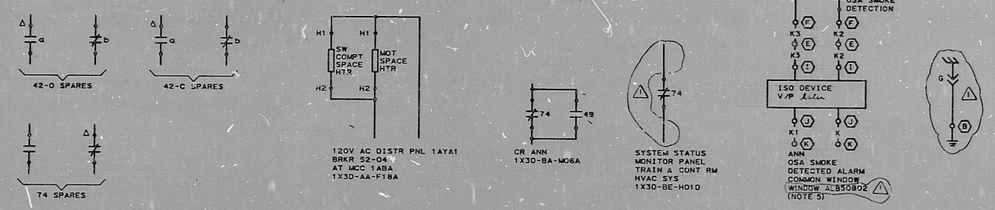

PRC APERTURE CARD

NOTES:

1. FOR SPECIAL NOTES AND SYMBOLS REFER TO O/L 1X30-AA-A00A,C,D,F THRU N.
2. ⬡ DENOTES EQUIPMENT LOCATION NUMBER. FOR COMPLETE EQUIPMENT LOCATION NUMBER REFER TO CABLING BLOCK DIAGRAM.
3. SPARE CONTACT WITH A "Δ" IS WIRED TO UNIT TERMINAL BLOCKS.
4. FIELD TO REMOVE JUMPER FROM THERMAL OVERLOAD CONTACT DURING INITIAL START-UP & PERIODIC TESTING.
5. CIRCUIT AFTER THE ISOLATION DEVICE IS CONSIDERED NON-CLASS 1E.

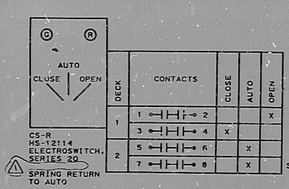

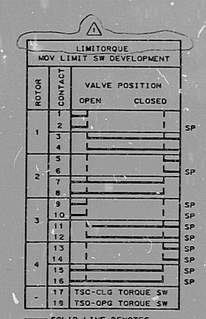

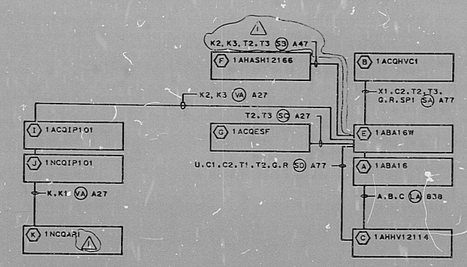

NUCLEAR SAFETY RELATED A

CR OUTSIDE AIR INTAKE ISOLATION Q

DEVICE	MFR	TYPE	MODEL NO	REFERENCE DWGS NUMBER	DESCRIPTION	REV
74	CH	D26M	D26MR13A	AX40B206-3	P & I DIAGRAM	—
				1X30-AA-F19A	ONE LINE DIAGRAM	—
				AX50N032-1	LOGIC DIAGRAM	—
				N/A	BECHTEL V/P	—

REVISIONS: 8 P&ID REV 2; 7 L/D REV 1; OIL REV 1

BECHTEL
LOS ANGELES

GEORGIA POWER COMPANY
ALVIN W. VOGTLE NUCLEAR PLANT

ELEMENTARY DIAGRAM
CR CONTROL RM HVAC SYSTEM LEVEL 1
1HV-12114

SCALE: NONE
JOB NO. 9510
DRAWING NO. 1X30-BG-C01G
REV. 1

RIDS

8310040076

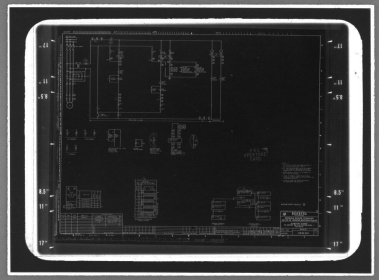

MMM 5824 — FILMSORT® Brand Aperture & Camera Cards and DUPLICARD® Brand Copy Cards — Product of 3M Company, St. Paul, Minn.