


11
8.5
8.5
11

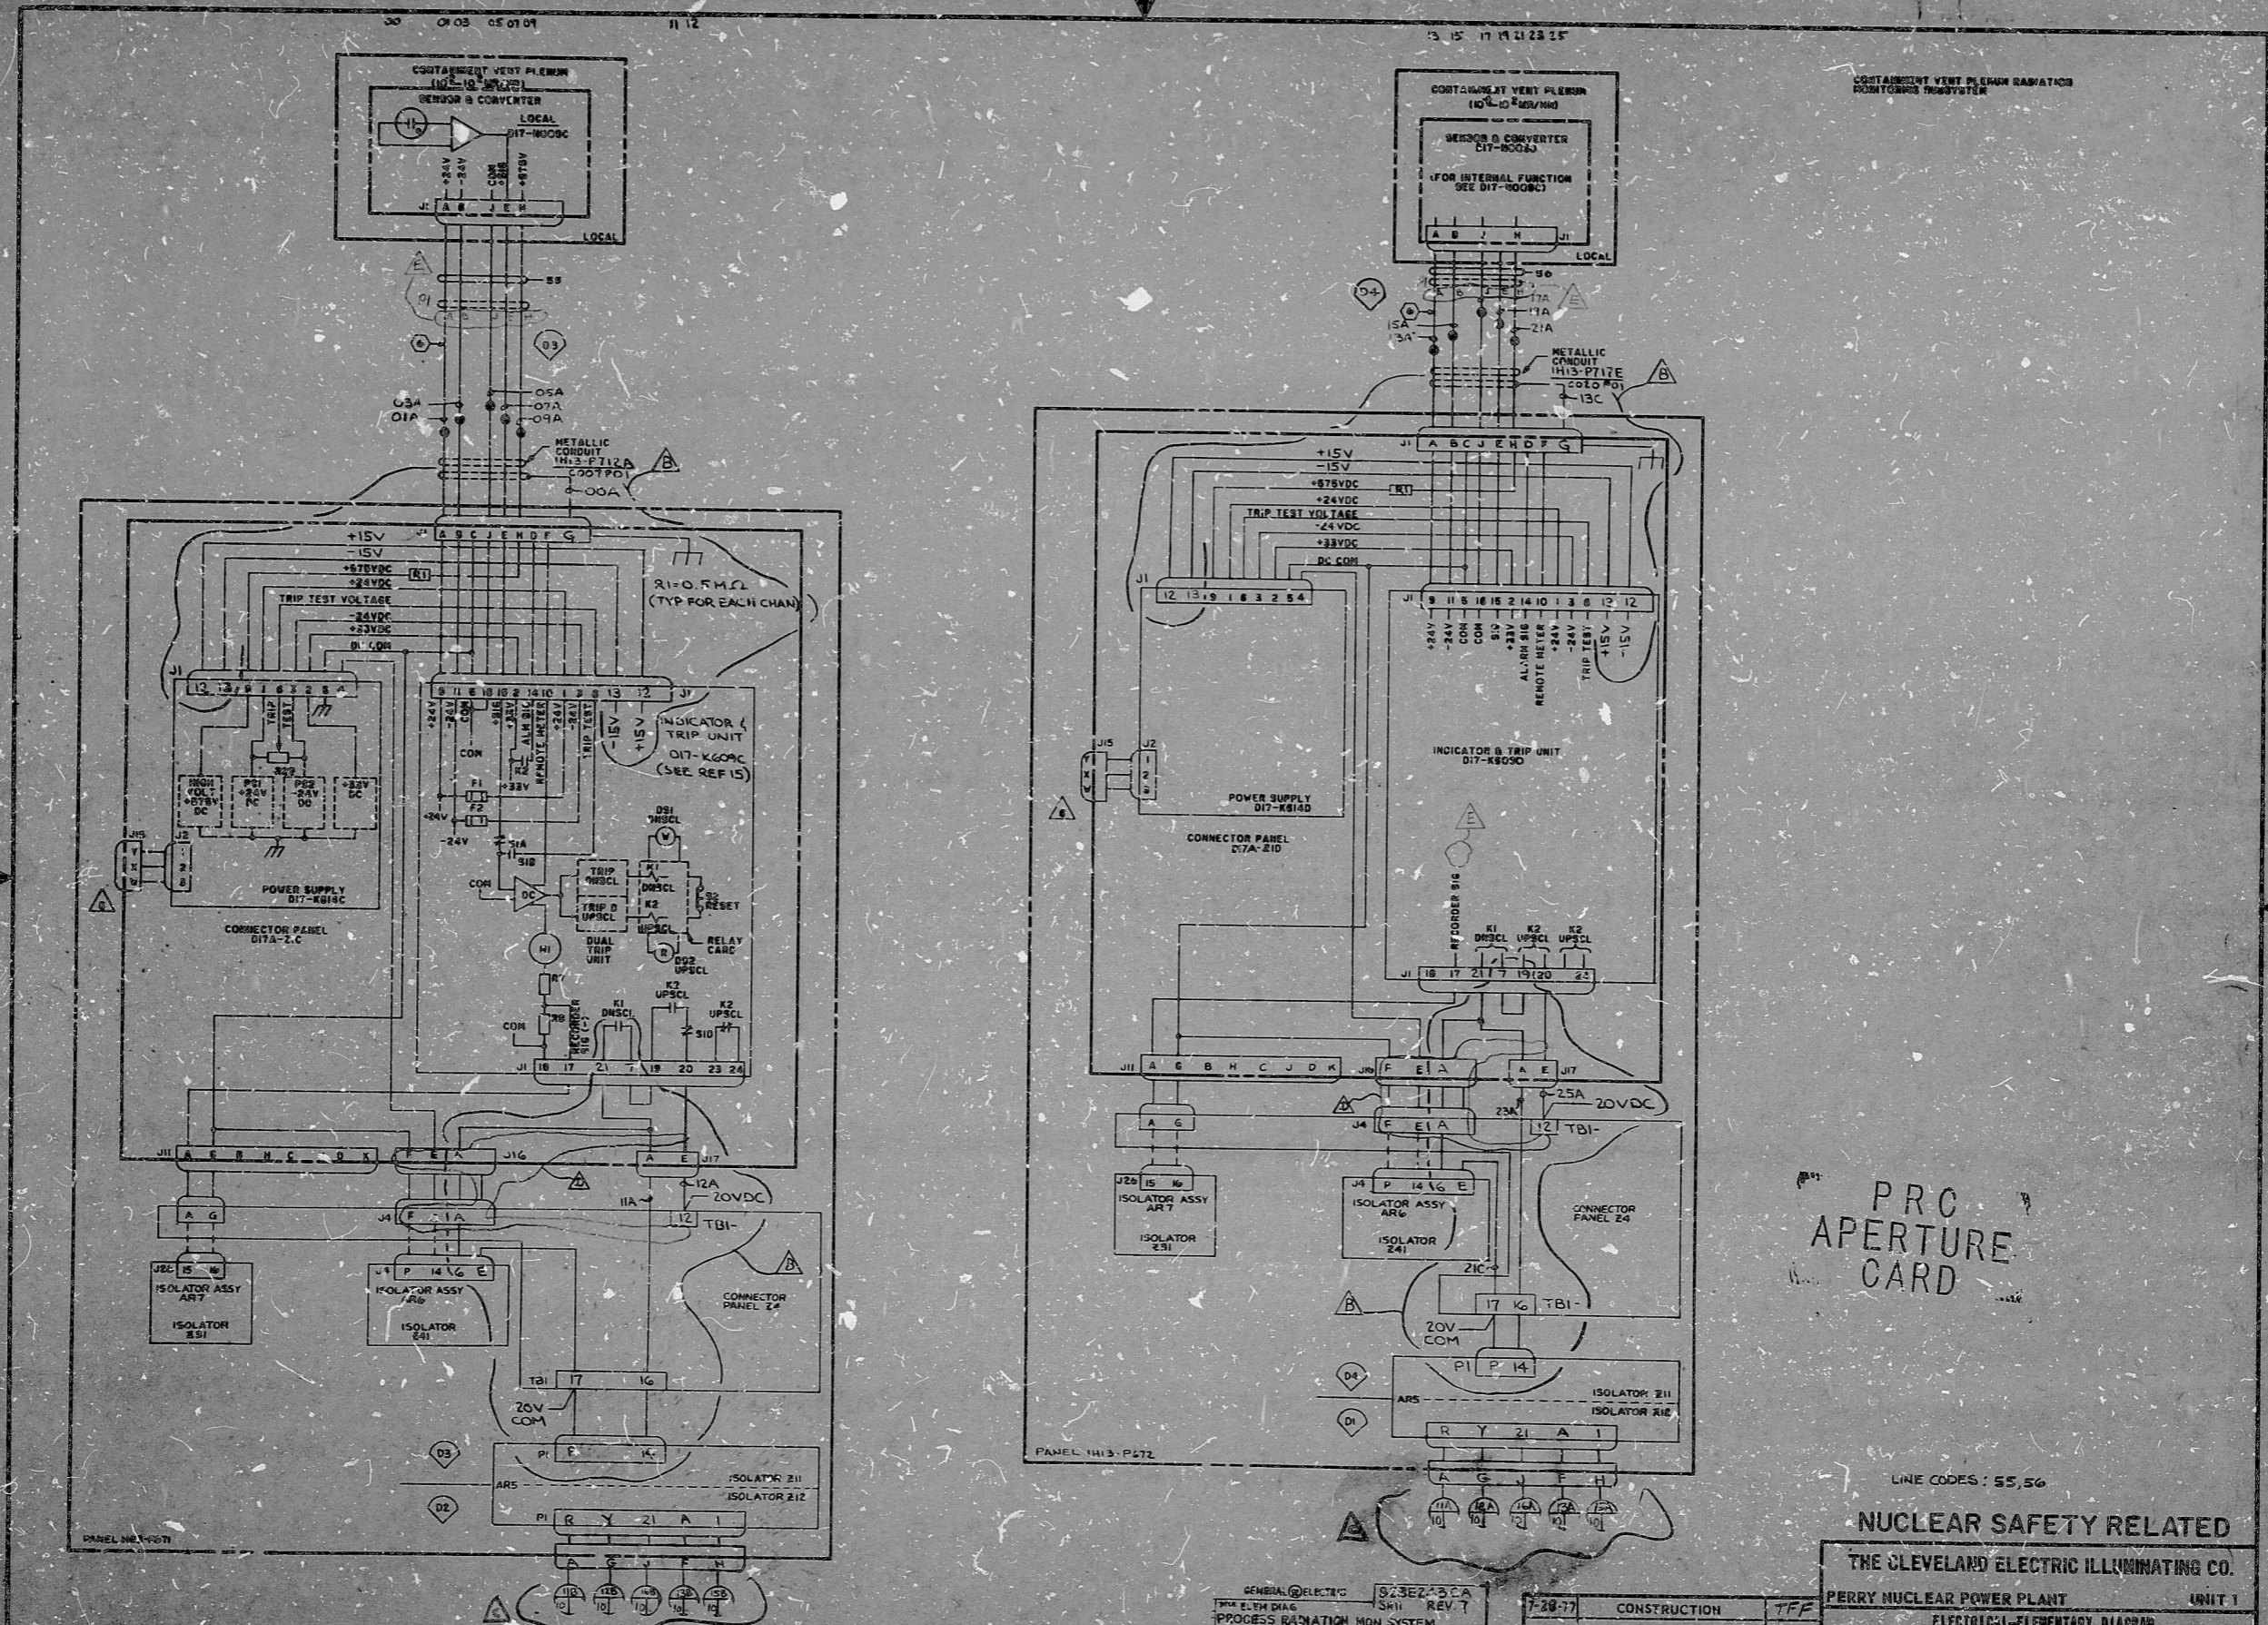

PRC APERTURE CARD

LINE CODES: 55, 56

NUCLEAR SAFETY RELATED

THE CLEVELAND ELECTRIC ILLUMINATING CO.

PERRY NUCLEAR POWER PLANT UNIT 1

ELECTRICAL-ELEMENTARY DIAGRAM

PROCESS RADIATION MONITORING SYSTEM

CONTAINMENT VENT PLENUM (ANALOG SECTION)

ADDED FITS INFORMATION	DELETED WIRE BETWEEN J15 J17, J41 TO 12 CHANGED PLUG DESIGNATION	REVISED PER GE REV. 4	REVISED CIRCUITRY PER GE REV. 23 ADDED FITS INFO.	REDRAWN PER GE REV. 1	READING PA	GILBERT ASSOCIATES, INC. ENGINEERS AND CONSULTANTS	DATE 7-28-77	CONSTRUCTION TFF	PRELIMINARY	RELEASED FOR ENGR.						
EY	AW	D	Z	M	PA	044549-000	WW	RAM	DAG	TFF	7-28-77	04	4549	10-200-034	D17	111E
ELEM DIAG 1017A CONTNMT VENT PLENUM																

11
8.5
8.5
11
8.5
11
17

82.2140352

RIDS

