


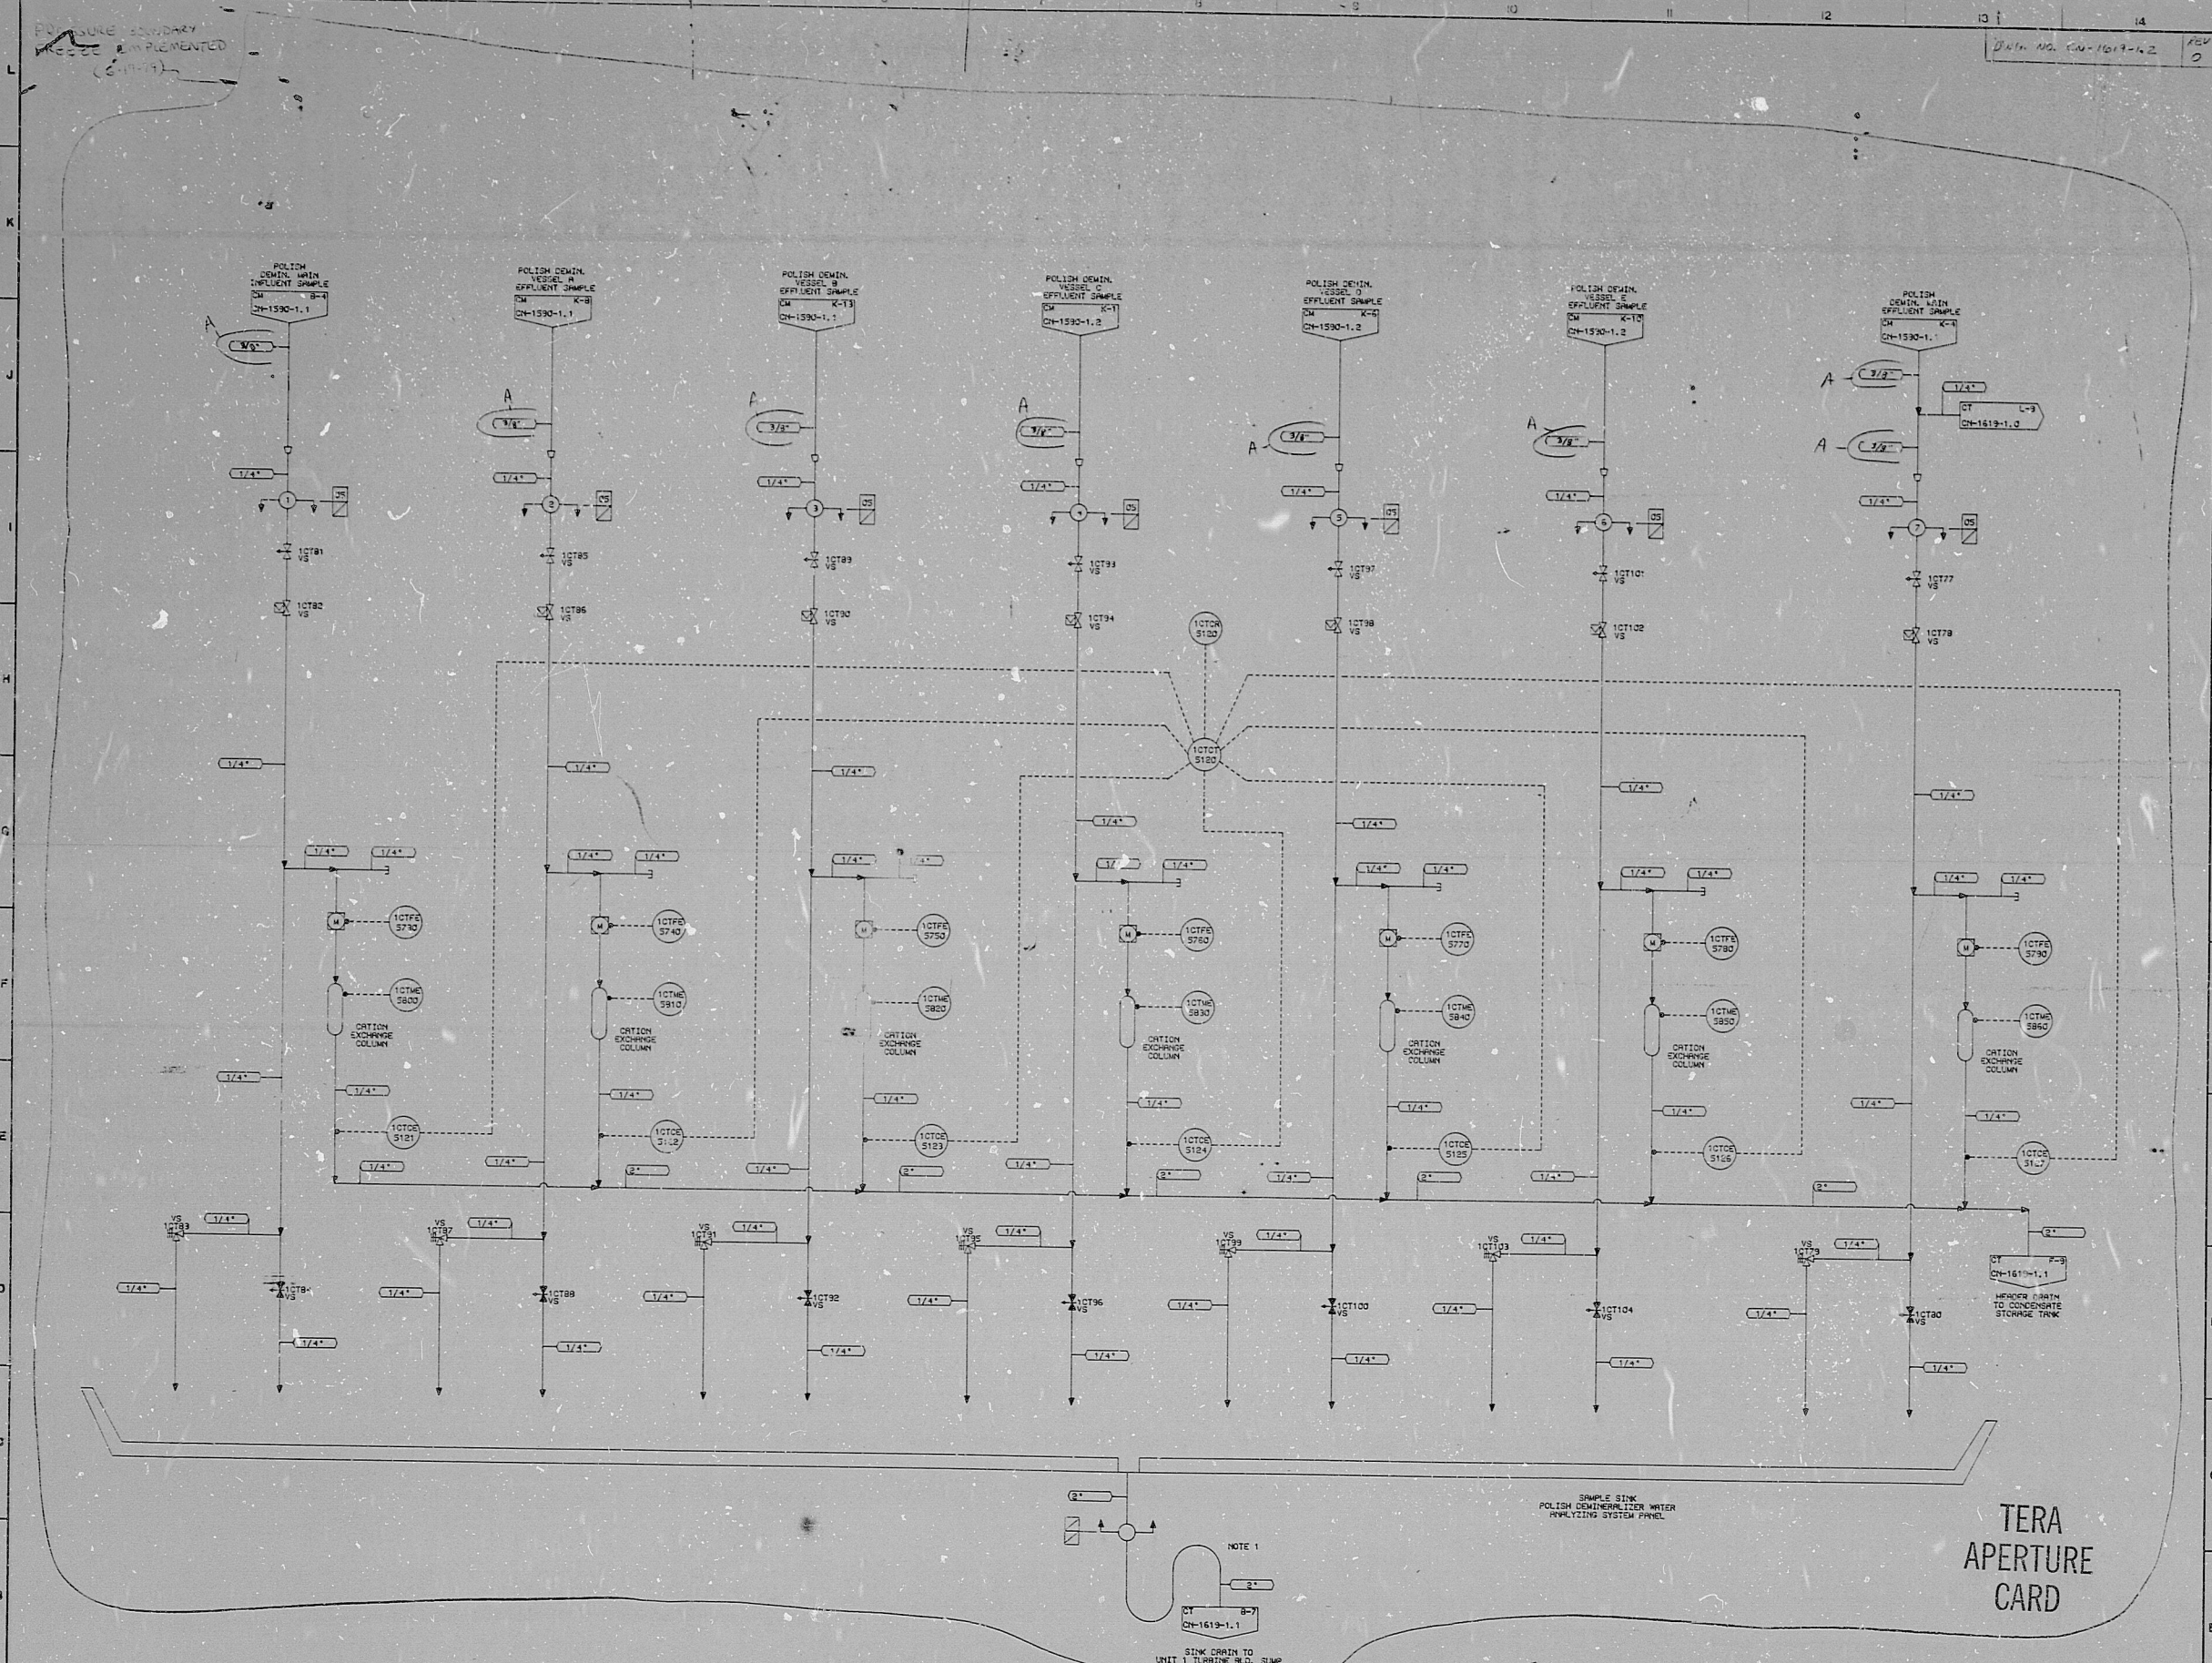

NOTES:
1. GRAVITY DRAIN ALL PIPING MUST BE BELOW THE SINK DRAIN.

DESIGN PARAMETERS					
LINE NUMBER	DESIGN	PRESSURE	TEMPERATURE	CLASS	WATER/IN
05	2701.4	735 PSIA	180°F	H	BT

3-1 CLEANED FOR PRESSURE BOUNDARY TESTING - 2011 (C002-1-11-74)

SYSTEM CHANGE ORDER NUMBER CN-1619-1.2-C002	
DATE	REVISION
11/19/74	1
11/19/74	2
DUKE POWER COMPANY	
FLOW DIAGRAM OF CONVENTIONAL SAMPLING SYSTEM C02	
DATE	REVISION
11/19/74	1
11/19/74	2
9.3.2-8

RIDS-PDR

8107010192

