


- NOTES**
1. IH13-P713B TERMINATION CABINET
LINE CODE 42
 2. IH13-P710A TERMINATION CABINET
LINE CODE 44
 3. IH13-P710E TERMINATION CABINET
LINE CODE 57
LINE CODE 59, 60, 323, 324 - TM056
LINE CODE 63
 4. IH13-P702B TERMINATION CABINET
LINE CODE 58
LINE CODE 61, 62, 325, 326 - TM027
LINE CODE 64

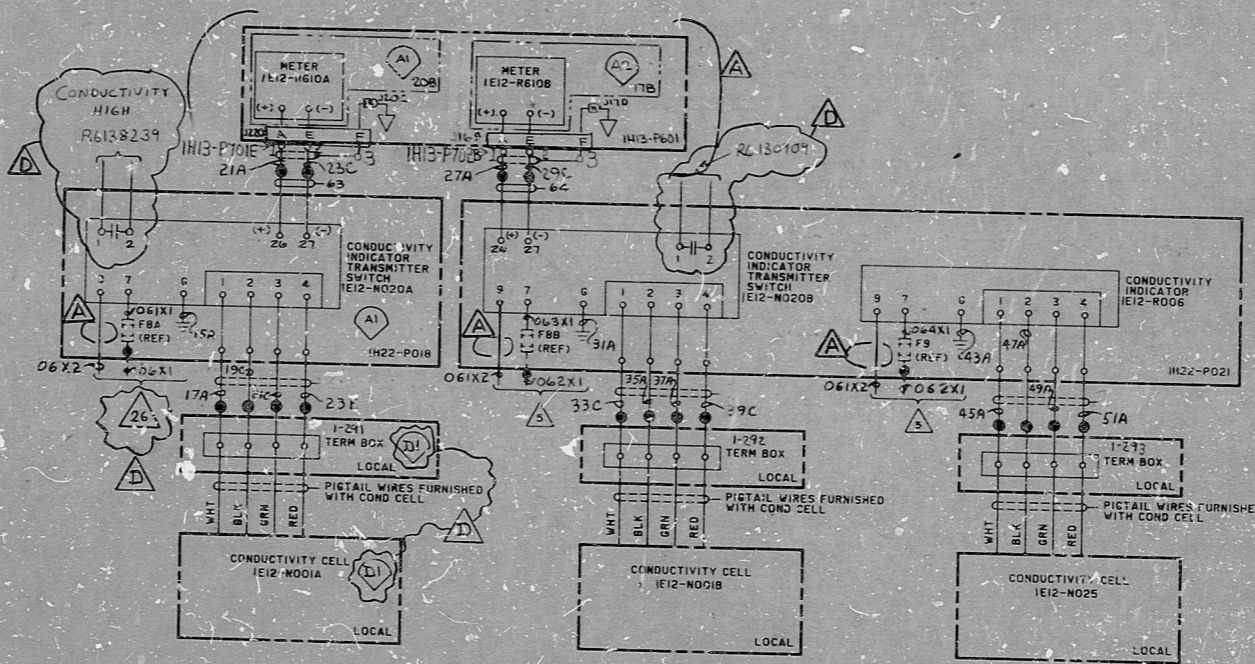

GENERAL ELECTRIC 828E534CA
ELEN JAC SH. 10 REV. 6
RESIDUAL HEAT REMOVAL SYSTEM

PROC APERTURE CARD

NUCLEAR SAFETY RELATED

THE CLEVELAND ELECTRIC ILLUMINATING CO.

PERRY NUCLEAR POWER PLANT UNIT 1

ELECTRICAL-ELEMENTARY DIAGRAM

RESIDUAL HEAT REMOVAL SYSTEM
PROCESS INSTRUMENTATION

LINE CODES: 42, 44, 54, 56, 64, 323, 324, 325, 326, 370, 373

12/21/77 CONSTRUCTION TFF
PRELIMINARY
DATE RELEASED FOR ENGR.

GILBERT ASSOCIATES, INC.
ENGINEERS AND CONSULTANTS

READING PA
G44549-000
WORK ORDER

MADE CHKD. DE. APP. ENG. APP. DATE

ADDED R61 CONTACTS; ADDED VALVE LOCATIONS; ADDED AND AS PER GE DRAWING REV 6

ADDED VALVES F451A, F451B, REV PER GE REV. 4, ADDED J7

ADDED FITS INFORMATION. CHANGED TERM. CAB. ADDED

REV	MADE	CHKD	APPROVALS	DATE
D	JG	TAM	DEC 11 1977	11/18/77
C	CJS	RAM	DEC 11 1977	11/18/77
B	RAM	DEC 11 1977	11/18/77	11/18/77
A	RAM	DEC 11 1977	11/18/77	11/18/77


04	4549	B-208-055	E12	A11	D
----	------	-----------	-----	-----	---

04	4549	B-208-055	E12	A11	D
----	------	-----------	-----	-----	---

ELEM DIAG. IE12 PROCESS INSTRUMENT

KB17 02173

11

11

8.5

8.5

11

17

11

11

8.5

8.5

11

17

RIDS

8212140488

