


PRC APERTURE CARD

REF. B-21-255 SH. 47-50  
ALL WIRING IS D1 UNLESS OTHERWISE INDICATED

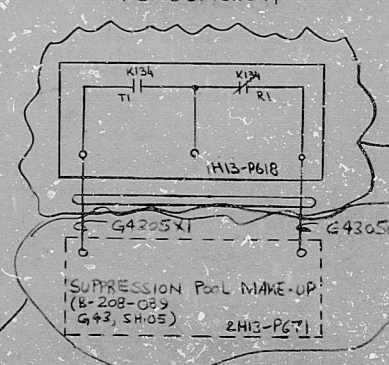

GENERAL COLLECTIONS 02853404  
THE CECHE DASH SHC(3) REV. 3  
RESIDUAL HEAT REMOVAL SYSTEM

**NUCLEAR SAFETY RELATED**

THE CLEVELAND ELECTRIC ILLUMINATING CO.  
ERRY NUCLEAR POWER PLANT UNIT 1  
ELECTRICAL-ELEMENTARY DIAGRAM

RESIDUAL HEAT REMOVAL SYSTEM  
MCC POWER LOSS

DATE	RELEASED FOR	ENGR.
6/30/77	CONSTRUCTION	TFP
	PRELIMINARY	

GILBERT ASSOCIATES, INC.  
ENGINEERS AND CONSULTANTS

ADDED REF WIREMARK TO SUPPR. POOL MAKE-UP	CHANGED VALVE LOCATION; ADDED REF CHANGE OF STATUS AS PER GE DWG. 21-255 SH. 47-50	REMOVED HWD	ADDED FITS INFO	ADDED RELAY IDENT. AND RHR C NOTE, REV. 2H13	READING PA	040348-000	6/30/77	04	4549	B-208-055	E12	AS2	E														
ARR	TAM	AB	REDA	9/6/82	D	J2	TAM	DEC	PAV	1/15/82	C	Y2	RA	DEG	RAV	2-11-81	B	RAV	DBS	RAV	5/27/77	A	WU	RAV	DEG	PAV	1/21/76
CHKD	APPROVALS	DATE	REV	MADE	CHKD	APPROVALS	DATE	REV	MADE	CHKD	APPROVALS	DATE	REV	MADE	CHKD	APPROVALS	DATE	REV	MADE	CHKD	APPROVALS	DATE	REV	MADE	CHKD	APPROVALS	DATE

ELEM DIAGS I E12 MCC POWER LOSS

64  
64  
5.8  
8.5"  
11"  
17"

64  
64  
5.8  
8.5"  
11"  
17"



RIDS

8212140489

