



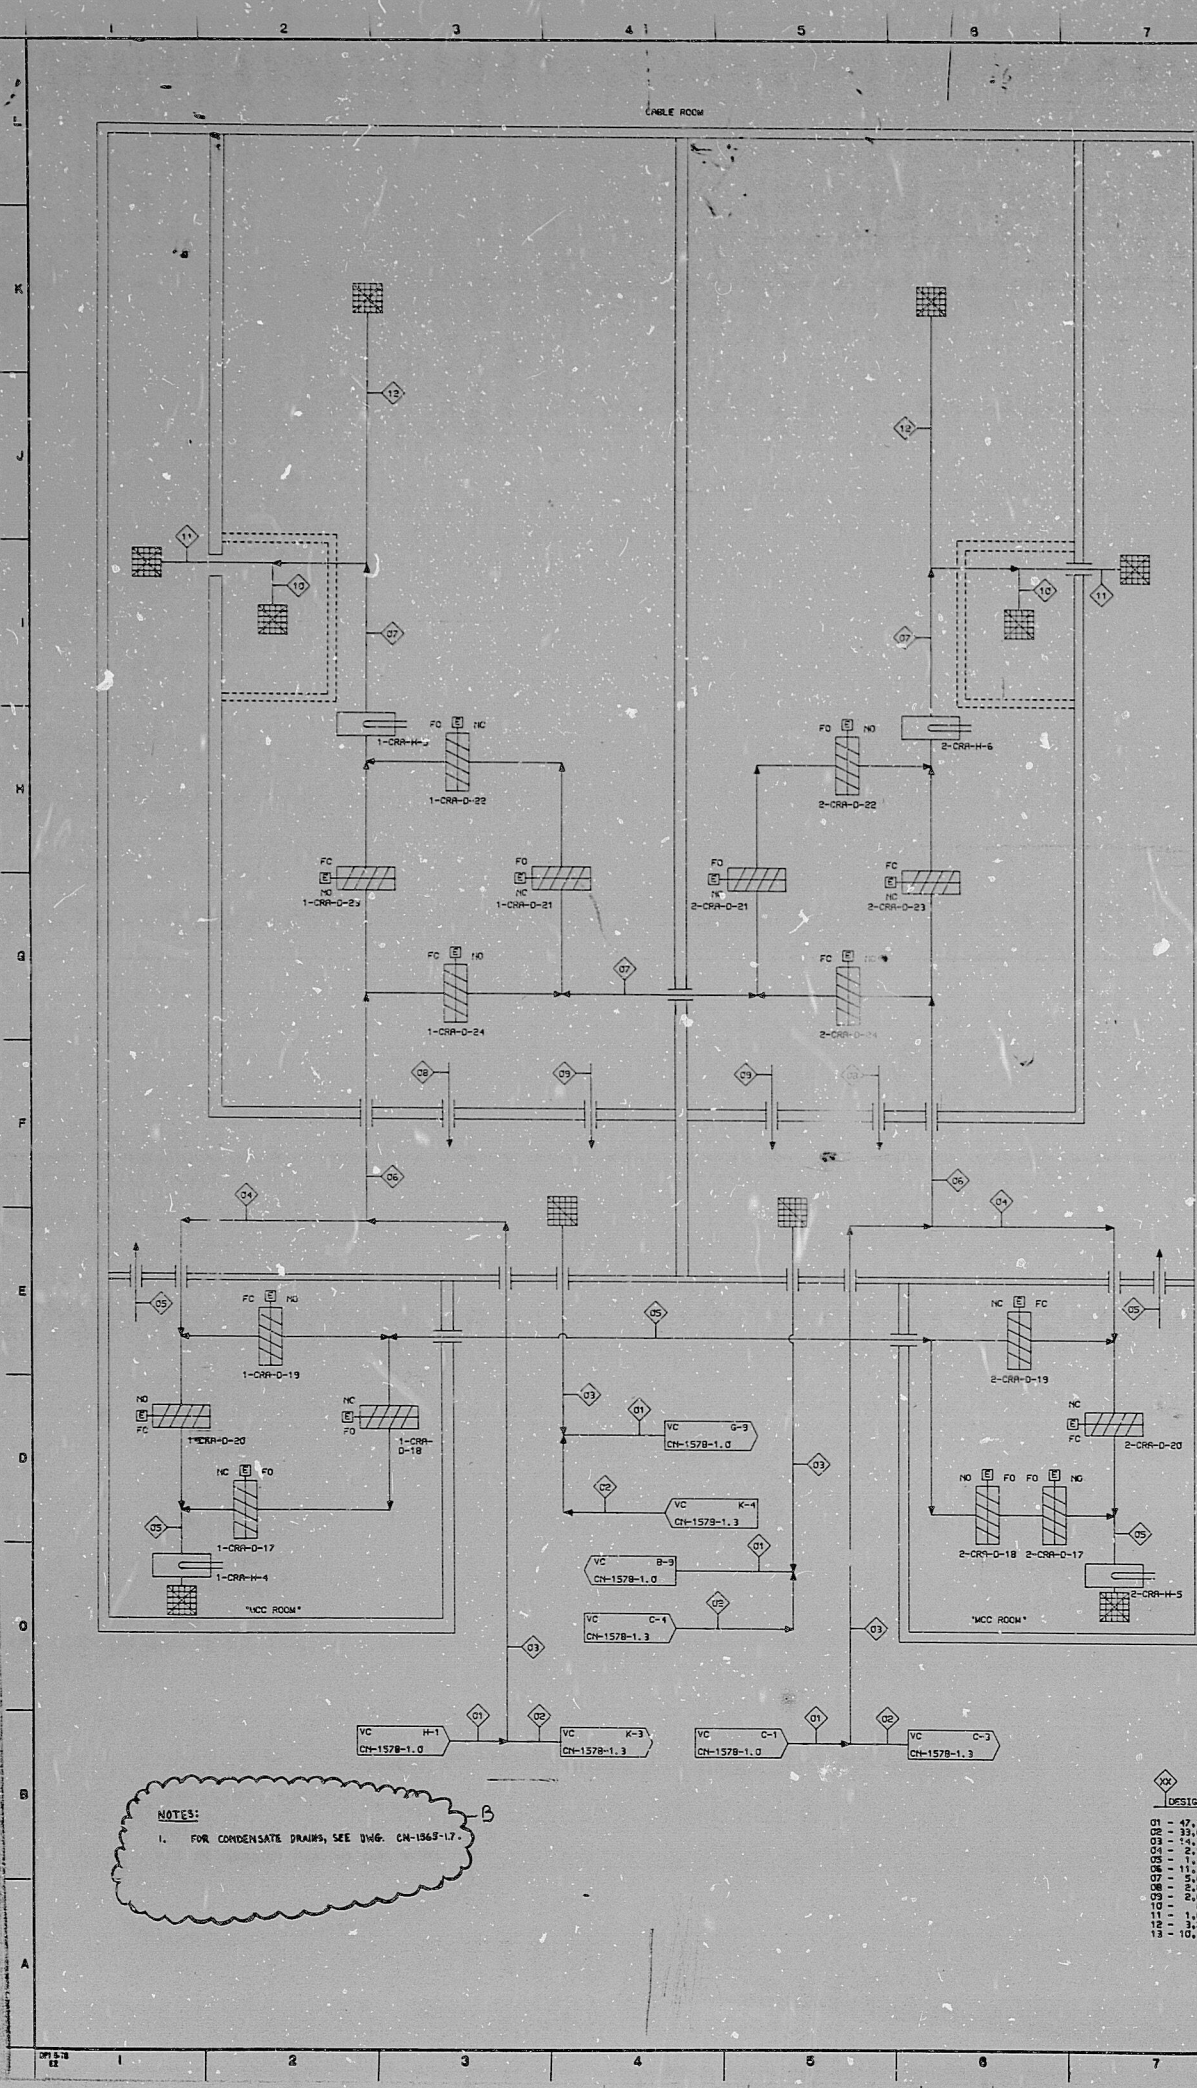

NOTES:
1. FOR CONDENSATE DRAINS, SEE DWG. CN-1563-17.

DESIGN FLOW

1	47,370 CFM
2	33,560 CFM
3	14,310 CFM
4	2,860 CFM
5	1,430 CFM
6	11,250 CFM
7	5,625 CFM
8	2,812 CFM

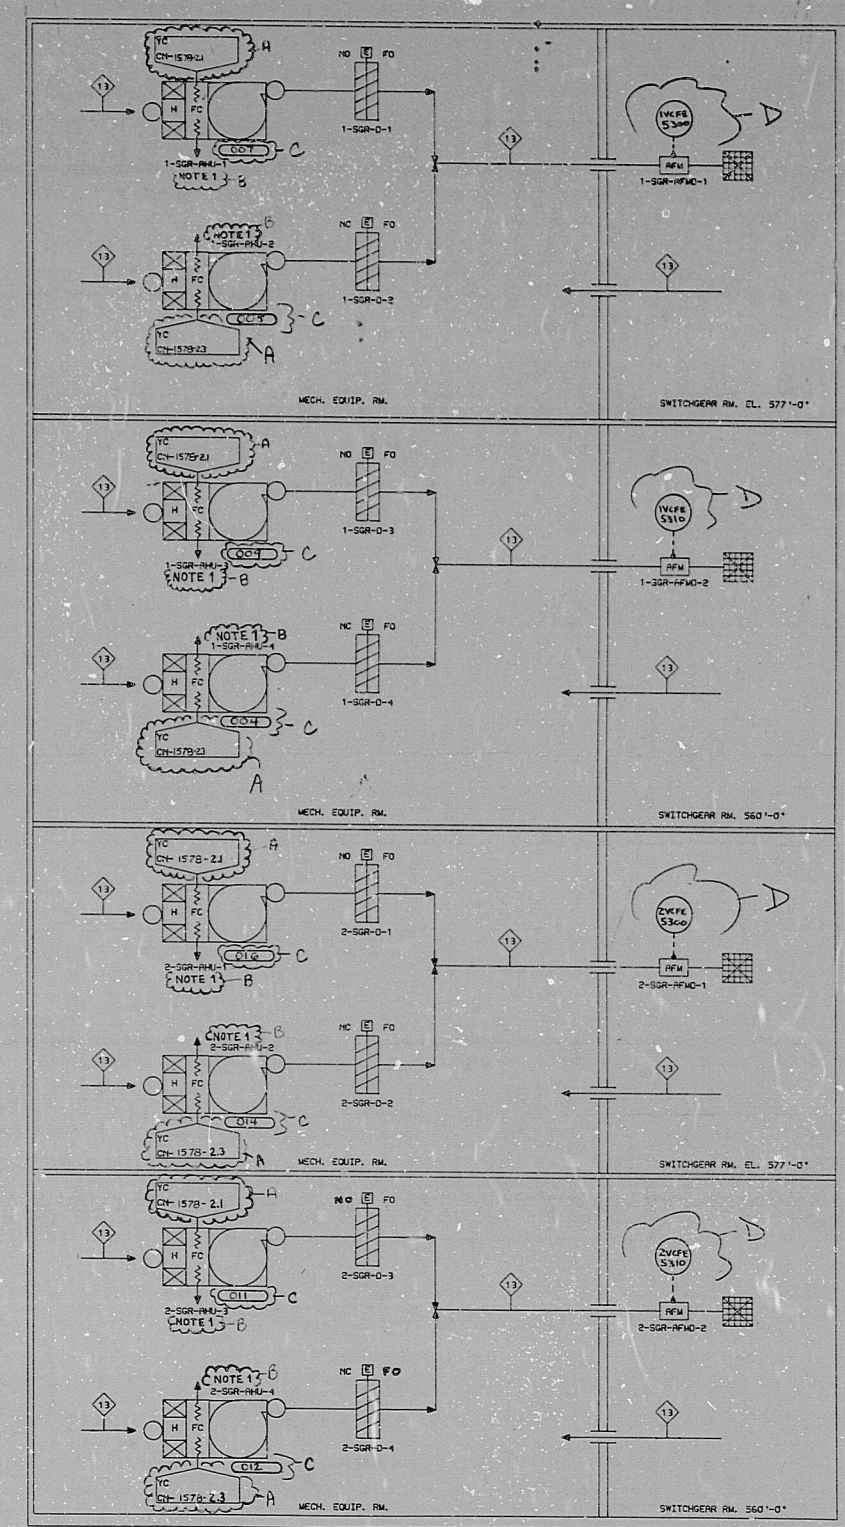

TERA
APERTURE
CARD

STATION SERVICES CHANGE ORDER 1572-1.2-01		NUCLEAR SAFETY RELATED	
REVISIONS: 1. REVISE FOR STATION SERVICES CHANGE ORDER 1572-1.2-01 2. REVISE TO ADD EQUIPMENT AND DUCTWORK 3. REVISE TO ADD EQUIPMENT AND DUCTWORK		DUKES POWER COMPANY CATHAMER NUCLEAR STATION UNIT 102 FLOW DIAGRAM OF CONTROL ROOM AREA VENTILATION SYSTEM (VCC)	
DESIGNER: [Signature] CHECKER: [Signature] APPROVED: [Signature]		DWG. NO. CN-1578-1.2 SCALE: 1/8" = 1'-0"	

RIDS-PDR

8107010239

