


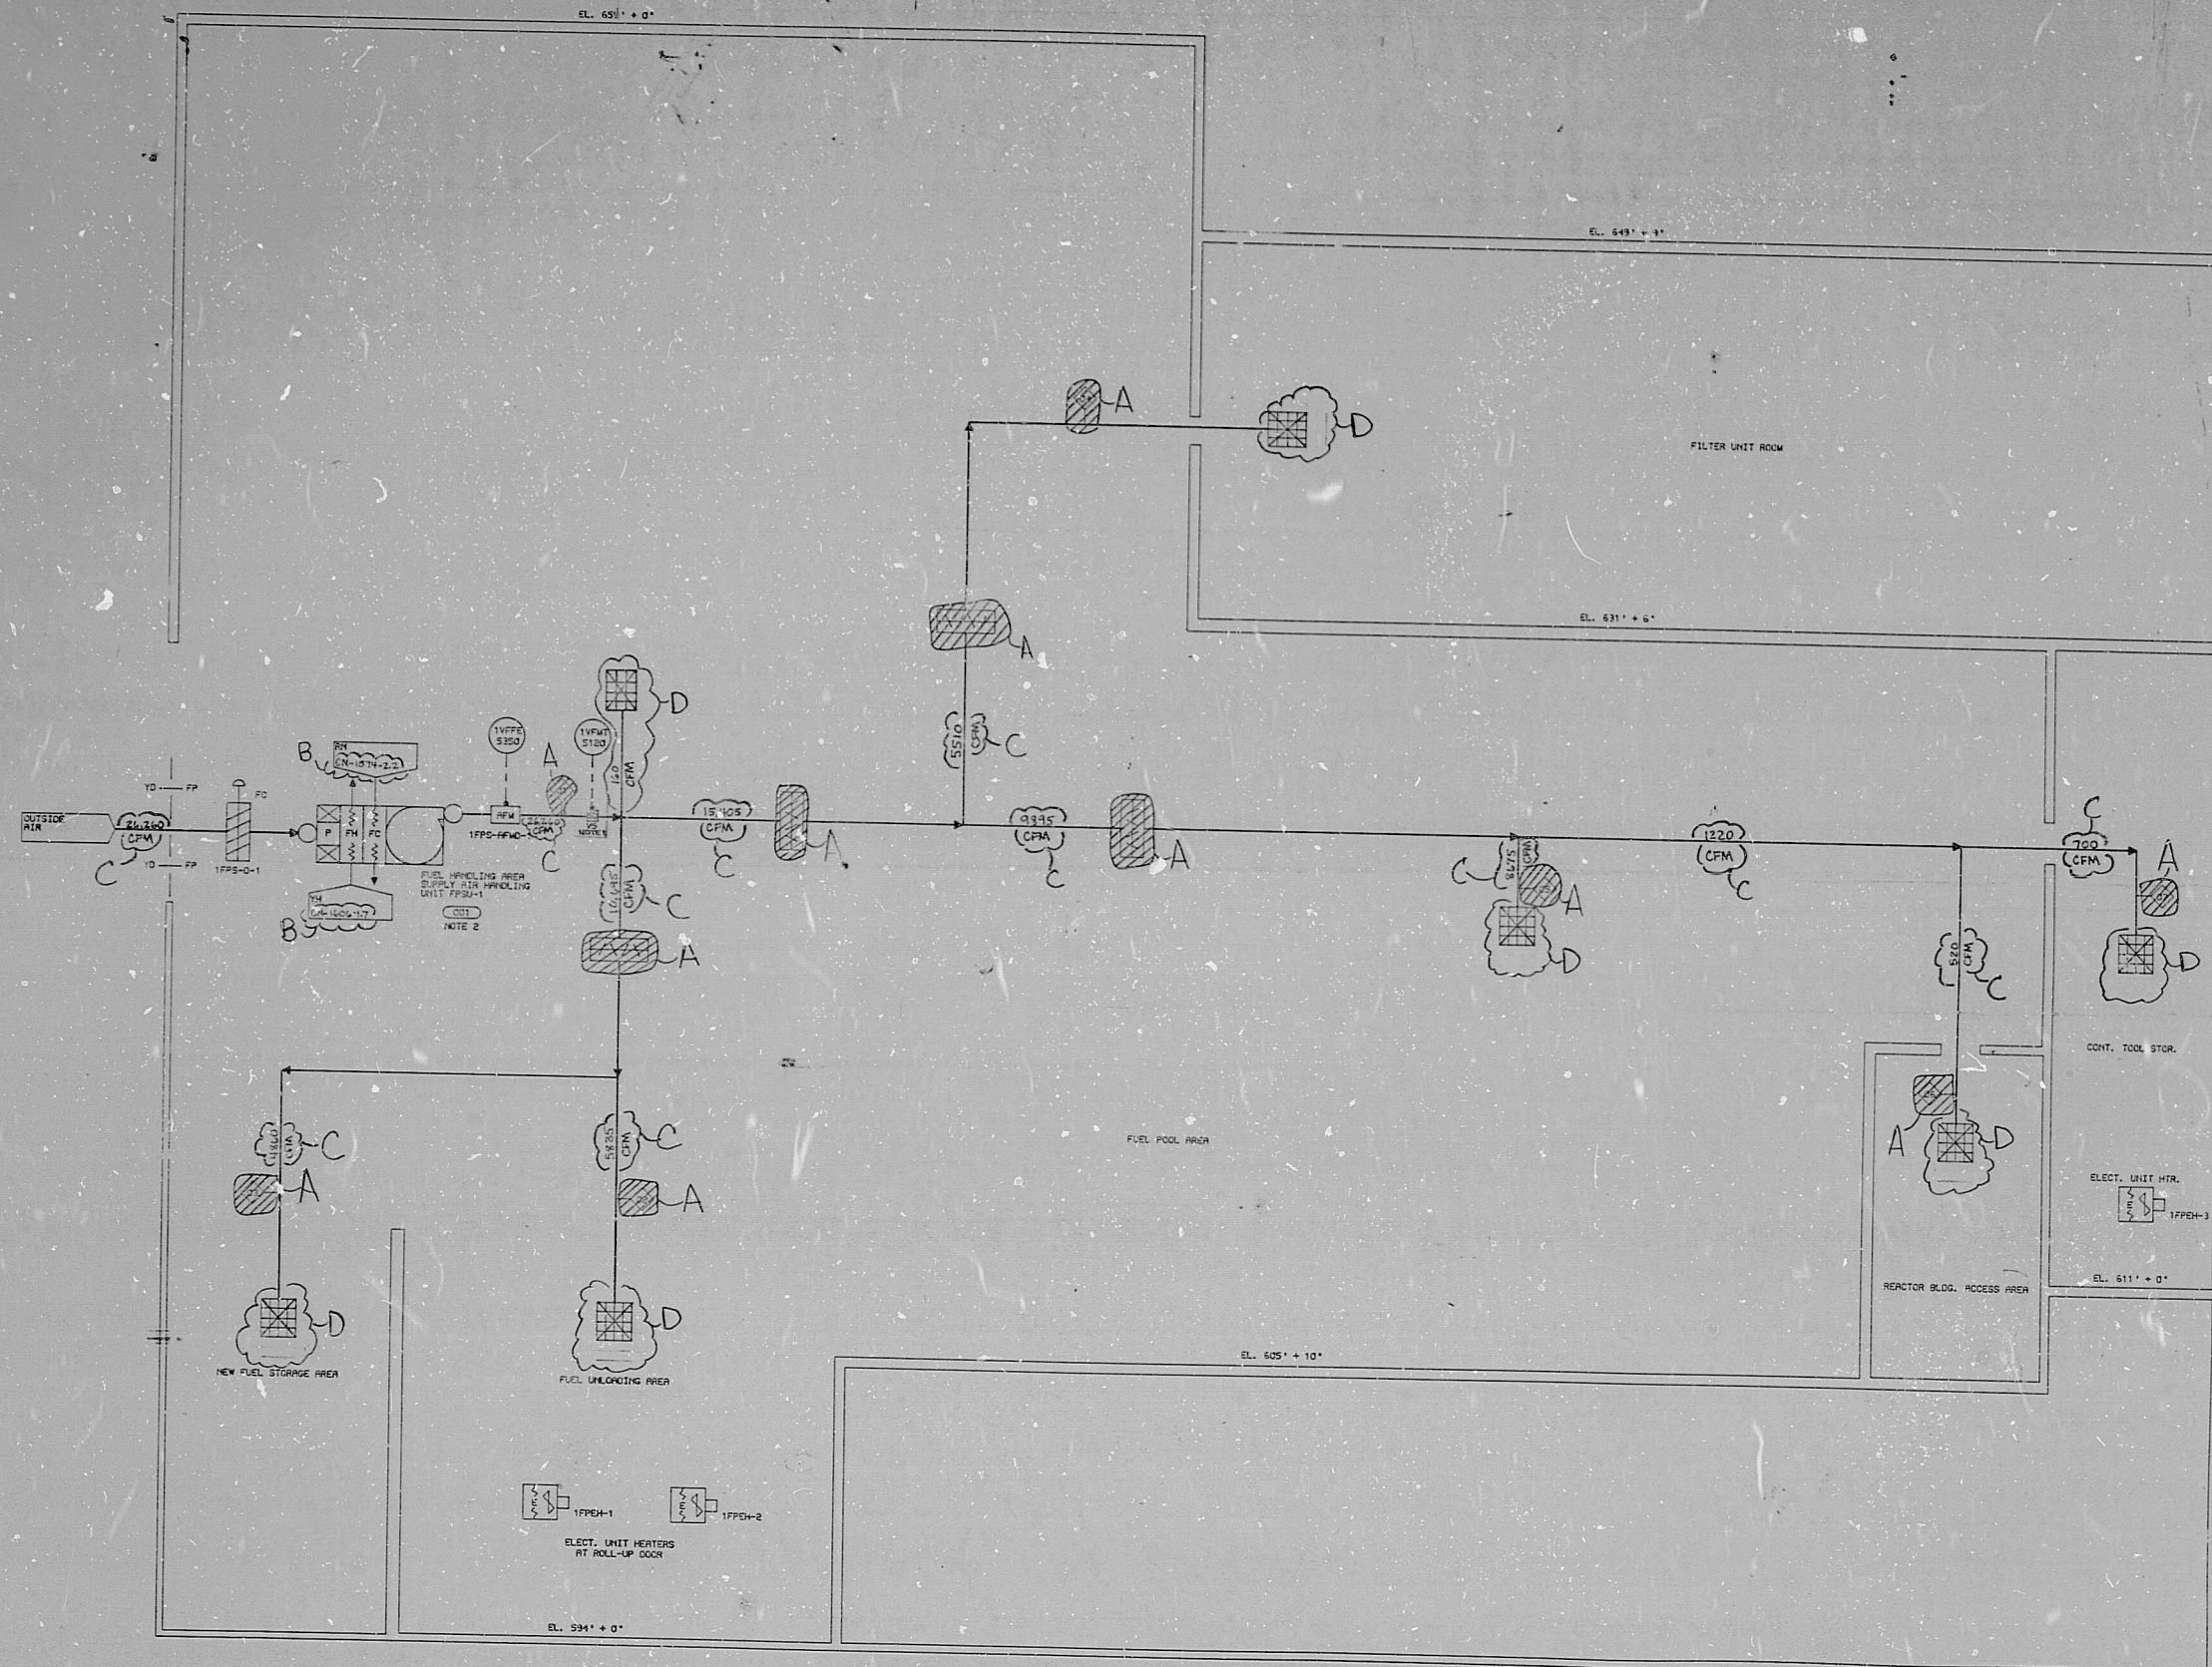

NOTES:
1. SMOKE DETECTOR.
2. FOR DRAINS, SEE DWG. CH-1565-1.1.

FLOW RATES

OL	24,120 CFM
OR	5,995 CFM
OA	3,400 CFM
OH	5,517 CFM
OC	3,615 CFM
OD	232 CFM
OT	708 CFM

TERA
APERTURE
CARD

STATION SERVICES CHANGE ORDER 1577-2.1-05

NO.	DESCRIPTION	DATE	BY	CHKD.
1	DELETE AREA A	11/1/77	...	...

DUKE POWER COMPANY

DESIGNER	DATE	BY	CHKD.
DRAWN	DATE	BY	CHKD.
CHECKED	DATE	BY	CHKD.
APPROVED	DATE	BY	CHKD.

942-2

RIDS-PDR

8107910266

