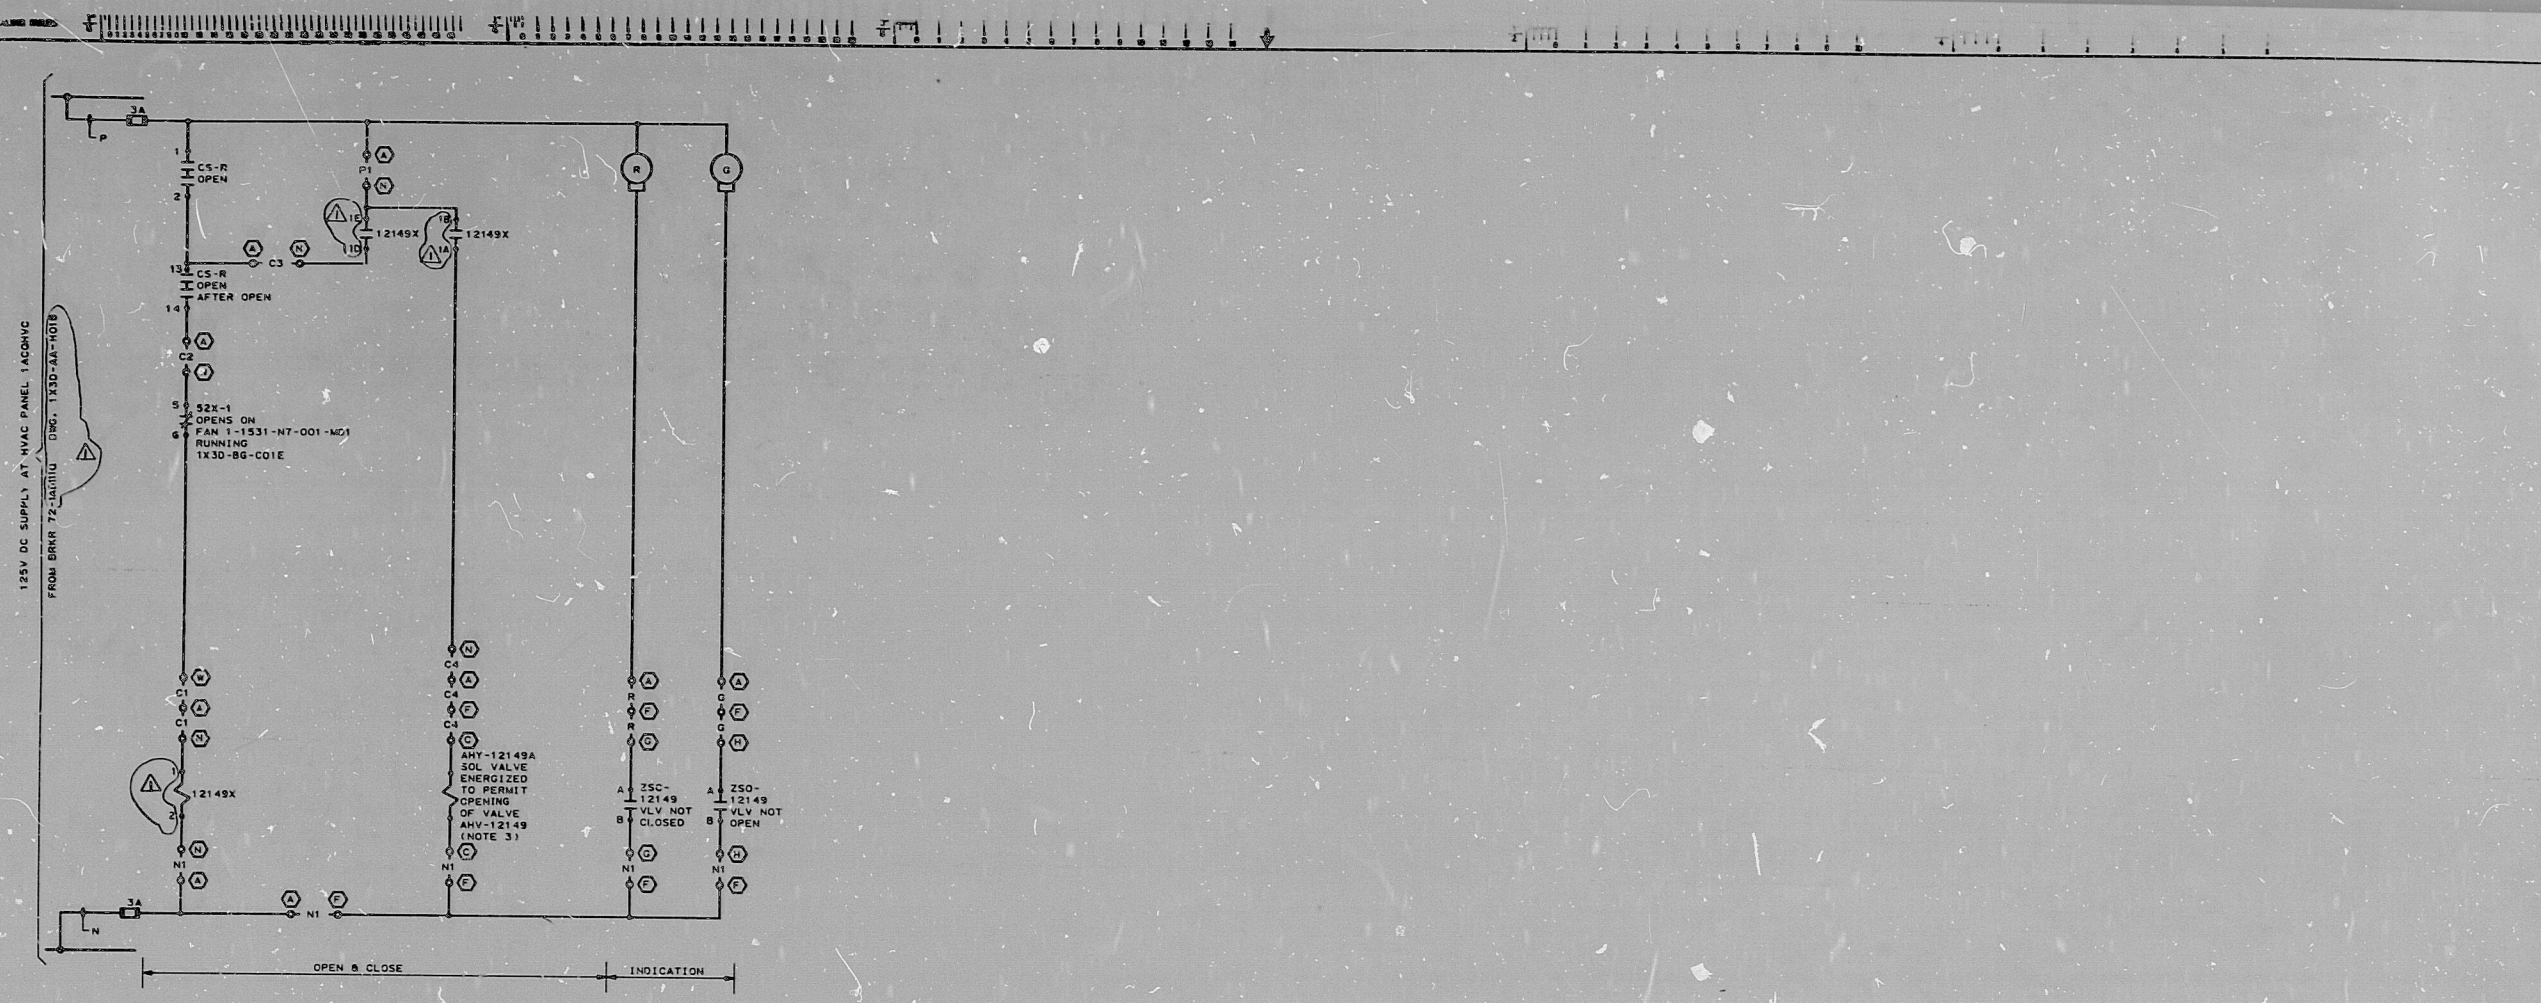


DECK	CONTACTS	CLOSE	AFTER CLOSE	AFTER OPEN	AUTO
1	1-2	X			
2	3-4	X			
3	5-6	X			
4	7-8	X			
5	9-10	X			
6	11-12	X			
7	13-14	X			
8	15-16	X			

		STEM MOUNTED LIMIT SWITCH DEVELOPMENT	
SET	TERMINALS	VALVE POSITION	
		OPEN	CLOSED
Z50	A-B		
	C-D		
	E-F		
	G-H		
Z50	A-B		
	C-D		
	E-F		
	G-H		

— SOLID LINE DENOTES CONTACT CLOSED

--- DASHED LINE DENOTES CONTACT OPEN

NAME O. MIT SWITCH

TYPE EA 180

RIDS

831 0050050

