


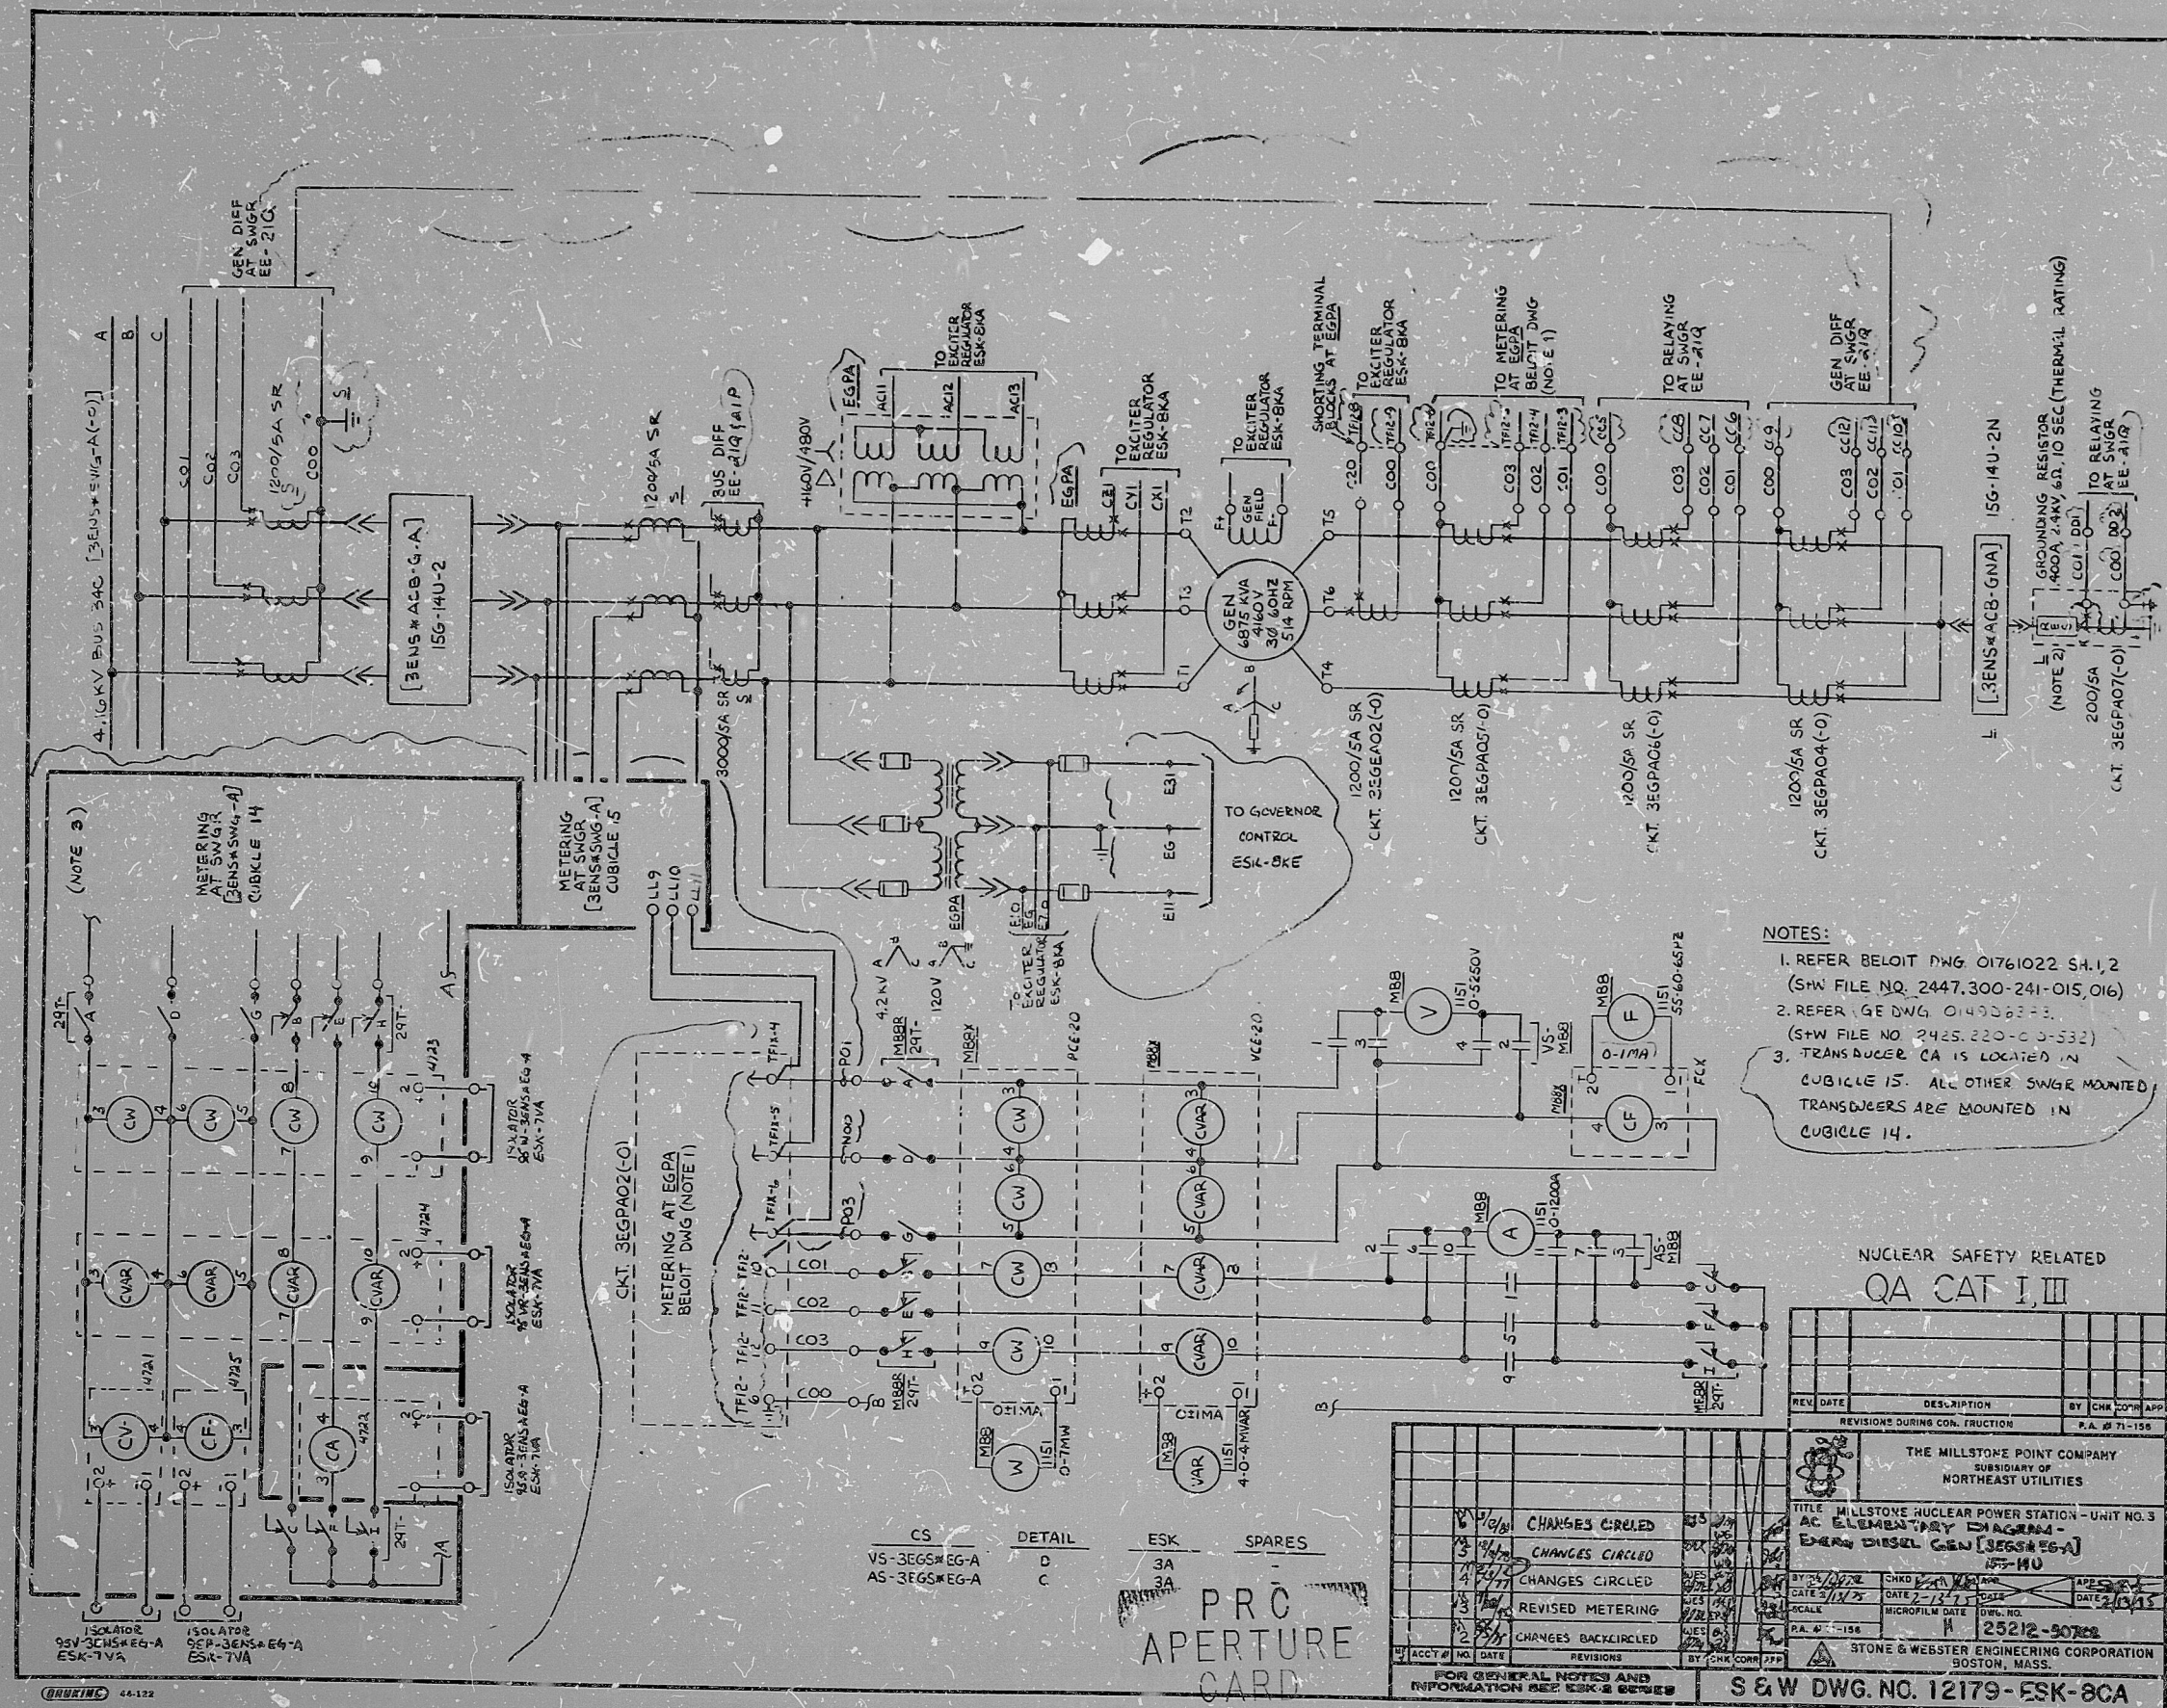

Rids

8212160205

