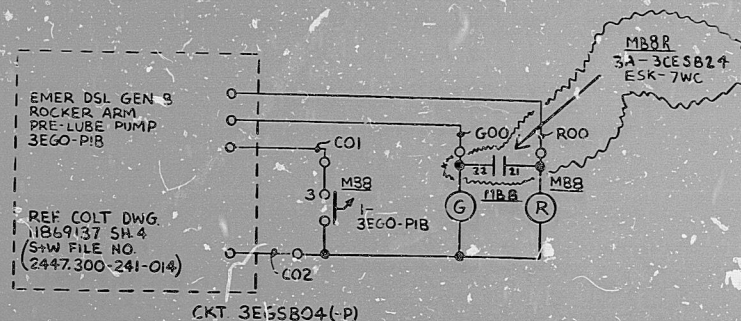


COLT DWG. 11869137 SH. 1-4
(S+W FILE NO. 2447.300-241-011→014)
COLT DWG. 11870053 SH. 1-5
(S+W FILE NO. 2447.300-241-055→059)

NUCLEAR SAFETY RELATED
QA CAT I, II

REVISIONS DURING CONSTRUCTION P.A. # 71-150	
TITLE: MILLSTONE NUCLEAR POWER STATION - UNIT VO. 3 ELEM DIAG - EMER GEN B START CKT [3EGSREG-B]	
1/4/78 CHANGES CIRCLED 8/30/78 CHANGES CIRCLED 2/24/78 REDRAWN	BY 6587/2/78 CHKD 6587 JKS JMS DATE 2/24/78 DATE 2/18/78 SCALE MICROFILM DATE P.A. # 71-150 25212-32782
BY (ACCT) NO DATE REVISIONS BY CHK CORN APP	STONE & WEBSTER ENGINEERING CORPORATION BOSTON, MASS.
FOR GENERAL NOTES AND INFORMATION SEE ESK-2 SERIES S & W DWG. NO. 12173-ESK-8KF	

Rids

821216 0222

