
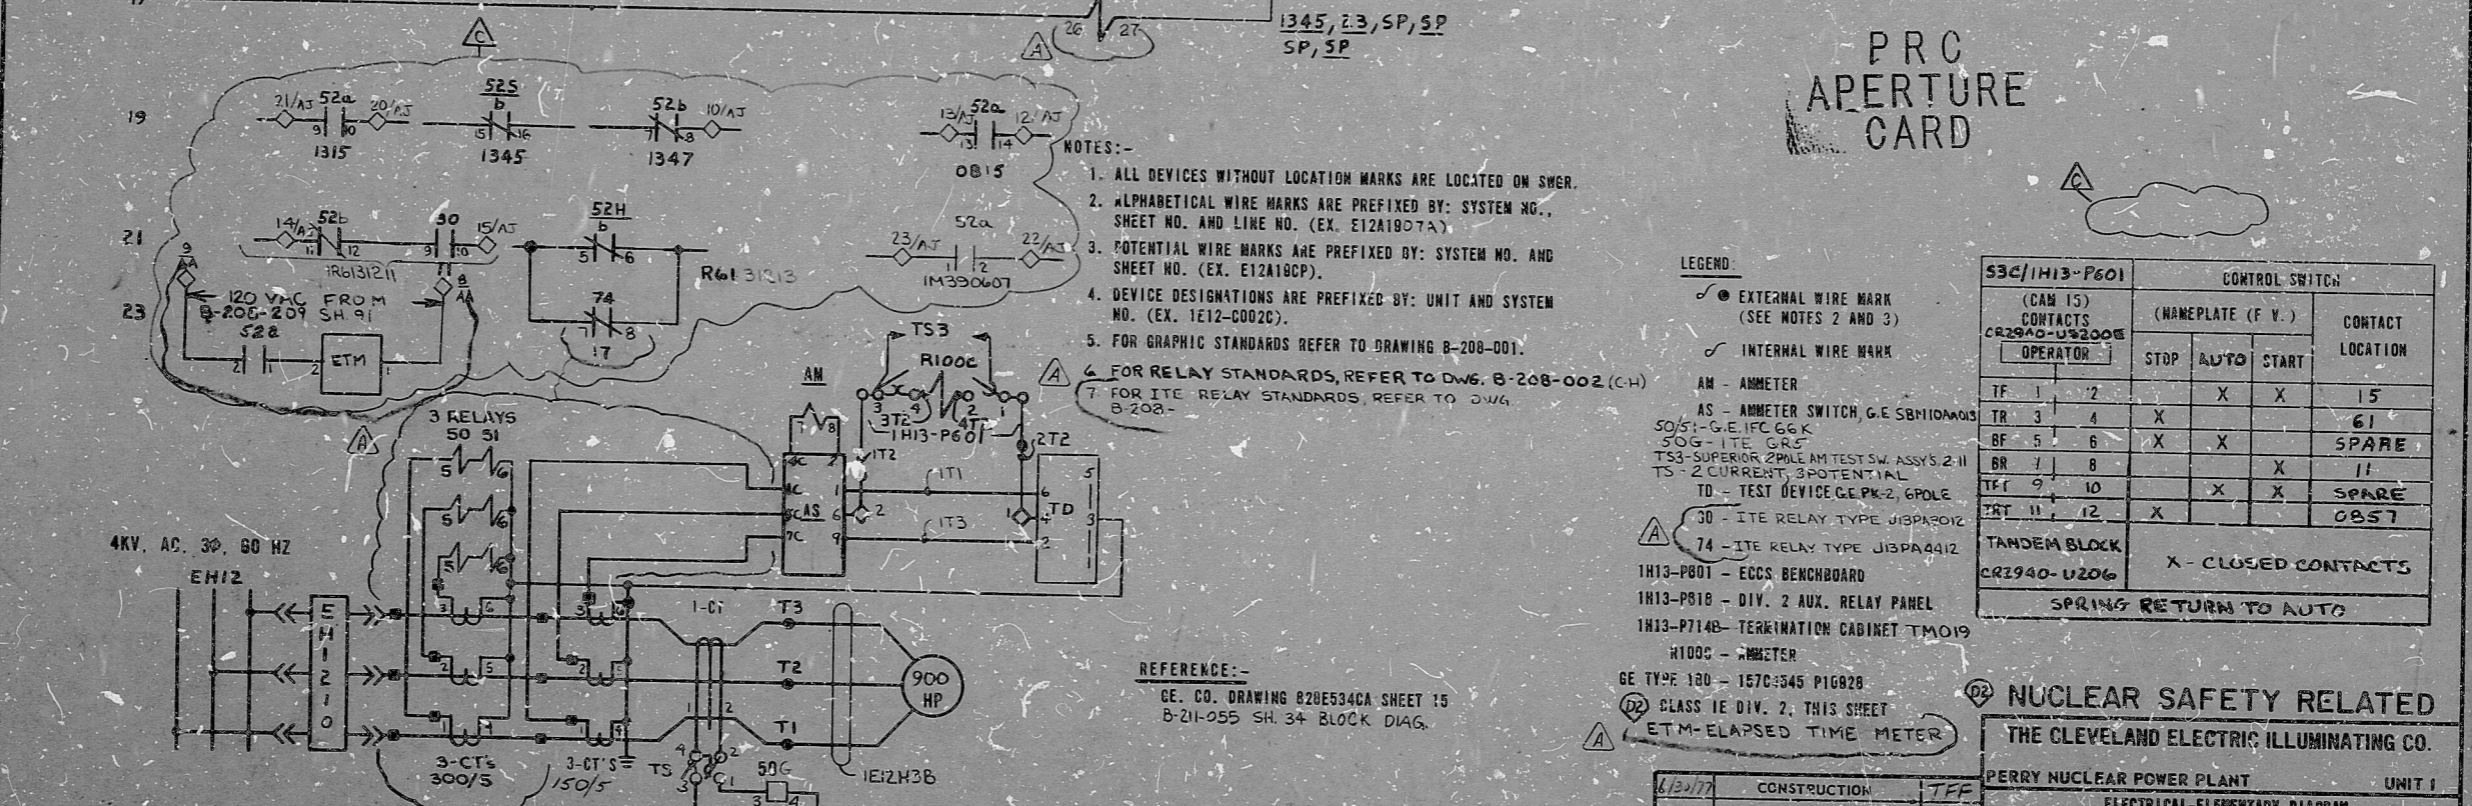


11
11
8.5"
11"
17"

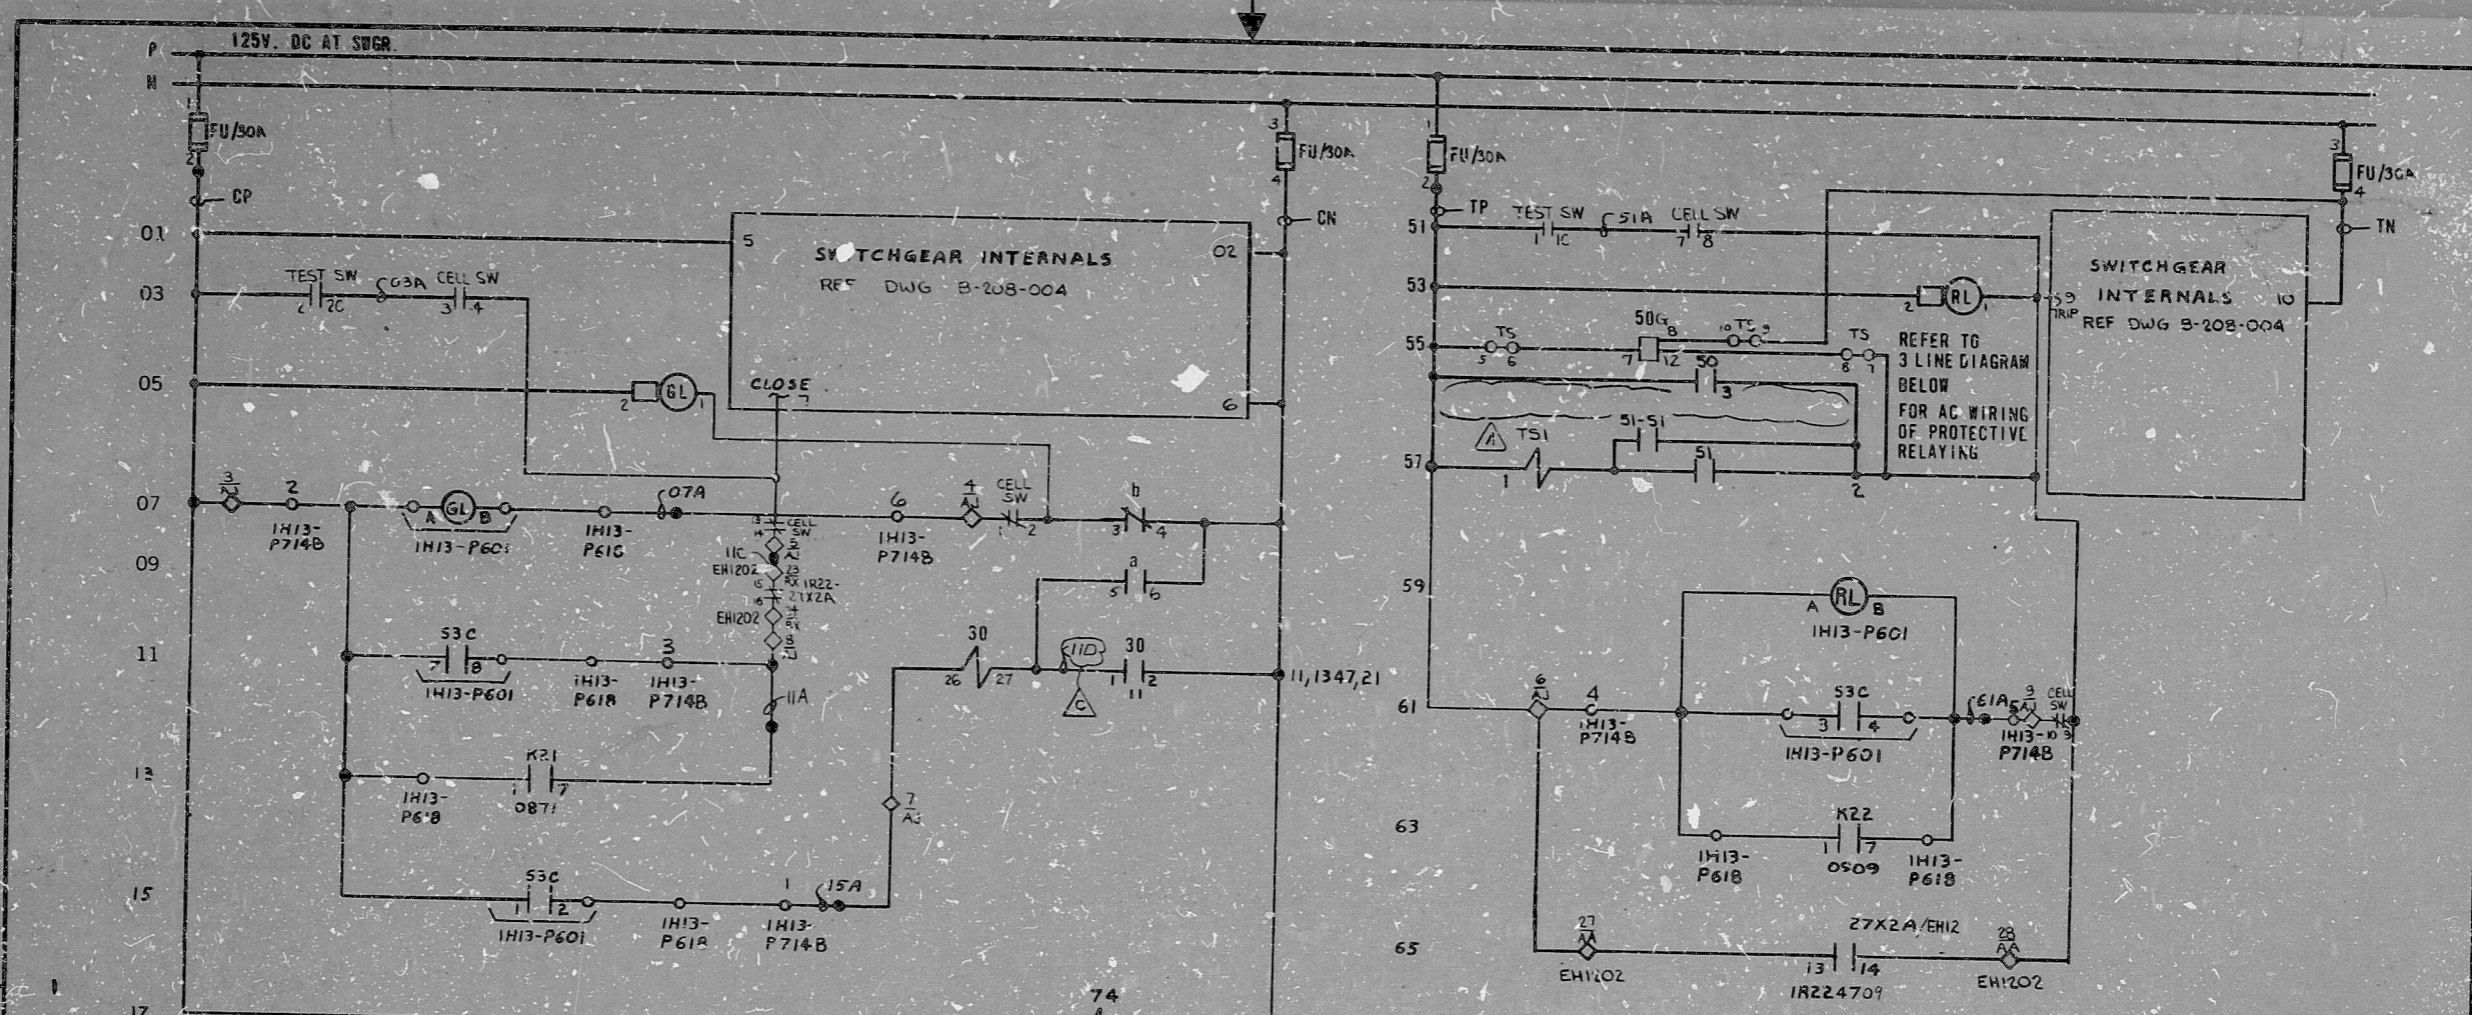

53C/1H13-P601		CONTROL SWITCH			CONTACT LOCATION
(CAM 15) CONTACTS CR2940-U2006 OPERATOR		(NAMEPLATE (F.V.))			
		STOP	AUTO	START	
TF	1, 2		X	X	15
TR	3, 4	X			61
BF	5, 6	X	X		SPARE
BR	7, 8			X	11
TF	9, 10		X	X	SPARE
TR	11, 12	X			0857

TANDEM BLOCK
CR2940-U206
X - CLOSED CONTACTS
SPRING RETURN TO AUTO

NUCLEAR SAFETY RELATED

THE CLEVELAND ELECTRIC ILLUMINATING CO.

PERRY NUCLEAR POWER PLANT UNIT 1
ELECTRICAL-ELEMENTARY DIAGRAM

RESIDUAL HEAT REMOVAL SYSTEM
RHR PUMP CO2C

CONSTRUCTION	TFE	DATE	RELEASED FOR	ENGR.
PRELIMINARY				

GILBERT ASSOCIATES, INC.
ENGINEERS AND CONSULTANTS




4549 B-208-055 F12 A19 C
DRAWING NUMBER SYSTEM SH. NO. REV.

ELEM DIAG RHR PUMP CO2C

11
11
8.5"
11"
17"

RIDS

8212160252

