




10.4.7-4

17'

8107920/80

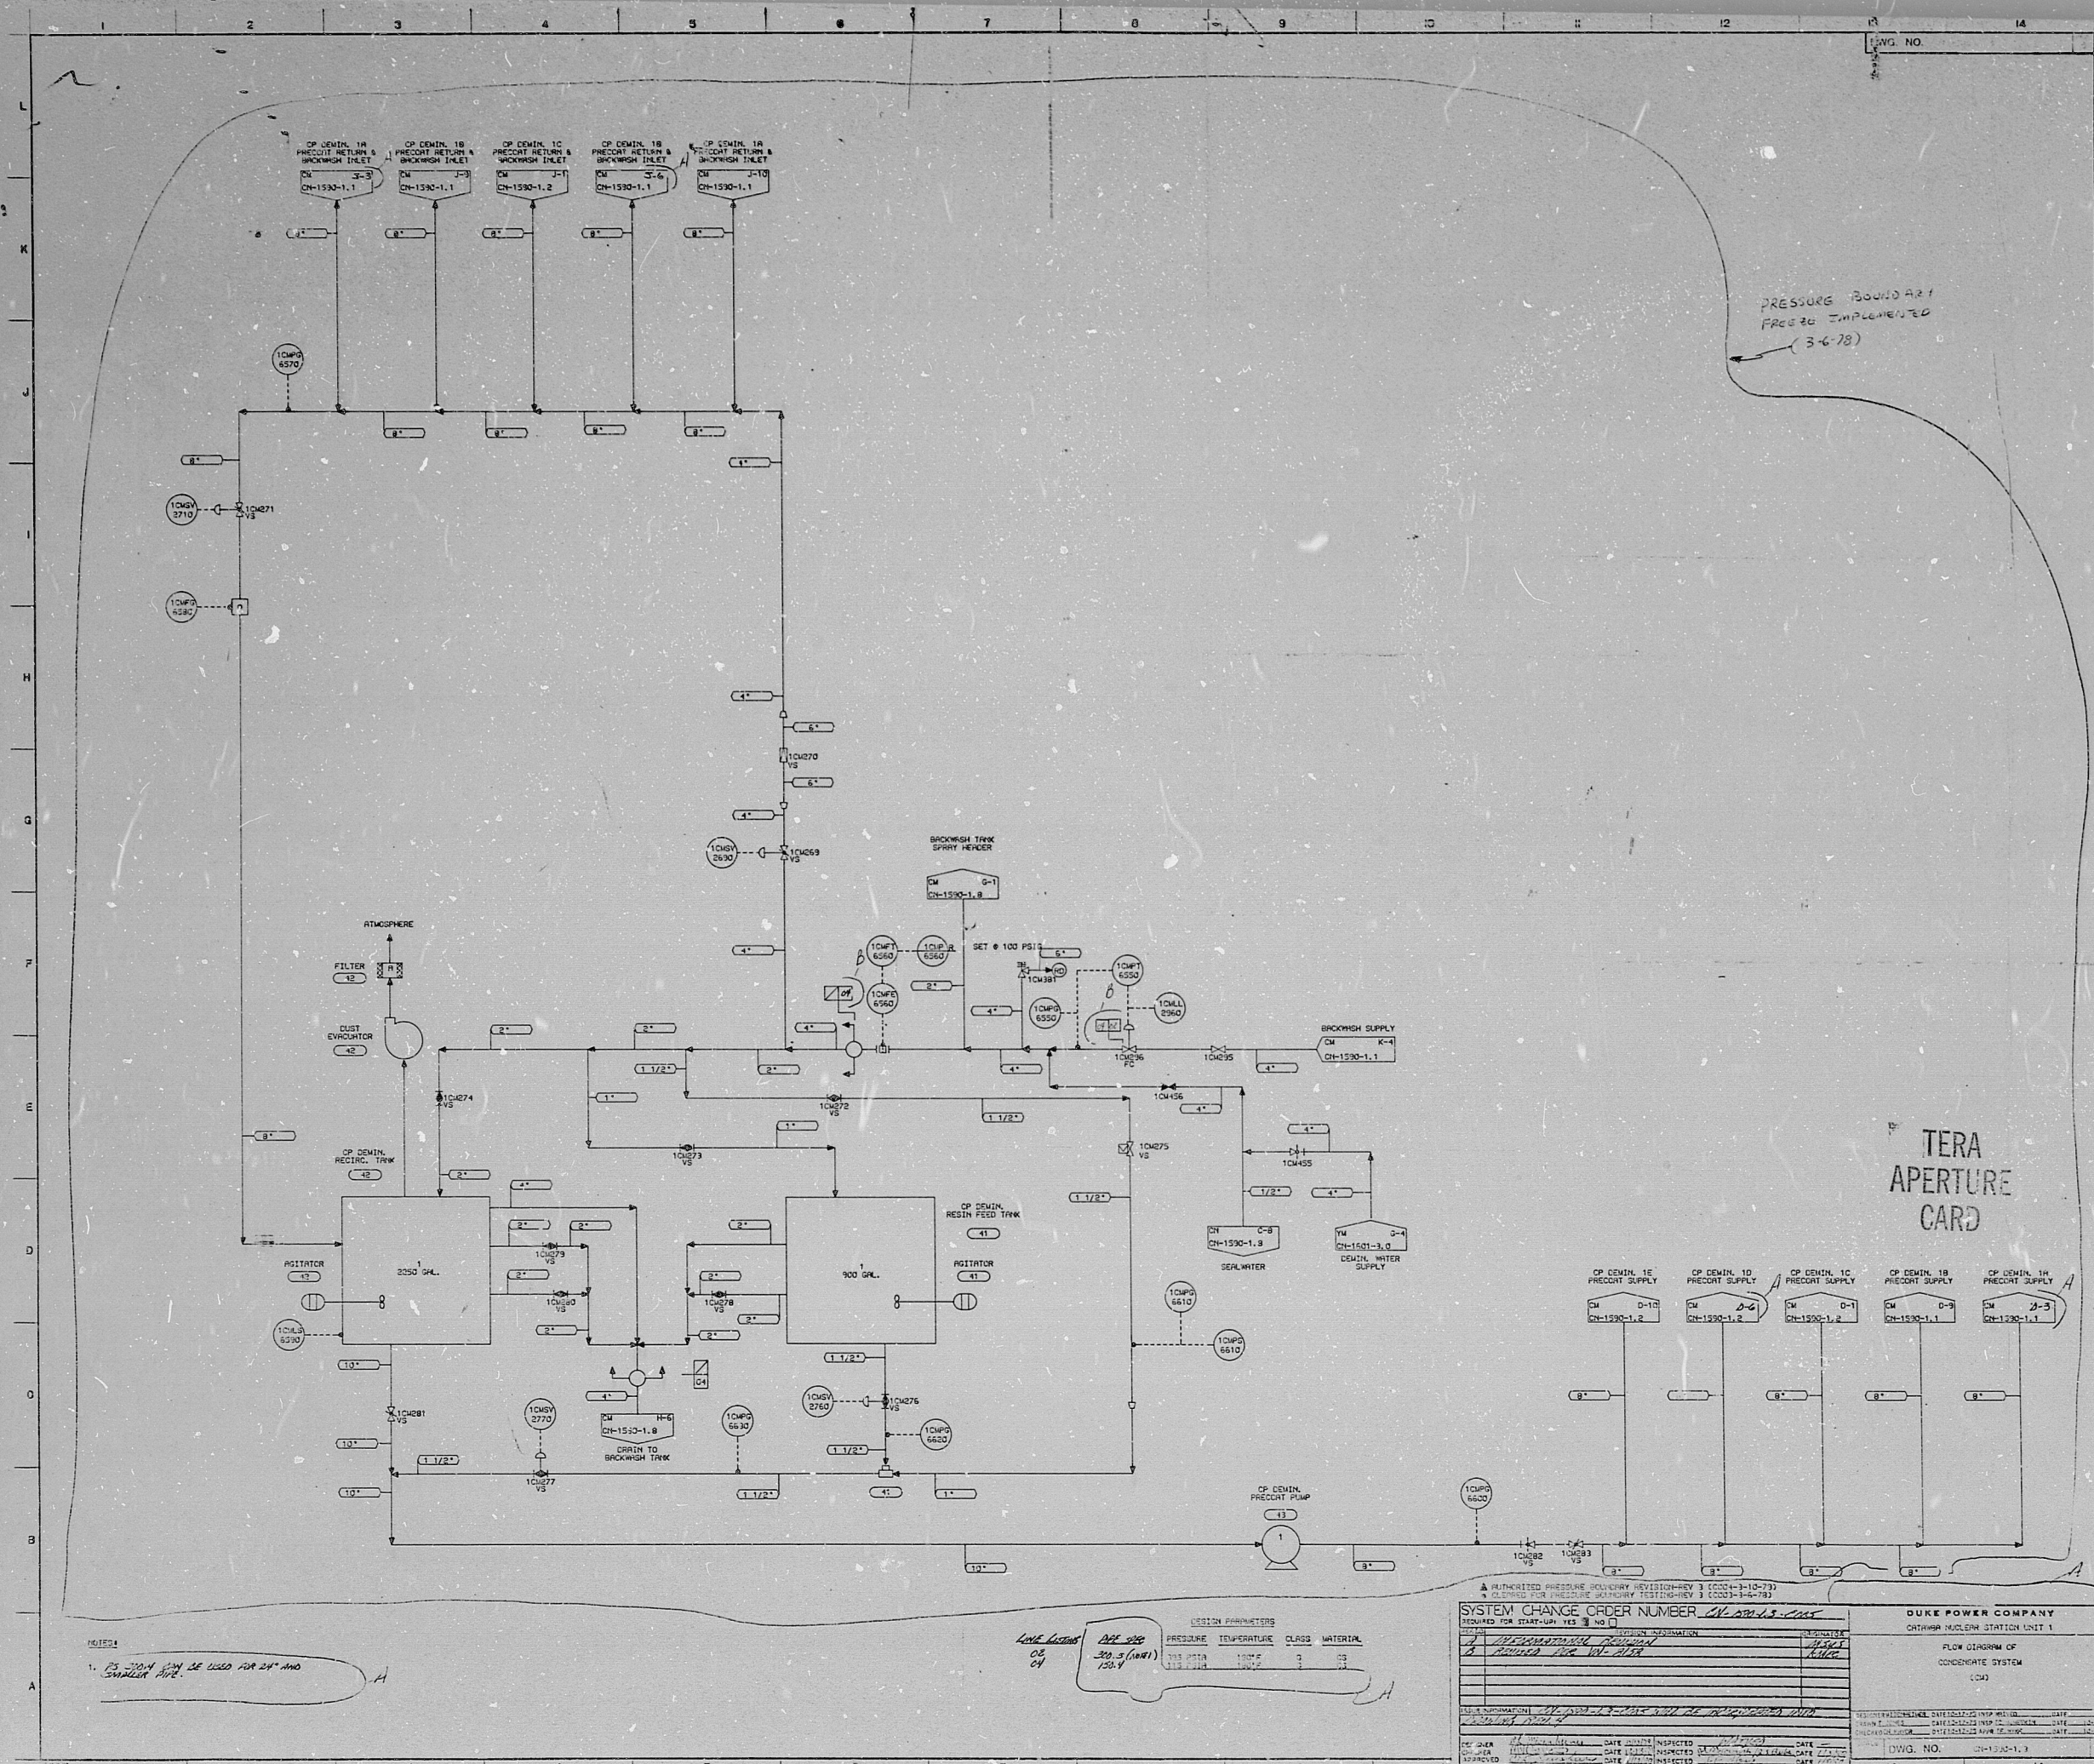