LEGEND:-

EXTERNAL WIRE MARK

INTERNAL WIRE MARK

1H13-P618 DIV. 2 AUX. RELAY PANEL (B)
1H13-PT145 TERMINATION CABINET TM010

(D2) CLASS 1E DIV. 2, THIS SHEET

NOTES:-

1. ALPHABETICAL WIRE MARKS ARE PREFIXED BY: SUBSYSTEM, SHEET NO. AND LINE NO. (EX.: E12A4201A).
2. POTENTIAL WIRE MARKS ARE PREFIXED BY SUBSYSTEM NO. AND SHEET NO. (EX.: E12A0512X1).
3. DEVICE DESIGNATIONS ARE PREFIXED BY: UNIT AND SYSTEM NO. (EX.: 1E12-F0618) EXCEPT AS NOTED (SEE NOTE 6).
4. FOR GRAPHIC STANDARDS, REFER TO DRAWING B-208-001.
5. VALVES F051B AND F065B NORMALLY CLOSED. SOLENOID ENERGIZE TO OPEN.
6. THE FOLLOWING DEVICES ARE PREFIXED BY 1E12A: F20B, F26B - FUSES.

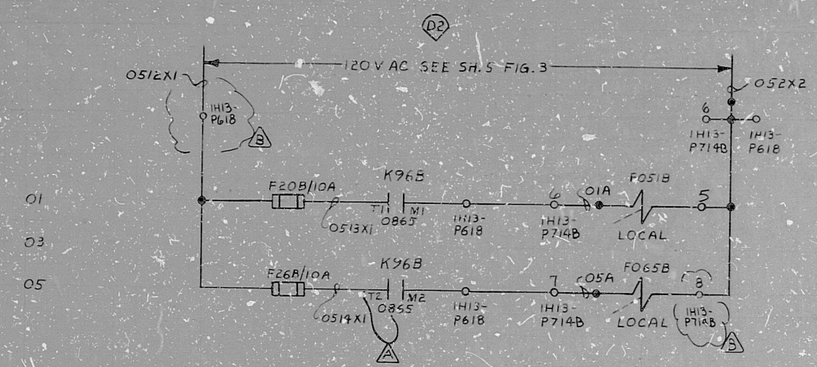

REFERENCE

GE.CO.DWG. 828E534CA SH.14

B-211-065 SH. 42

(C)

PRC APERTURE CARD

(D2) NUCLEAR SAFETY RELATED

REV	MADE	CHKD	APPROVALS	DATE	REV	MADE	CHKD	APPROVALS	DATE	REV	MADE	CHKD	APPROVALS	DATE	REV	MADE	CHKD	APPROVALS	DATE	REV	MADE	CHKD	APPROVALS	DATE
										C		TAM	DEG	RAM 6/21/82	B	RMJ	RAM	DEG	RAM 8-17-79	A	WW	RAM	DEG	RAM

ADDED REFERENCE AS PER GAE GUIDELINE — ADDED FITS INFORMATION — REV. CONTACT DESIG.

E L E M D I A G 1 E 1 2 - F 0 5 1 B & F 0 6 5 B

6/30/77	CONSTRUCTION	TFE			
	PRELIMINARY				
DATE	RELEASED FOR	ENGR.			

REA.INV. 9A — GILBERT ASSOCIATES, INC. ENGINEERS AND CONSULTANTS

WORK ORDER	MADE	CHKD.	DR. APP.	ENG. APP.	DATE
044549-000	BLC	RAM	DEG	TFE	6/30/77

THE CLEVELAND ELECTRIC ILLUMINATING CO.

PERRY NUCLEAR POWER PLANT — UNIT 1

ELECTRICAL-ELEMENTARY DIAGRAM

RESIDUAL HEAT REMOVAL SYSTEM
STEAM PRESSURE REDUCING VALVE F051B
COND. DISCHARGE TO SUPP. POOL OR RCIC VV. F065B

DRAWING NUMBER			SYSTEM	SH. NO.	REV.
04	4549	B-208-055	E12	A42	C

RIDS

8212160328

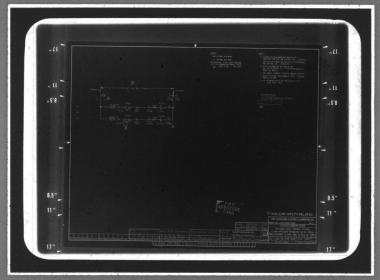

MMM 5924 — FILMSORT® Broad Aperture & Camera Cards and DUPLICARD® Broad Copy Cards — Product of 3M Company, St. Paul, Minn.