

17

11

5.8

8.5

11

17

17



11

5.8

8.5

11

17

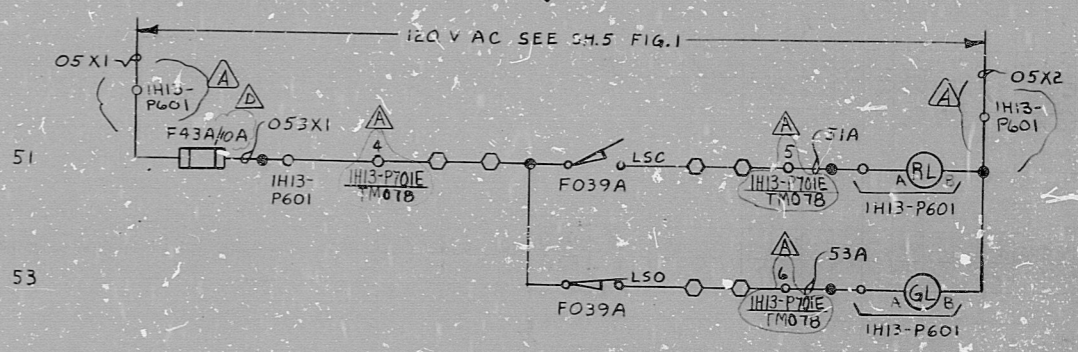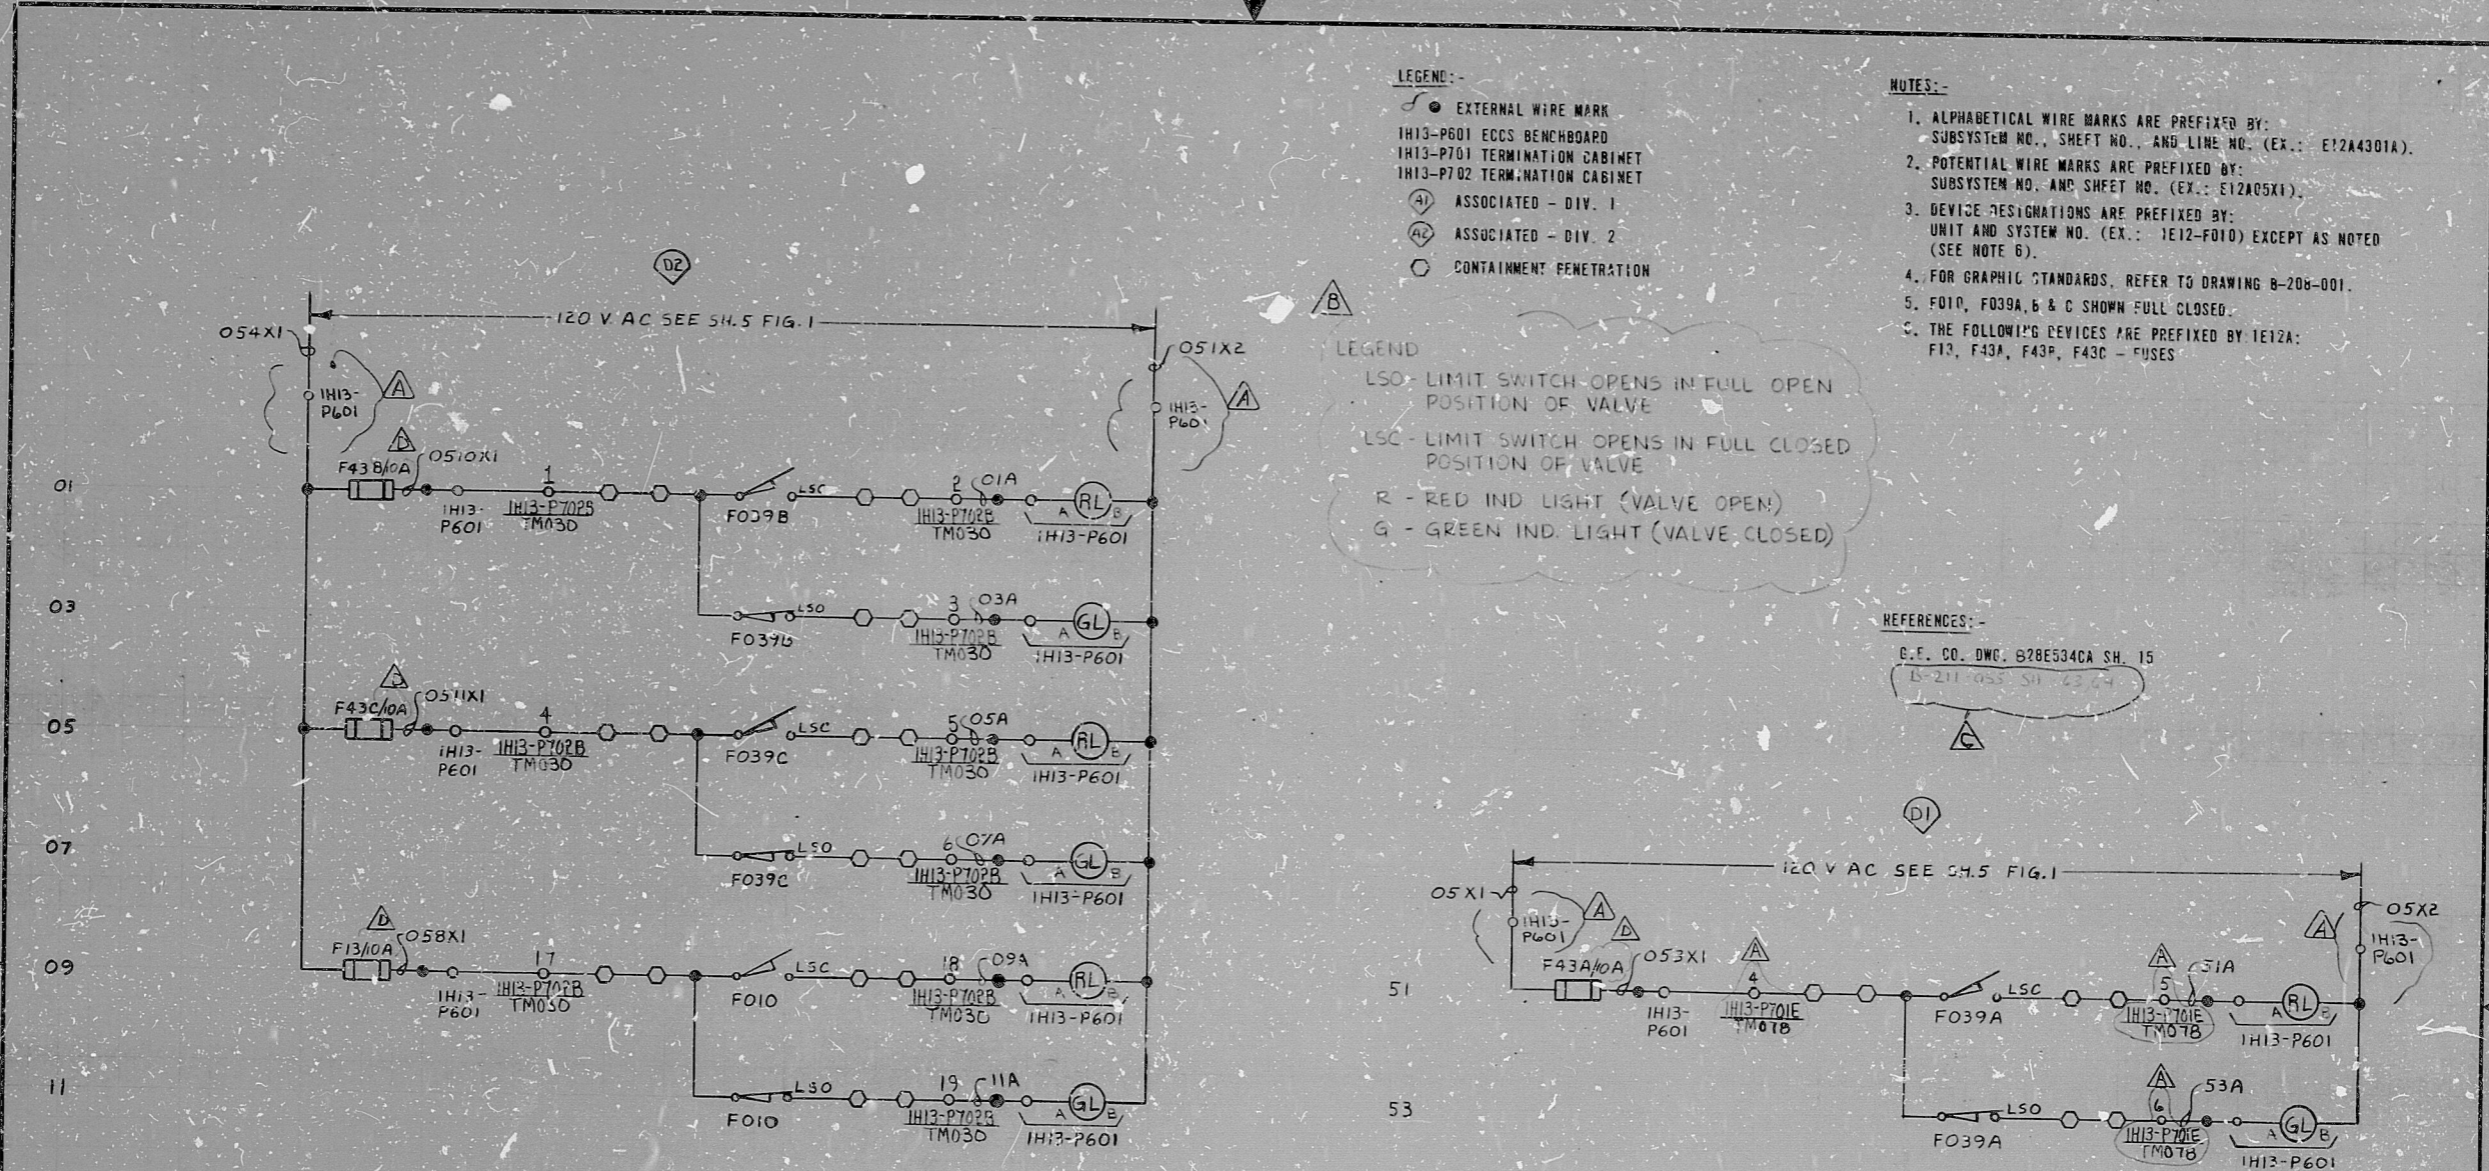

PRC APERTURE CARD

NUCLEAR SAFETY RELATED

CHANGED: FUSE SIZES												ADDED REFERENCE AS PER GAI BLUE LINE												ADDED LEGEND												ADDED FITS INFORMATION CHANGED TERM CAB												READING PA												GILBERT ASSOCIATES, INC. ENGINEERS AND CONSULTANTS												DATE RELEASED FOR ENGR.												THE CLEVELAND ELECTRIC ILLUMINATING CO. PERRY NUCLEAR POWER PLANT UNIT 1 ELECTRICAL-ELEMENTARY DIAGRAM											
D Y K T A M B R A M 8/23/82												C J C T A M D E G R A M 4/18/82												B E S G R M D E G R A M 9-3-80												A R M R A M D E G R A M 8-17-78												044549-000												B J C R A M D E G T F F 6/5/77												04 4549 B-208-055 E12 A43 D																							
REV MADE CHKD APPROVALS DATE												REV MADE CHKD APPROVALS DATE												REV MADE CHKD APPROVALS DATE												REV MADE CHKD APPROVALS DATE												REV MADE CHKD APPROVALS DATE												REV MADE CHKD APPROVALS DATE												REV MADE CHKD APPROVALS DATE																							
ELEM DIAG												F12-F039A, F039B, F039C																																																												REV. B WCR 1280																							



RIDS

82L2160338

