


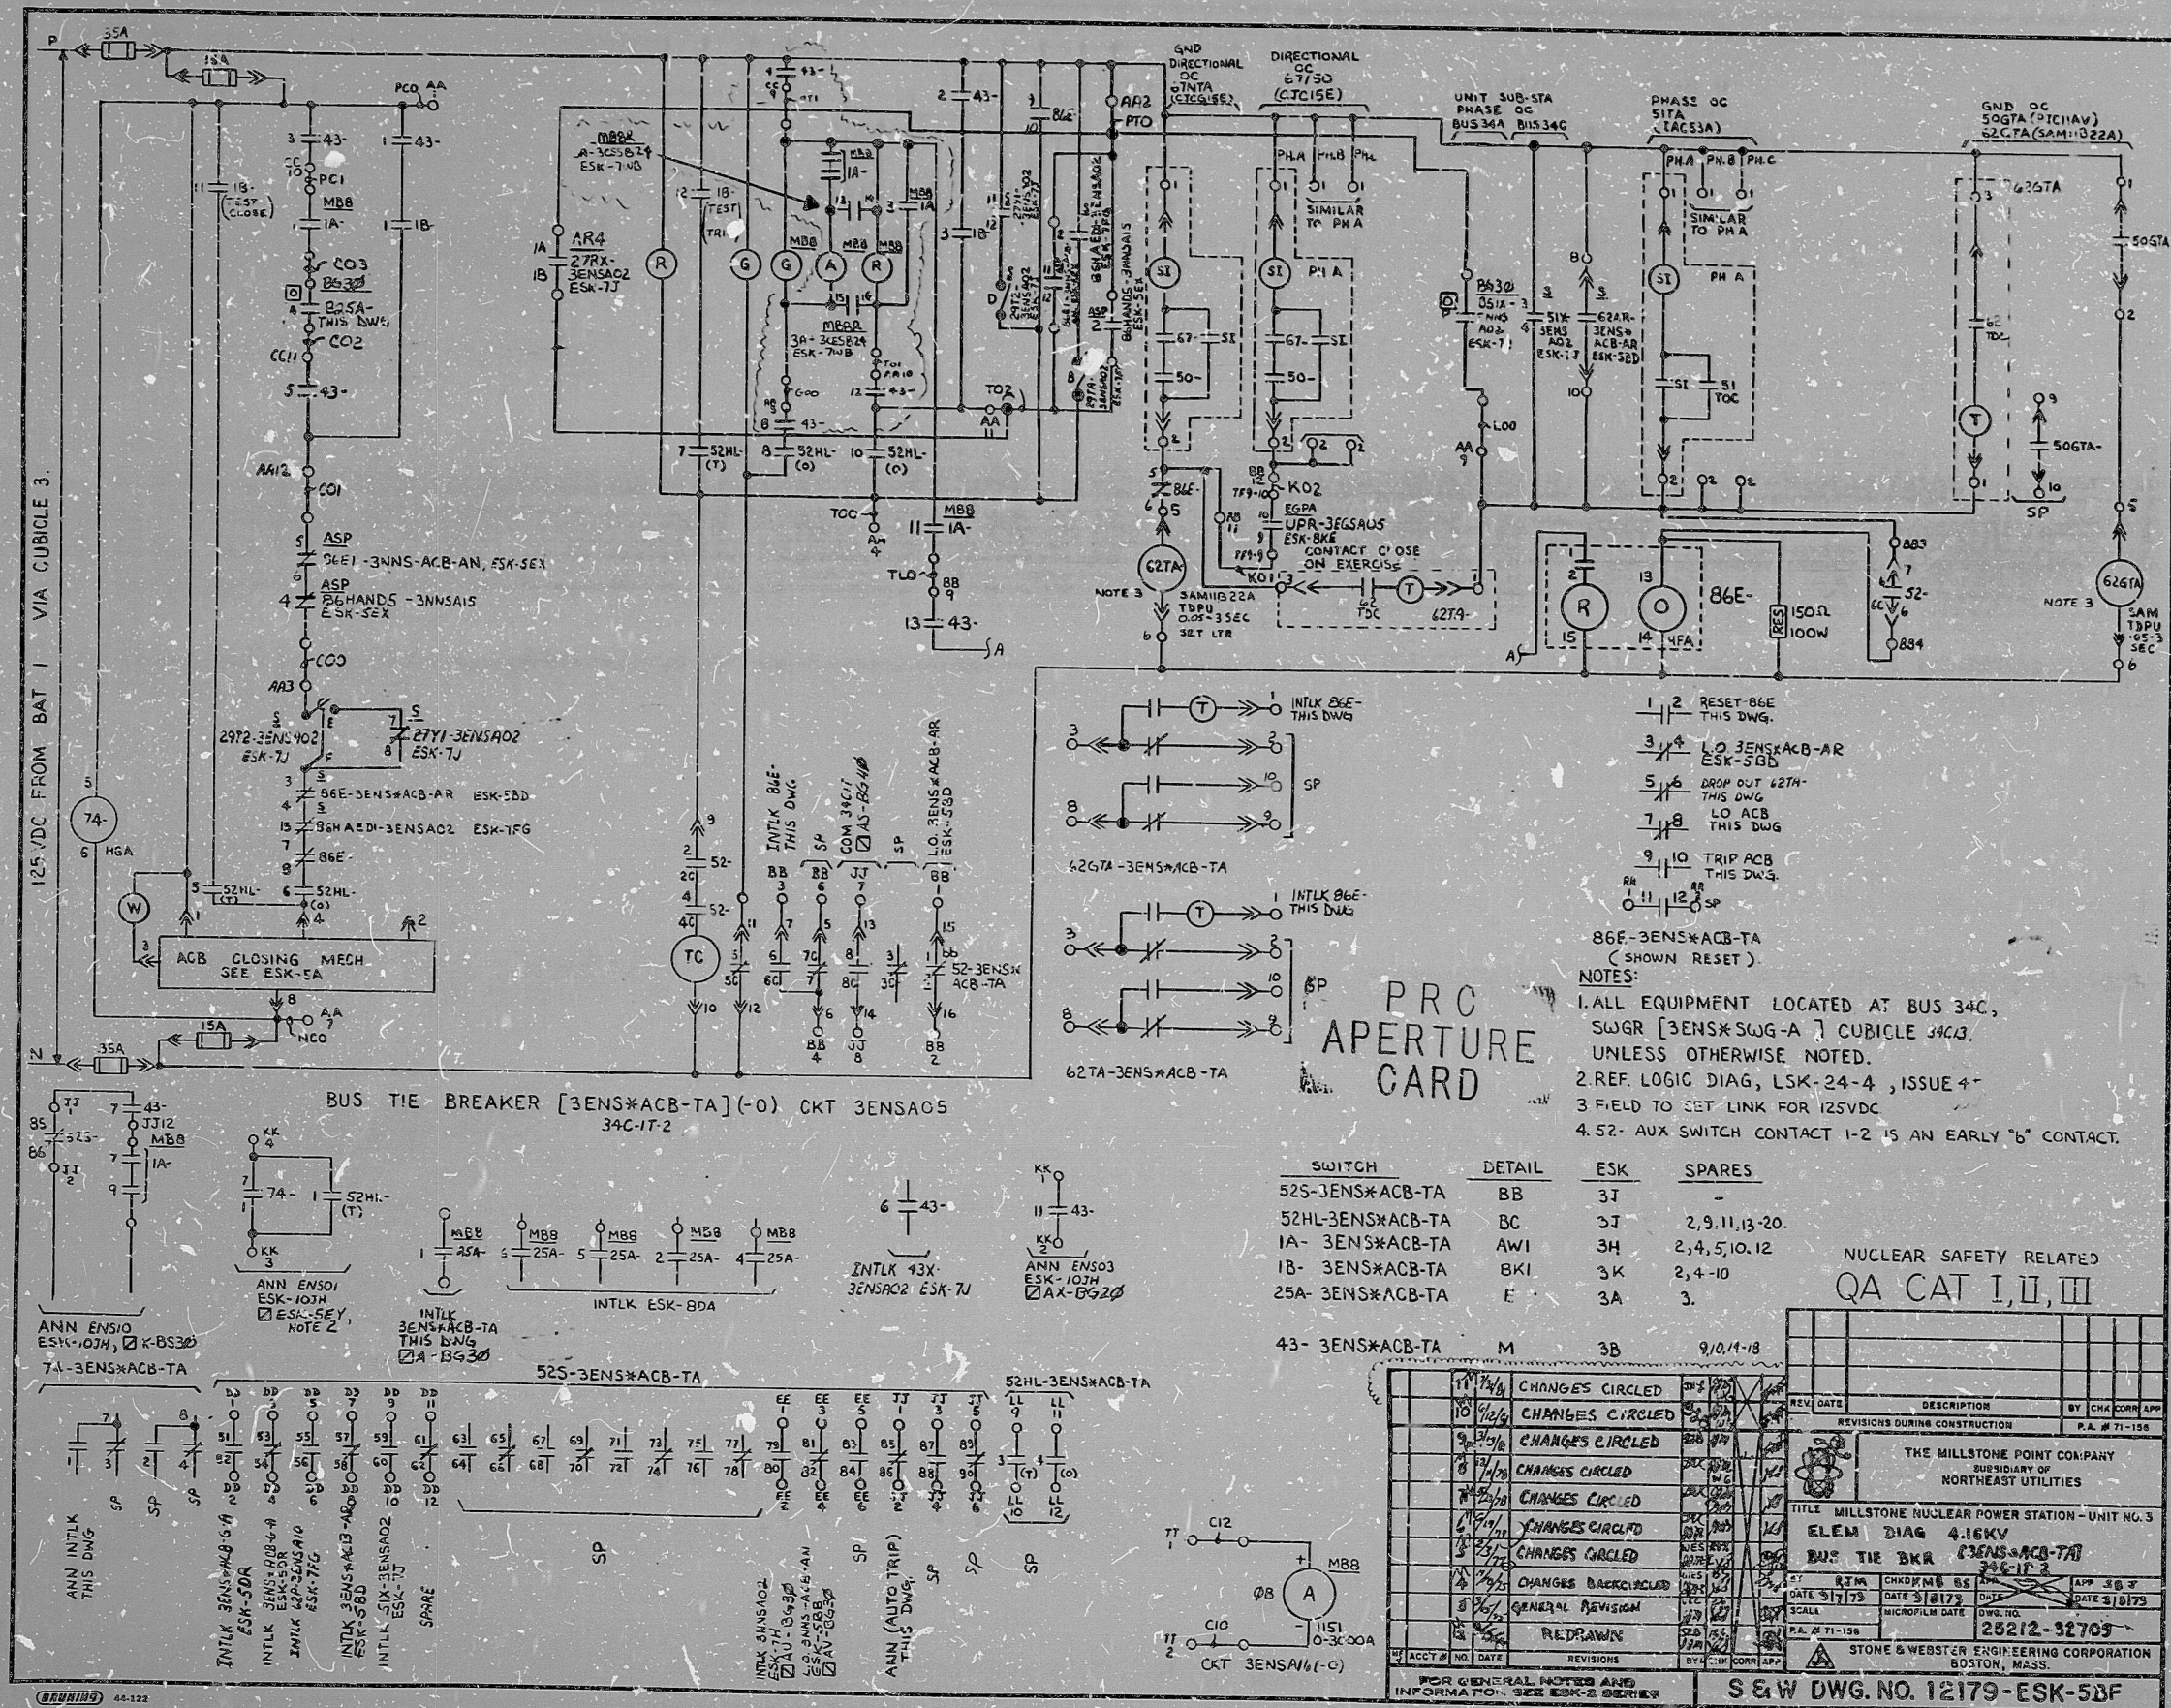

Rids

8212160363

