


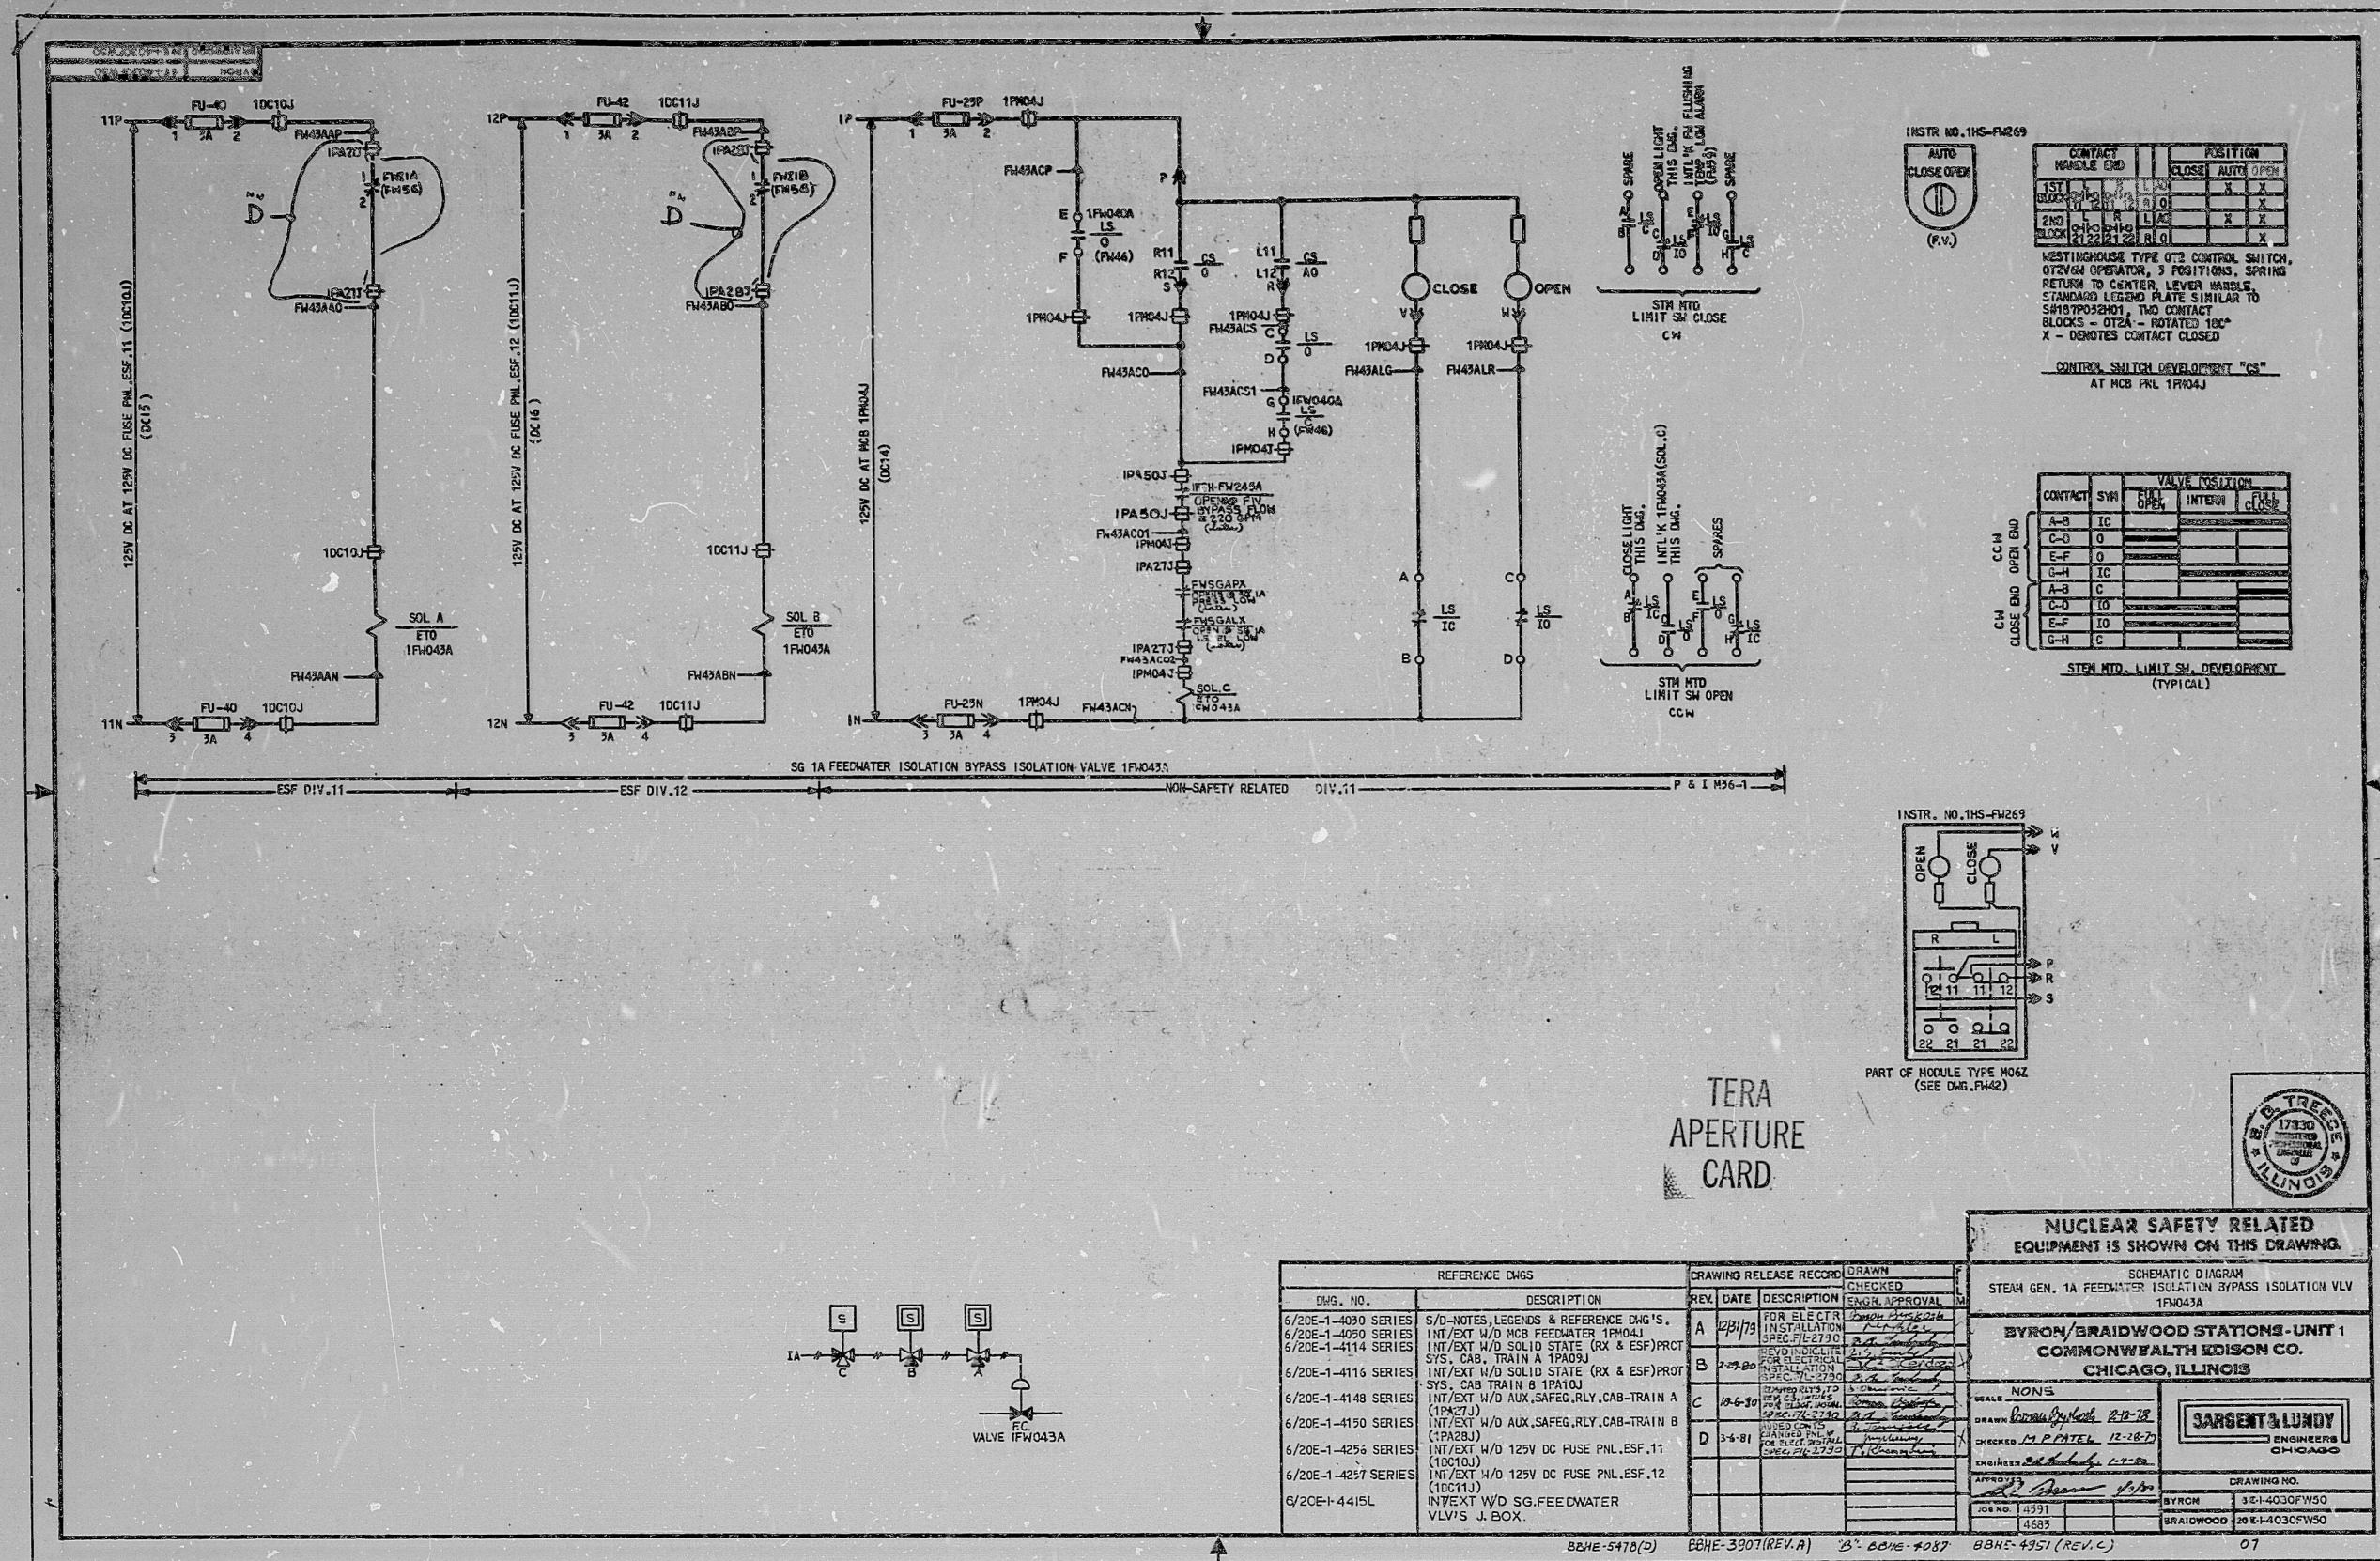

INSTR. NO. 1HS-FW269


CONTACT	NAME	END	POSITION

WESTINGHOUSE TYPE OT2 CONTROL SWITCH, 125V/60 HZ, 3 POSITIONS, SPRING RETURN TO CENTER, LEVER HANDLE, STANDARD LEGEND PLATE SIMILAR TO SH187P032H01, TWO CONTACT BLOCKS - 012A - NOTATED 18C" X - DENOTES CONTACT CLOSED


CONTROL SWITCH DEVELOPMENT "CS" AT MCB PRL 1P04J

CONTACT	SVN	VALVE POSITION

STEAM MTD. LIMIT SW. DEVELOPMENT (TYPICAL)

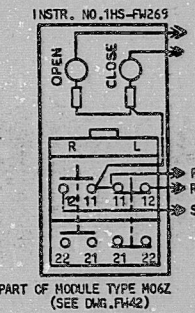

TERA APERTURE CARD

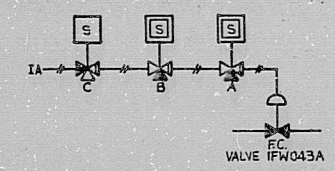

DMG. NO.	DESCRIPTION	REV.	DATE	DESCRIPTION	ENGR. APPROVAL
6/20E-1-4030 SERIES	S/D-NOTES, LEGENDS & REFERENCE DMG'S.	A	12/1/79	FOR ELECTRICAL INSTALLATION	
6/20E-1-4030 SERIES	INT/EXT W/D MCB FEEDWATER 1P04J	B	2-27-80	REVISED FOR ELECTRICAL INSTALLATION	
6/20E-1-4257 SERIES	INT/EXT W/D SG FEEDWATER VLV'S J. BOX.				
6/20E-1-4415L					

62HE-5478(D) 62HE-3907(REV.A) 62HE-4087 62HE-4957 (REV.C) 07

NUCLEAR SAFETY RELATED EQUIPMENT IS SHOWN ON THIS DRAWING	
SCHEMATIC DIAGRAM	
STEAM GEN. 1A FEEDWATER ISOLATION BYPASS ISOLATION VLV 1F043A	
BYRON/BRAIDWOOD STATIONS - UNIT 1	
COMMONWEALTH EDISON CO.	
CHICAGO, ILLINOIS	
SCALE: NONE	
DRAWN: [Signature]	
CHECKED: [Signature]	
ENGR. APPROVAL: [Signature]	
DRAWING NO. 3-1-4030FW50	
BYRON/BRAIDWOOD 20 K-1-4030FW50	

RIDS

8107060493

