


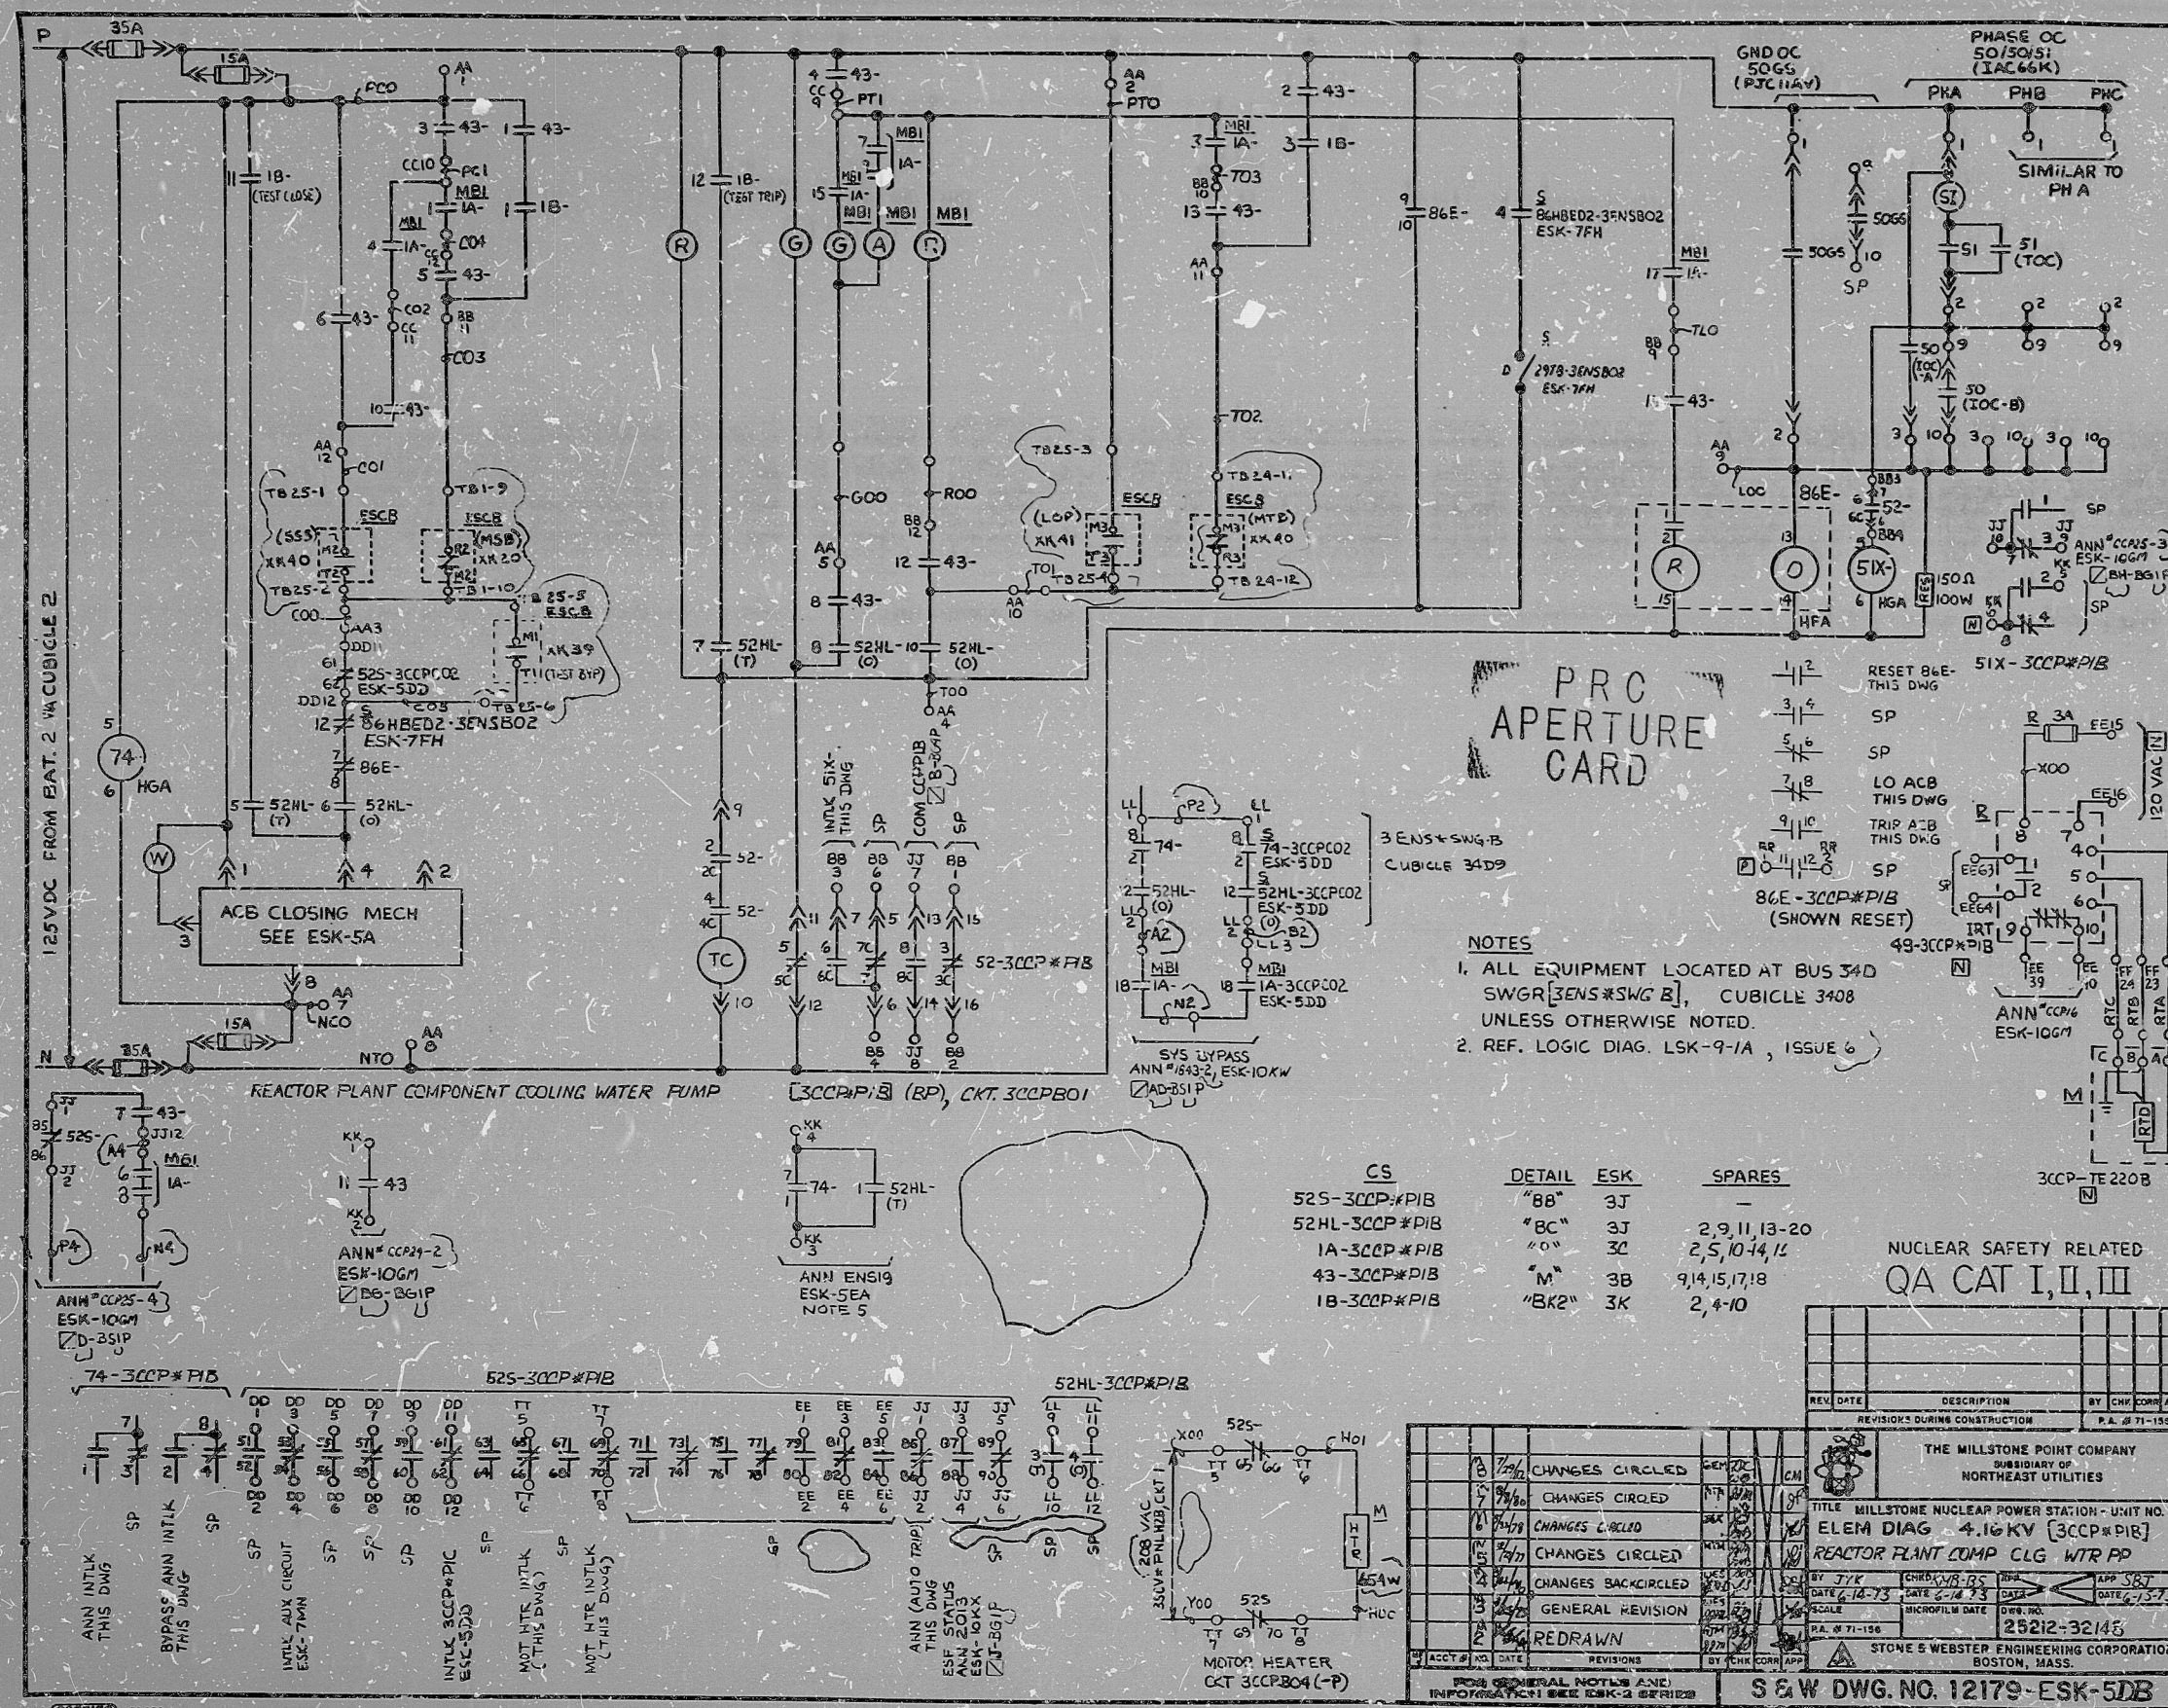

NUCLEAR SAFETY RELATED
QA CAT I, II, III

Rids

8212160444

