


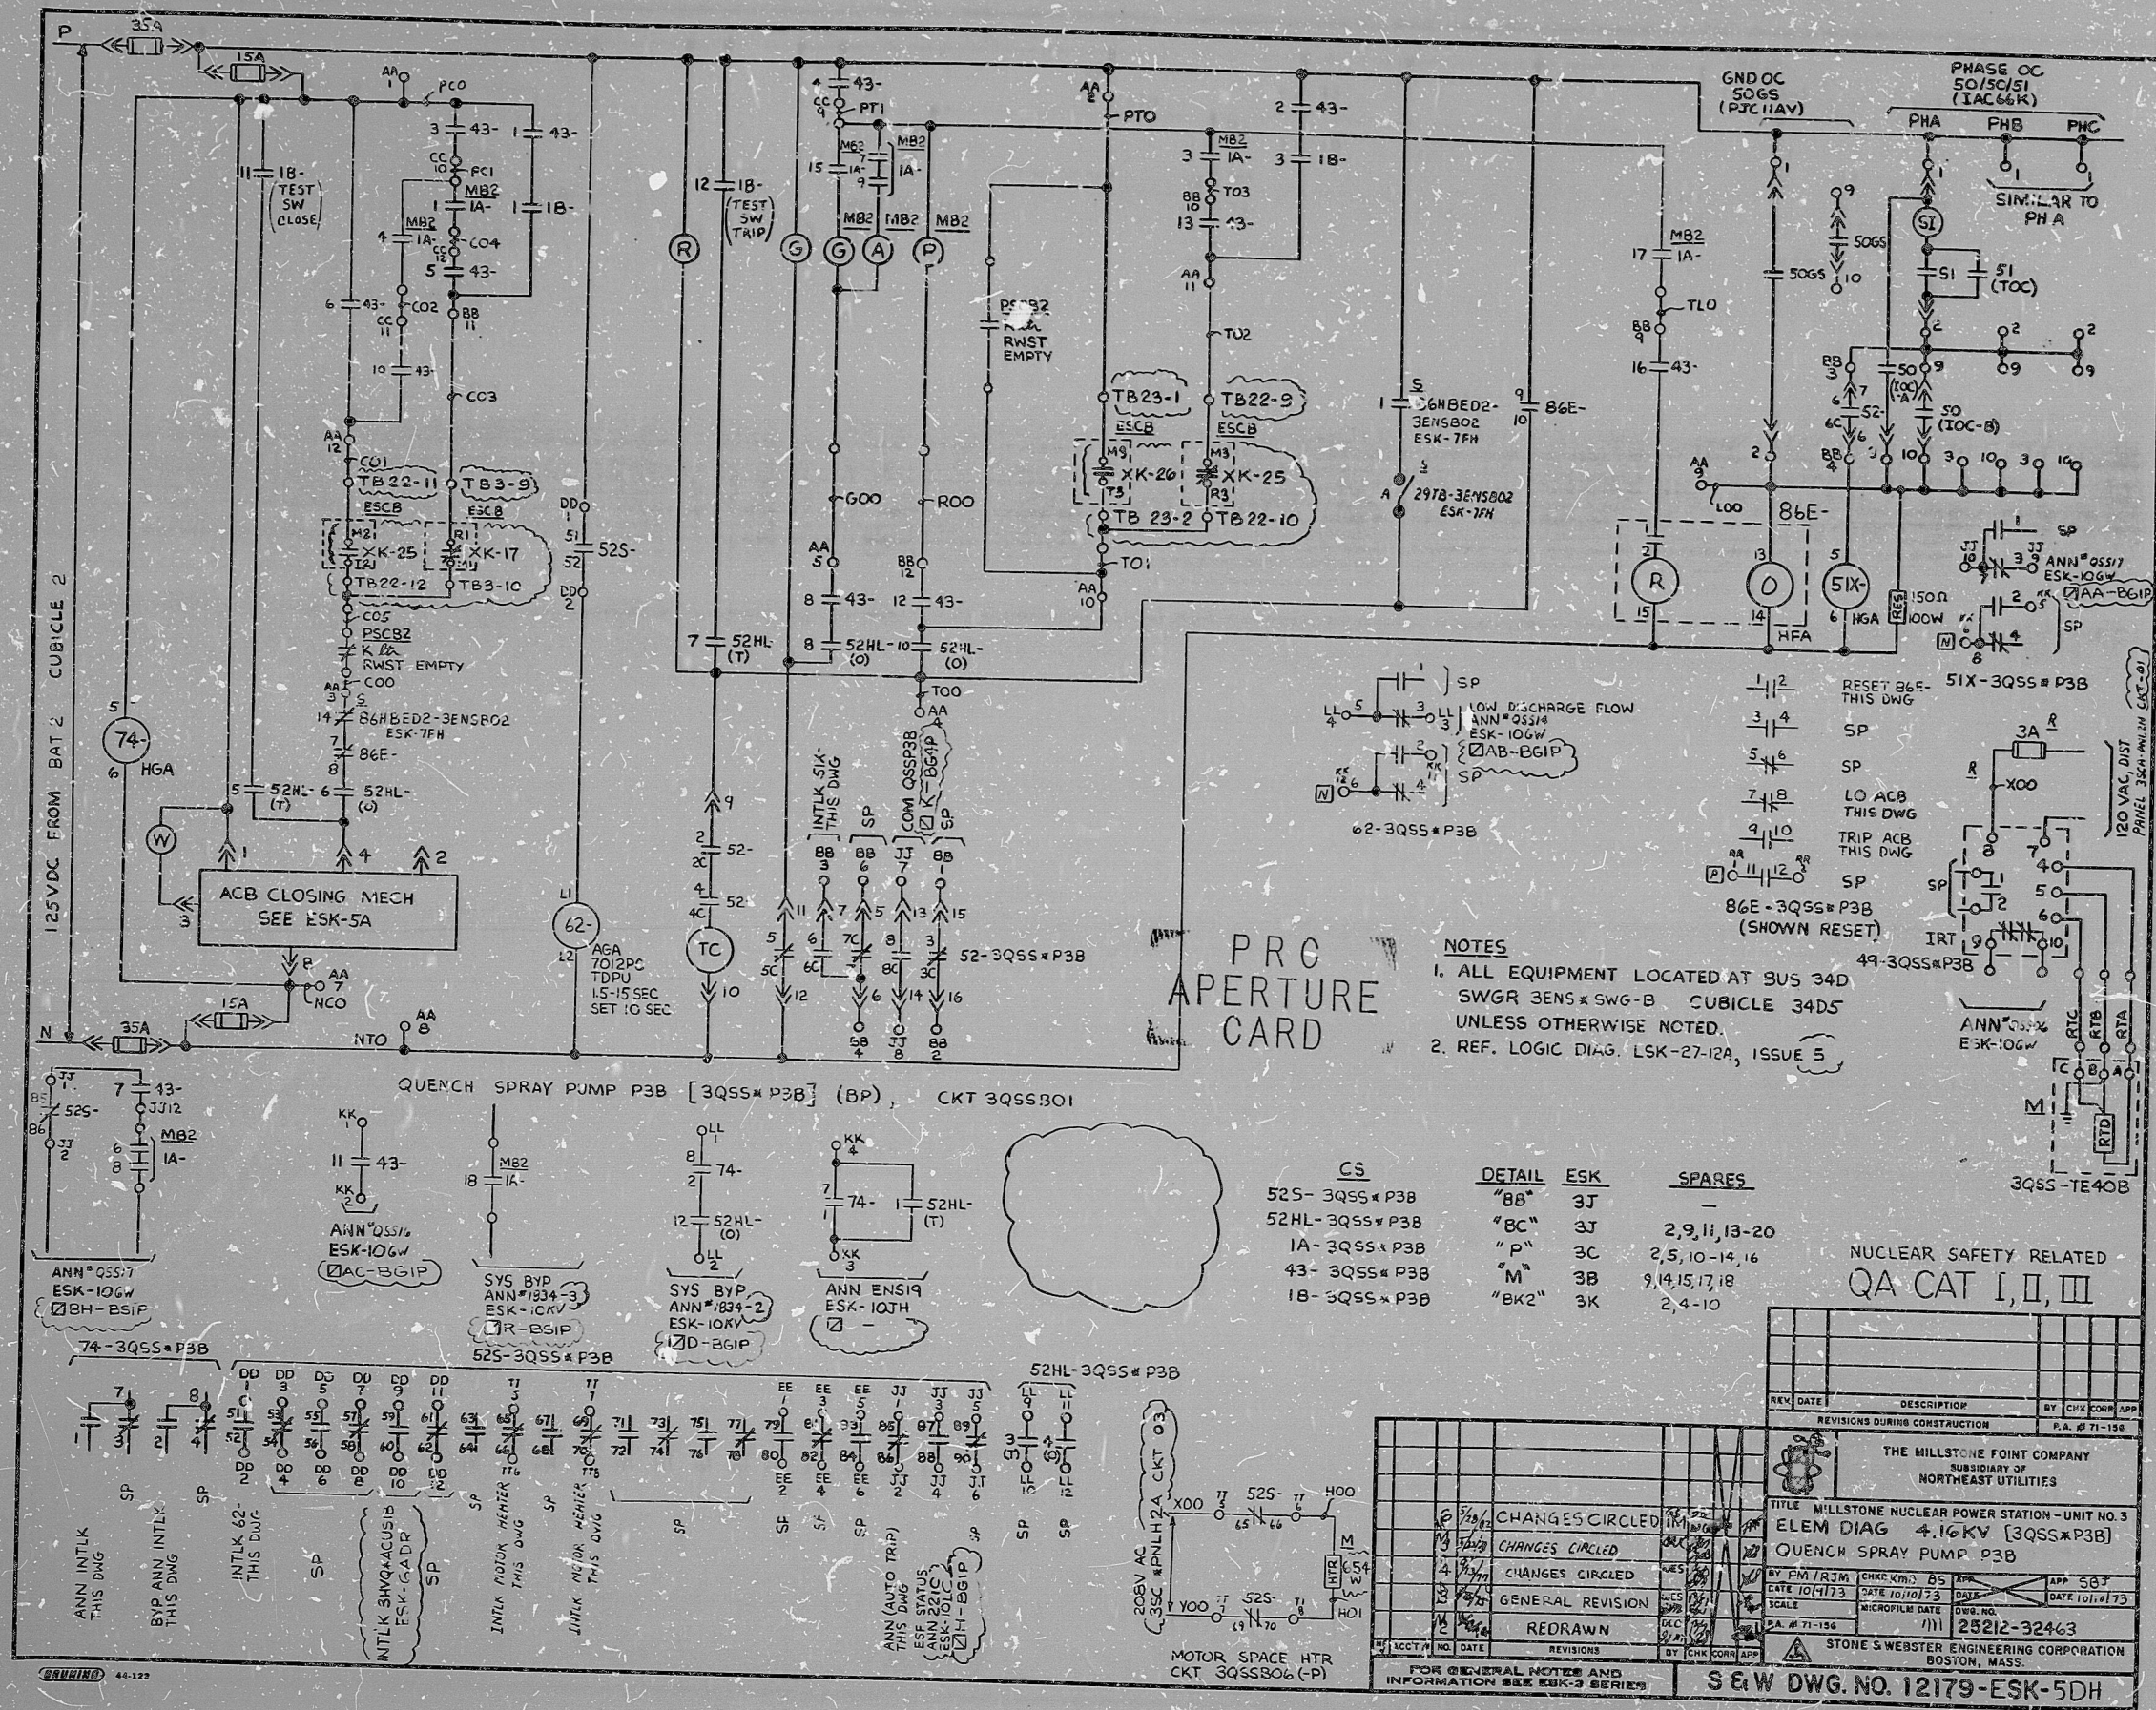

PRC
APERTURE
CARD

- NOTES
1. ALL EQUIPMENT LOCATED AT BUS 34D SWGR 3ENS* SWG-B CUBICLE 34D5 UNLESS OTHERWISE NOTED.
 2. REF. LOGIC DIAG. LSK-27-12A, ISSUE 5

CS	DETAIL	ESK	SPARES
52S- 3QSS*P3B	"BB"	3J	-
52HL- 3QSS*P3B	"BC"	3J	2,9,11,13-20
1A- 3QSS*P3B	"P"	3C	2,5,10-14,16
43- 3QSS*P3B	"M"	3B	9,14,15,17,18
1B- 3QSS*P3B	"BK2"	3K	2,4-10

NUCLEAR SAFETY RELATED
QA CAT I, II, III

REV	DATE	DESCRIPTION	BY	CHK	APP

FOR GENERAL NOTES AND INFORMATION SEE ESK-2 SERIES

STONE & WEBSTER ENGINEERING CORPORATION
BOSTON, MASS.

S & W DWG. NO. 12179-ESK-5DH

Rids

8212160450

