


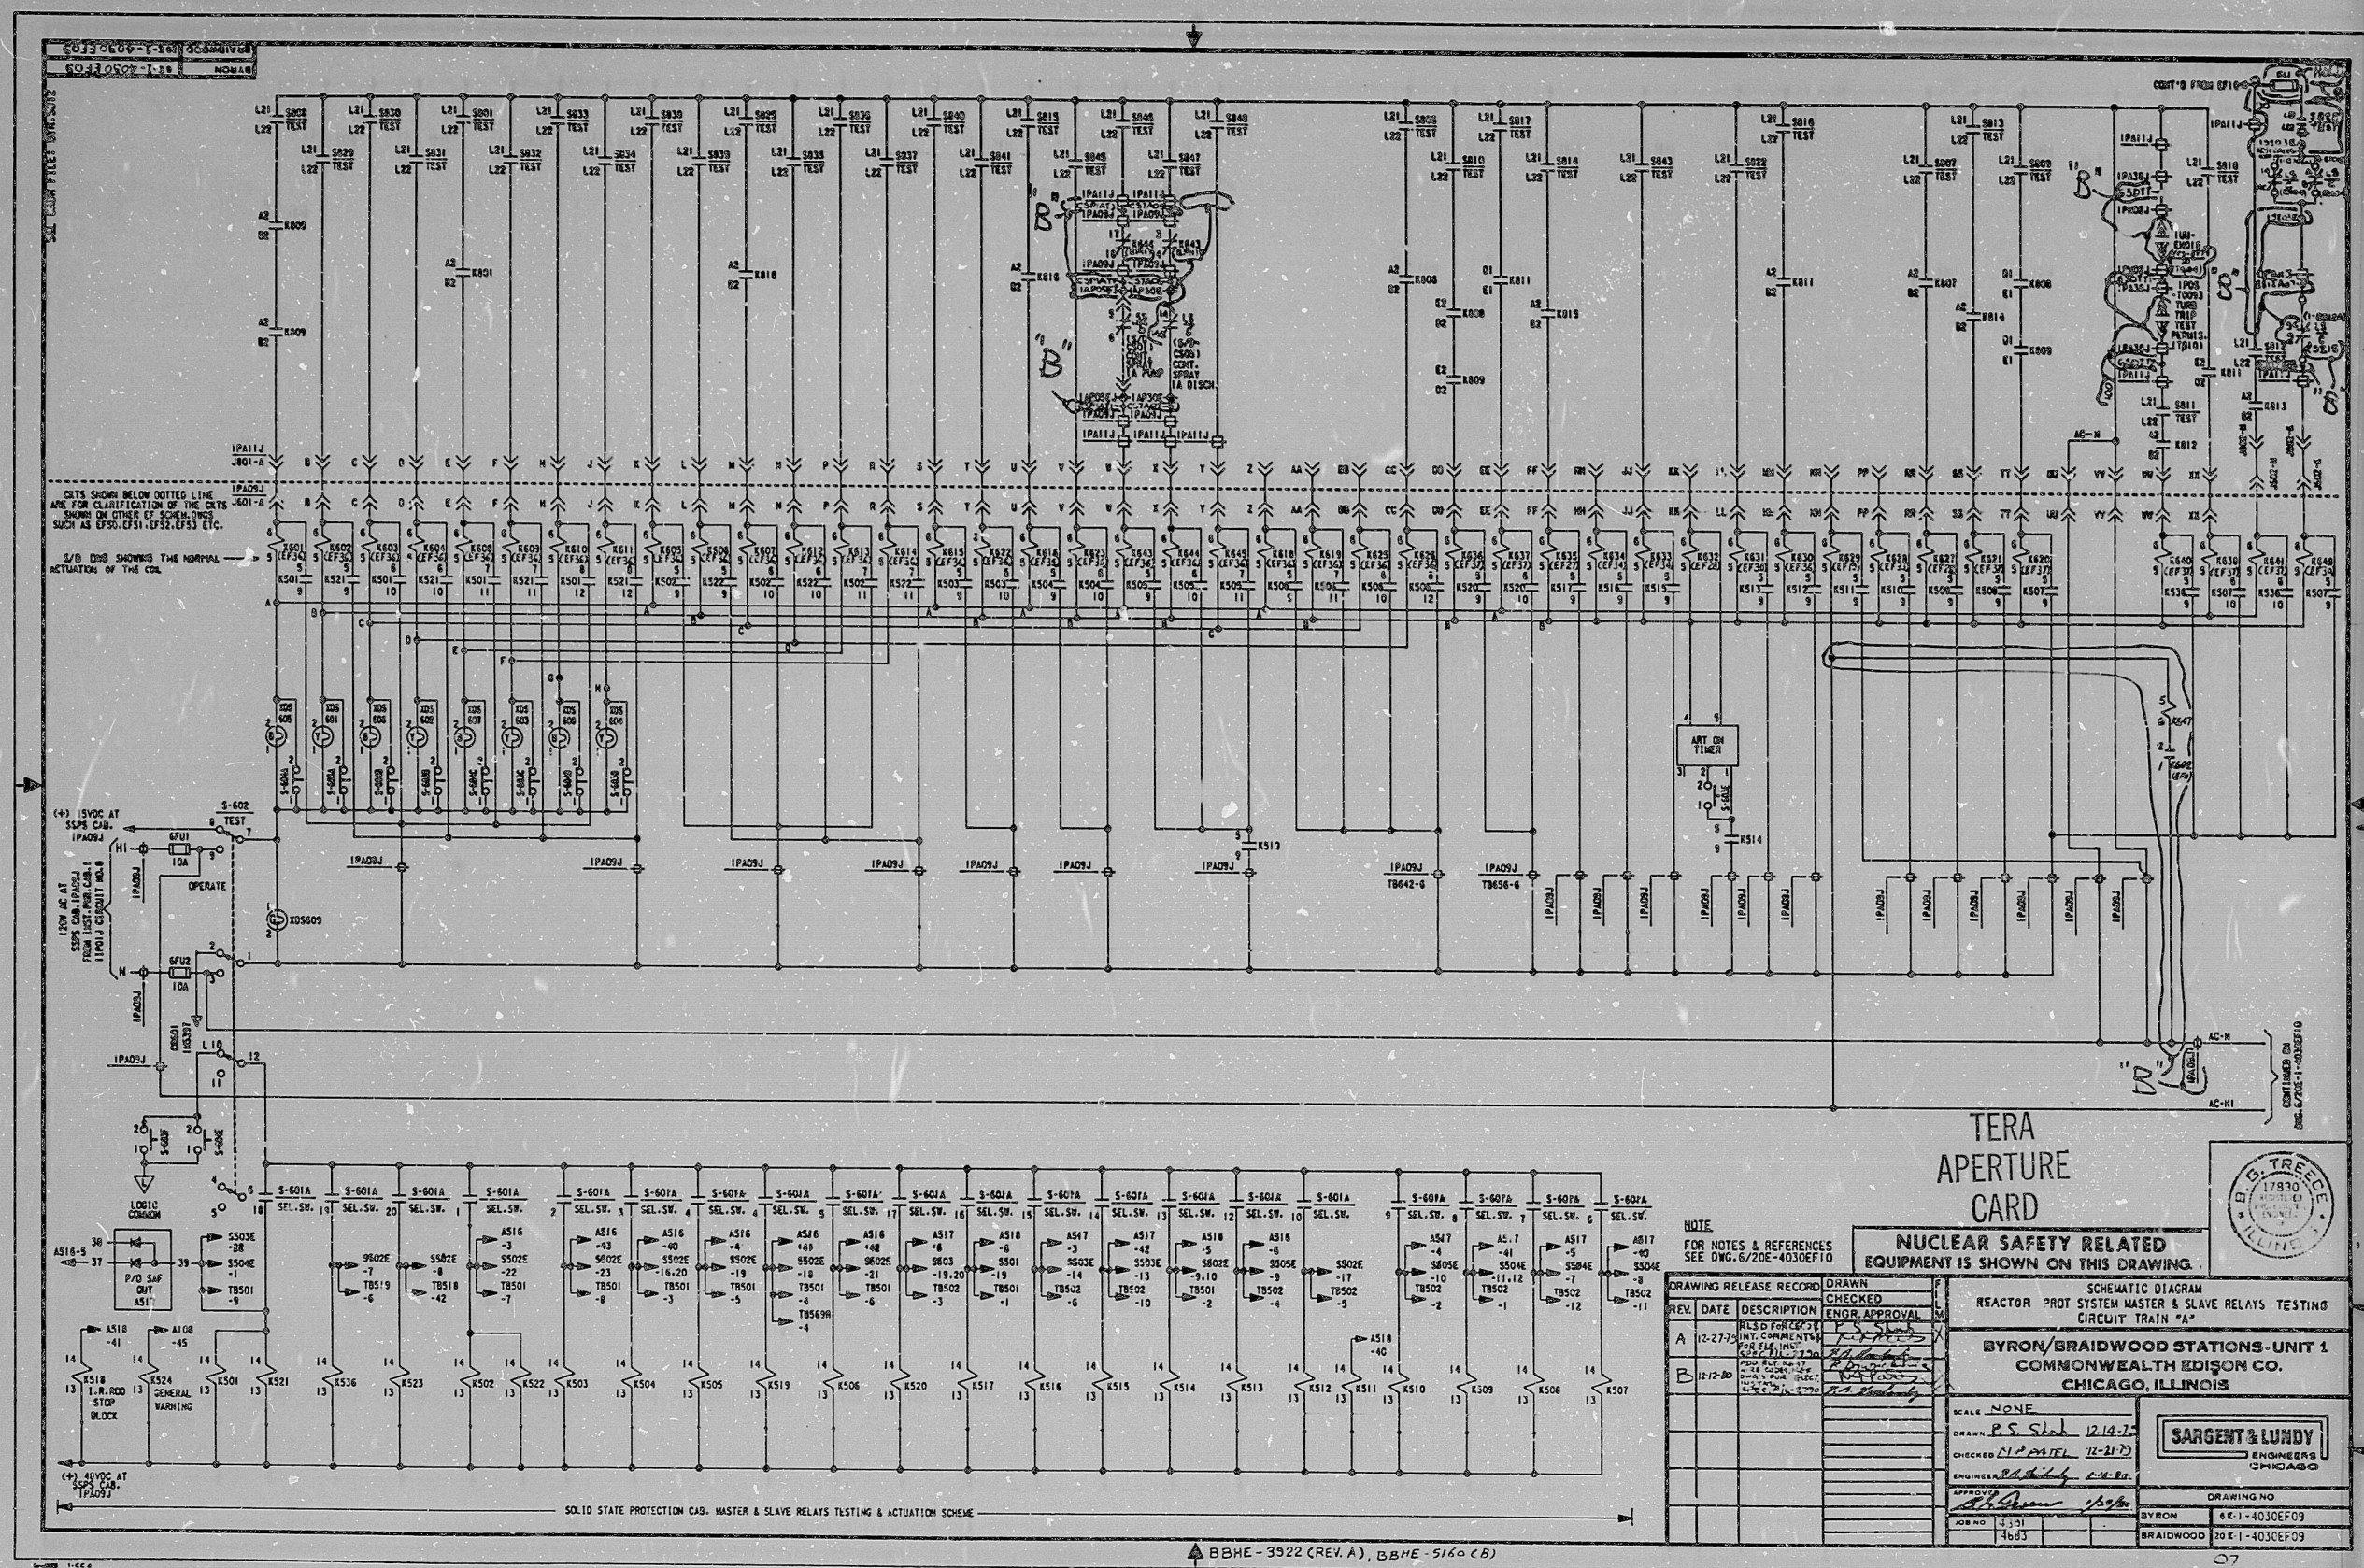

RIDS

8107060538

