


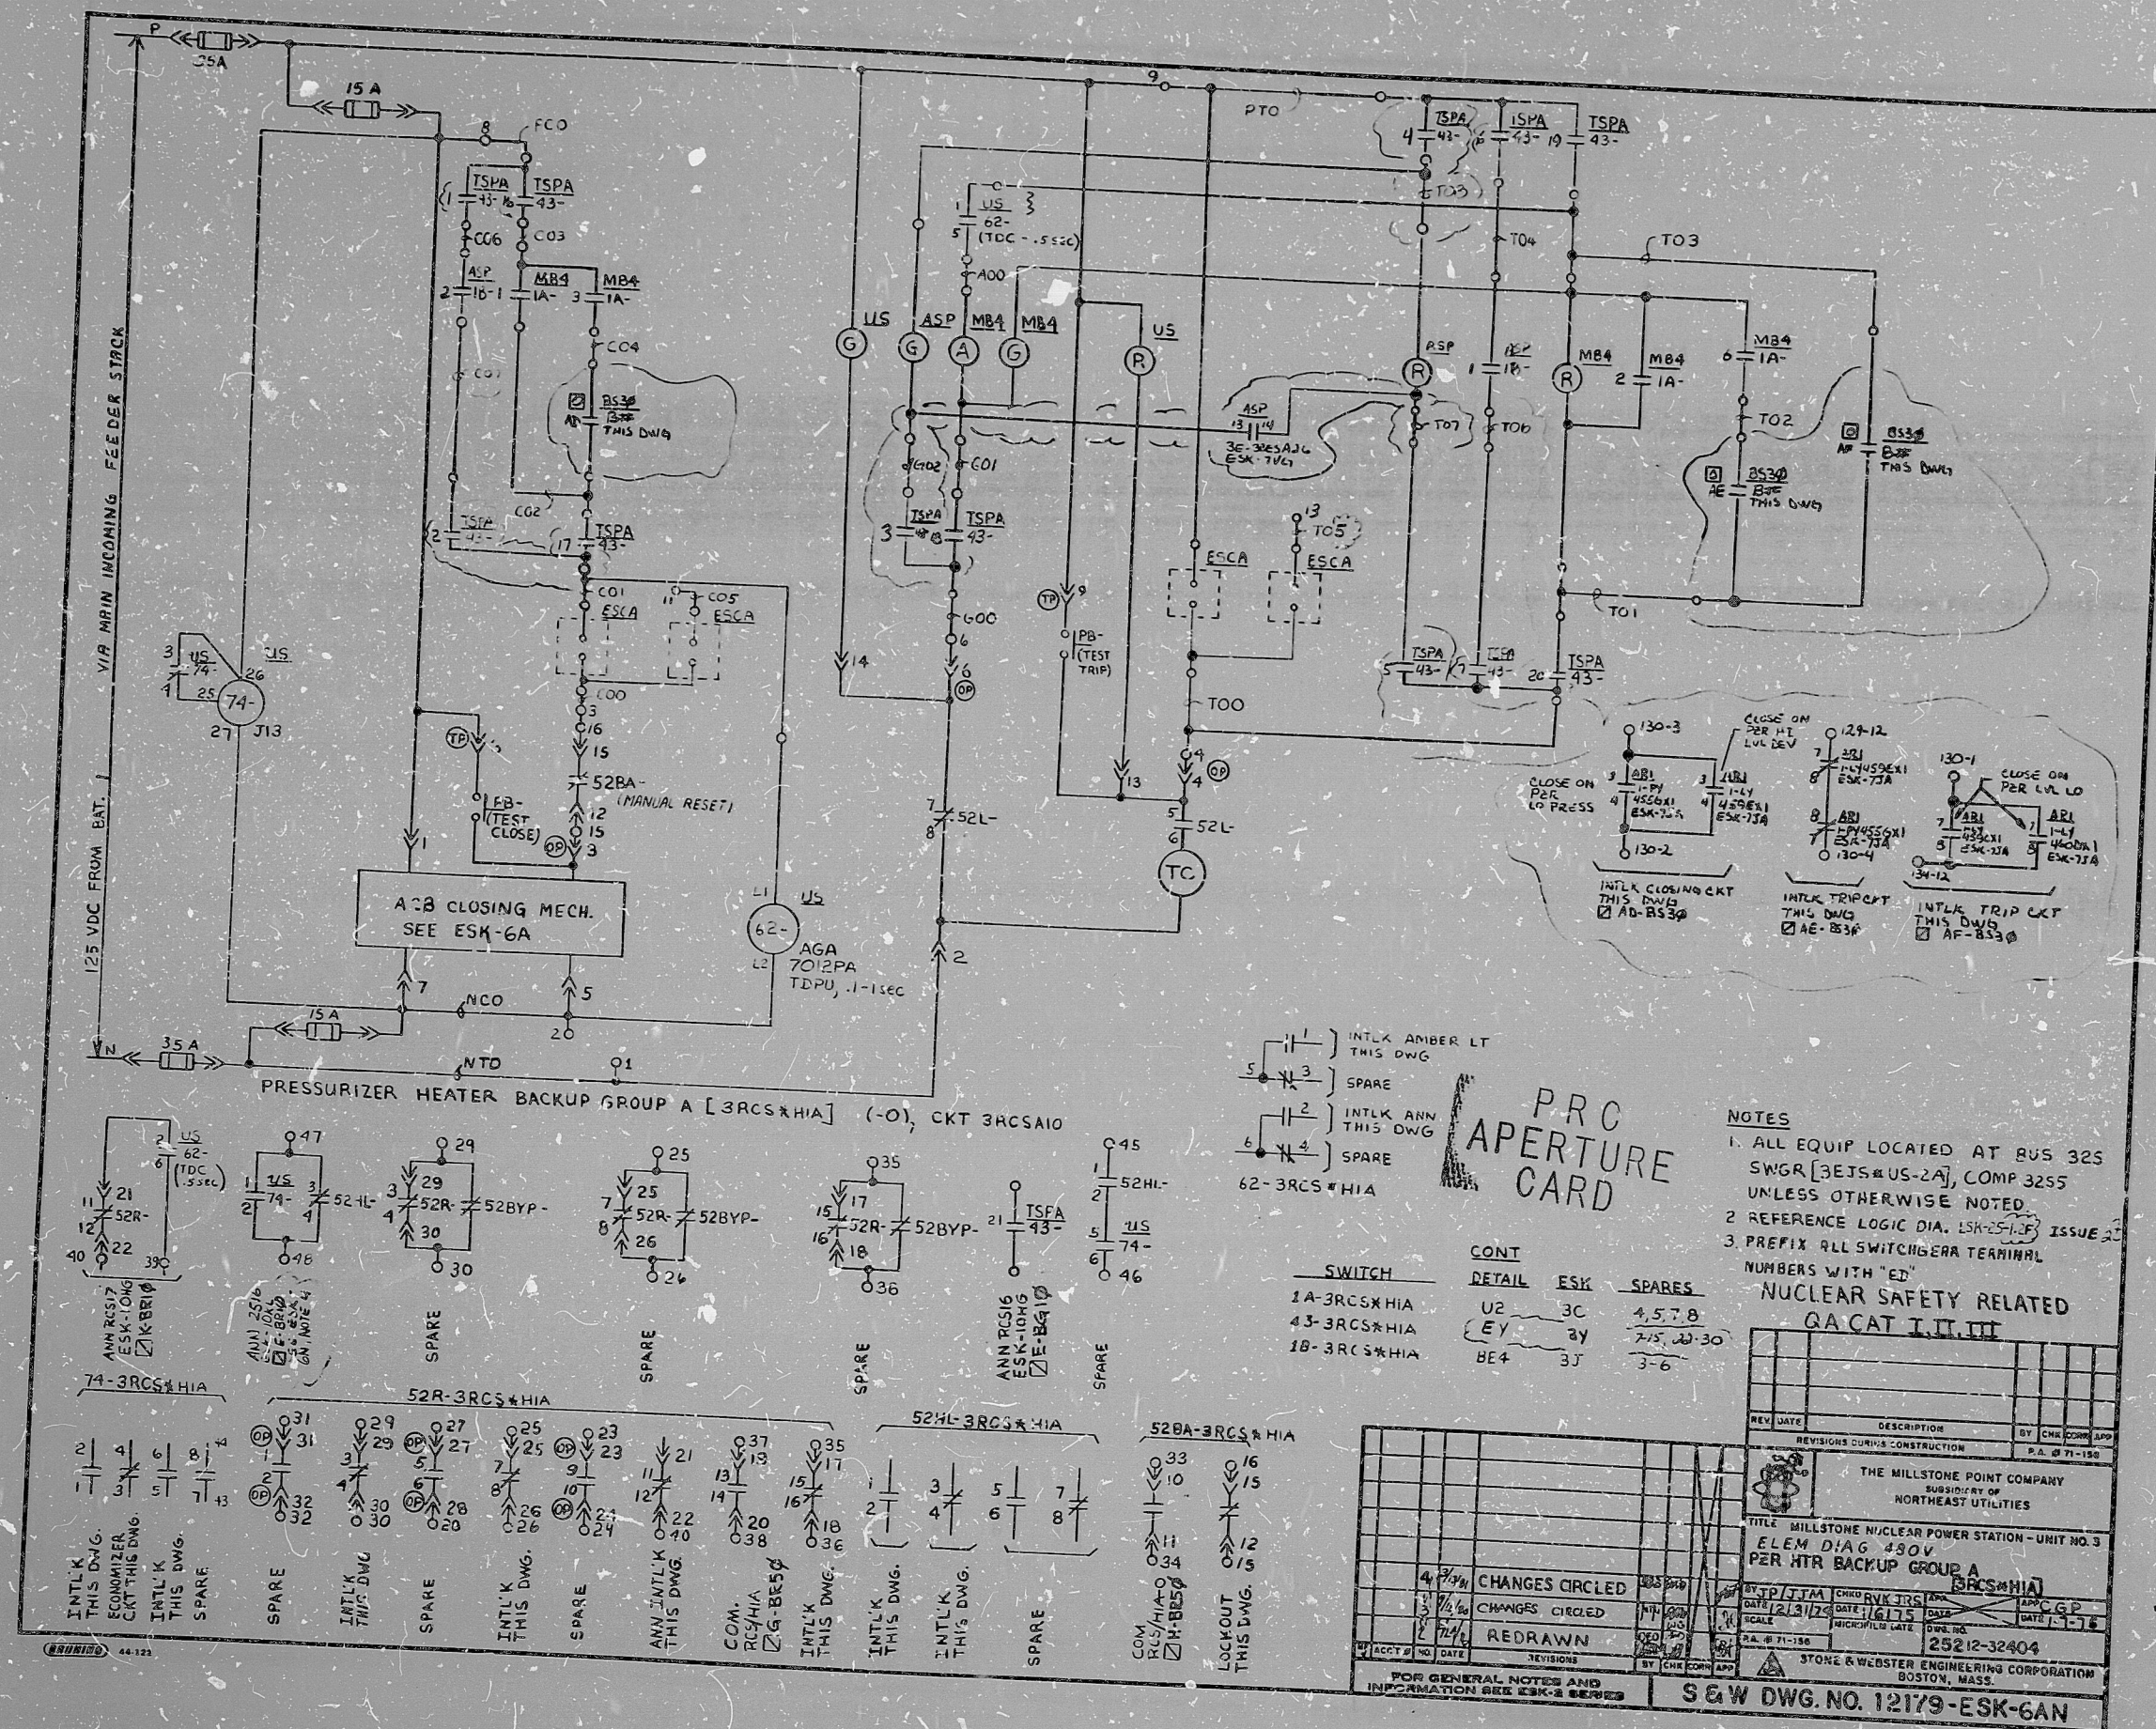

Rids

8212160472

