


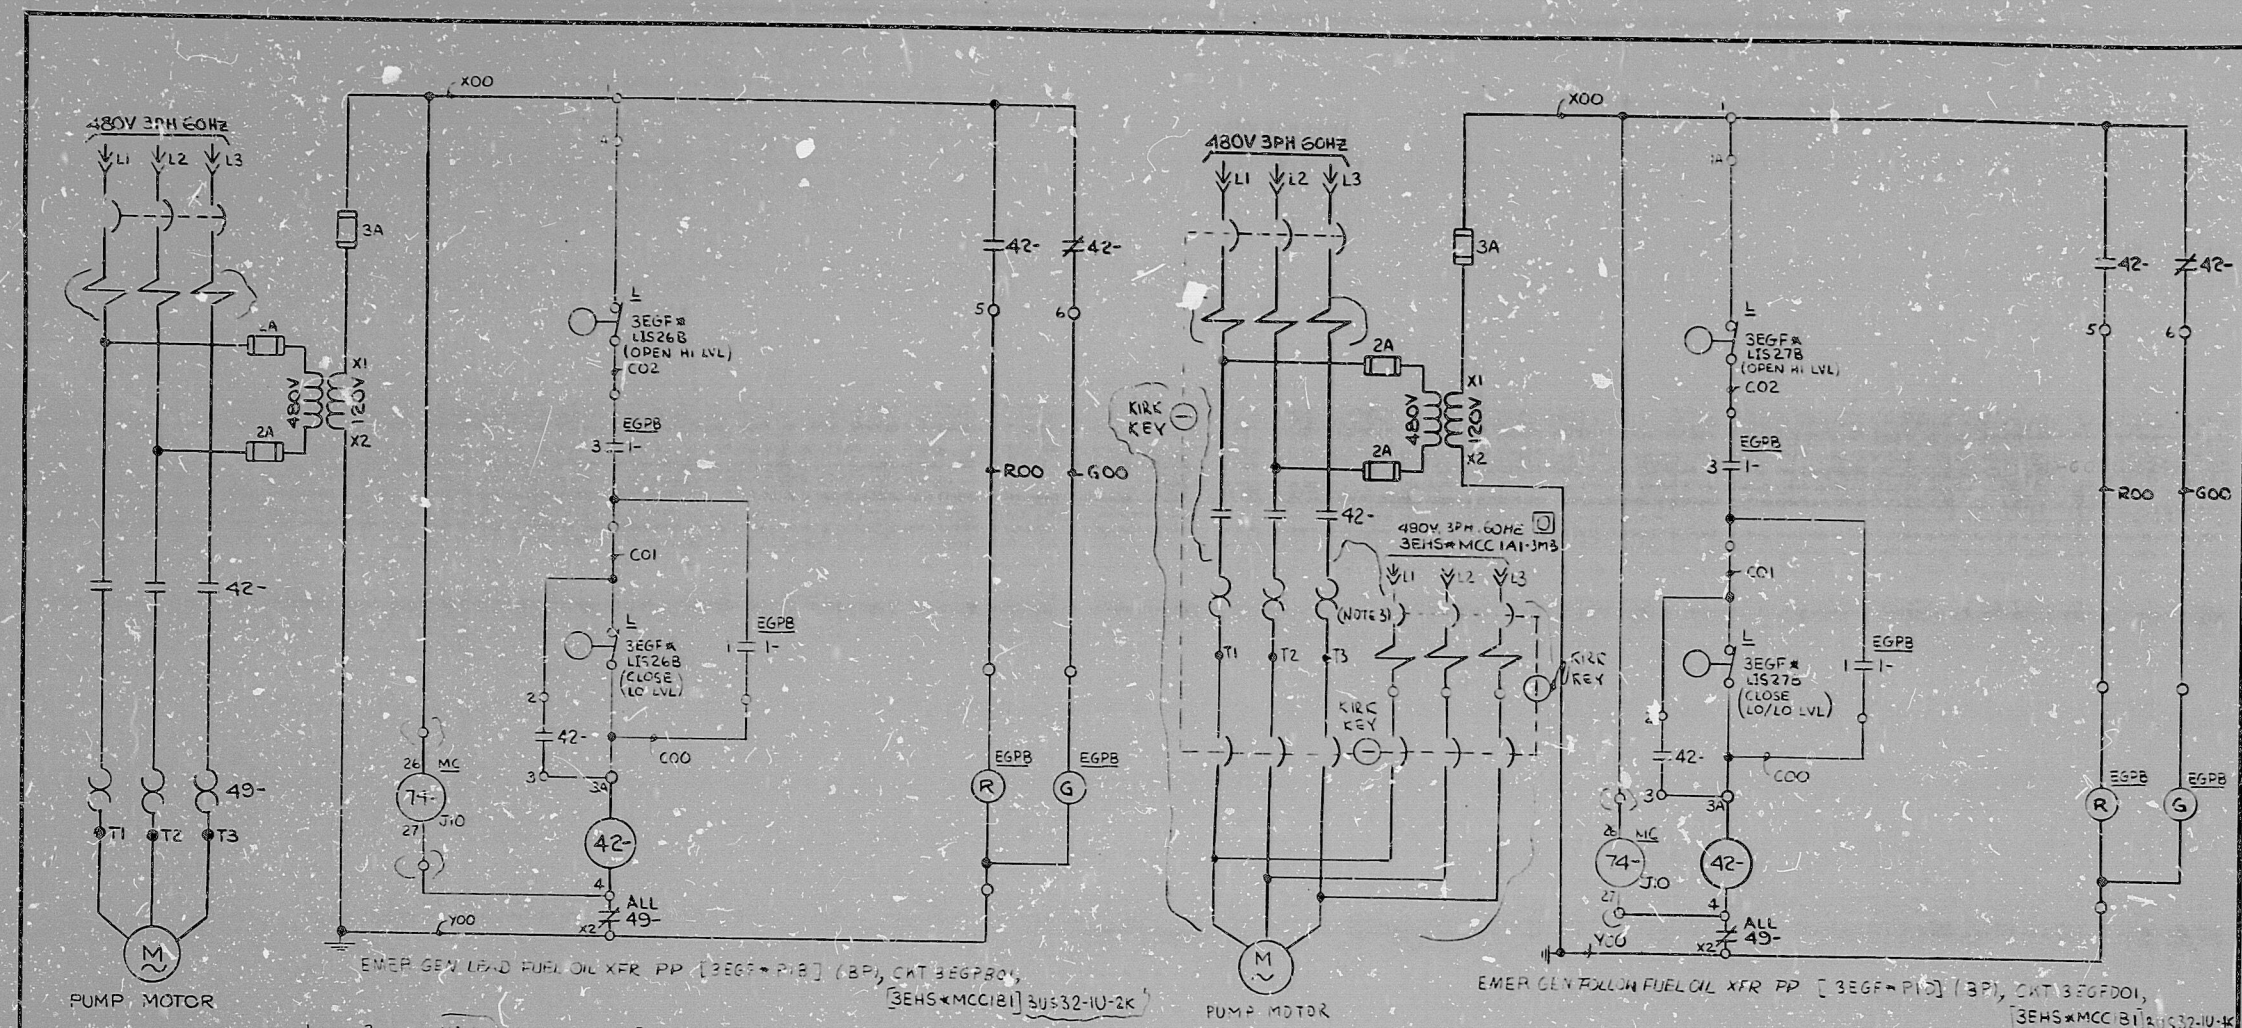

PRC
APERTURE
CARD

NUCLEAR SAFETY RELATED
QA CAT I, II, III

- NOTES:
1. ALL EQUIPMENT LOCATED AT MC UNLESS OTHERWISE NOTED
 2. REF LOGIC DIAG (LSK-8-9A, ISSUES)
 3. PP MOTOR IS ADMINISTRATIVELY CONTROLLED BY CRT DRR

CS	DIAG	ESK	SPARES
1-3EGF#PIB	DJ	3R	2 4-8
1-3EGF#PID	DJ	3R	2, 4-8

REV	DATE	DESCRIPTION	BY	CHK	APP
1	12/1/79	REVISIONS DURING CONSTRUCTION			

THE MILLSTONE POINT COMPANY	
BURLINGTON OF NORTHEAST UTILITIES	
TITLE: MILLSTONE NUCLEAR POWER STATION - UNIT NO. 3	
ELEM DIAG 480V MC	
EMER GEN FUEL OIL XFR PPS [3EGF#PIB,D]	
BY: [Signature]	DATE: 12/1/79
CHKD: [Signature]	DATE: 12/1/79
APP: [Signature]	DATE: 12/1/79
SCALE: 1"=10'	DWG. NO. 25212-32143
STONE & WEBSTER ENGINEERING CORPORATION, BOSTON, MASS.	

UNION 44-122

S & W DWG. NO. 12179-ESK-6DY

Bids

8212160494

