


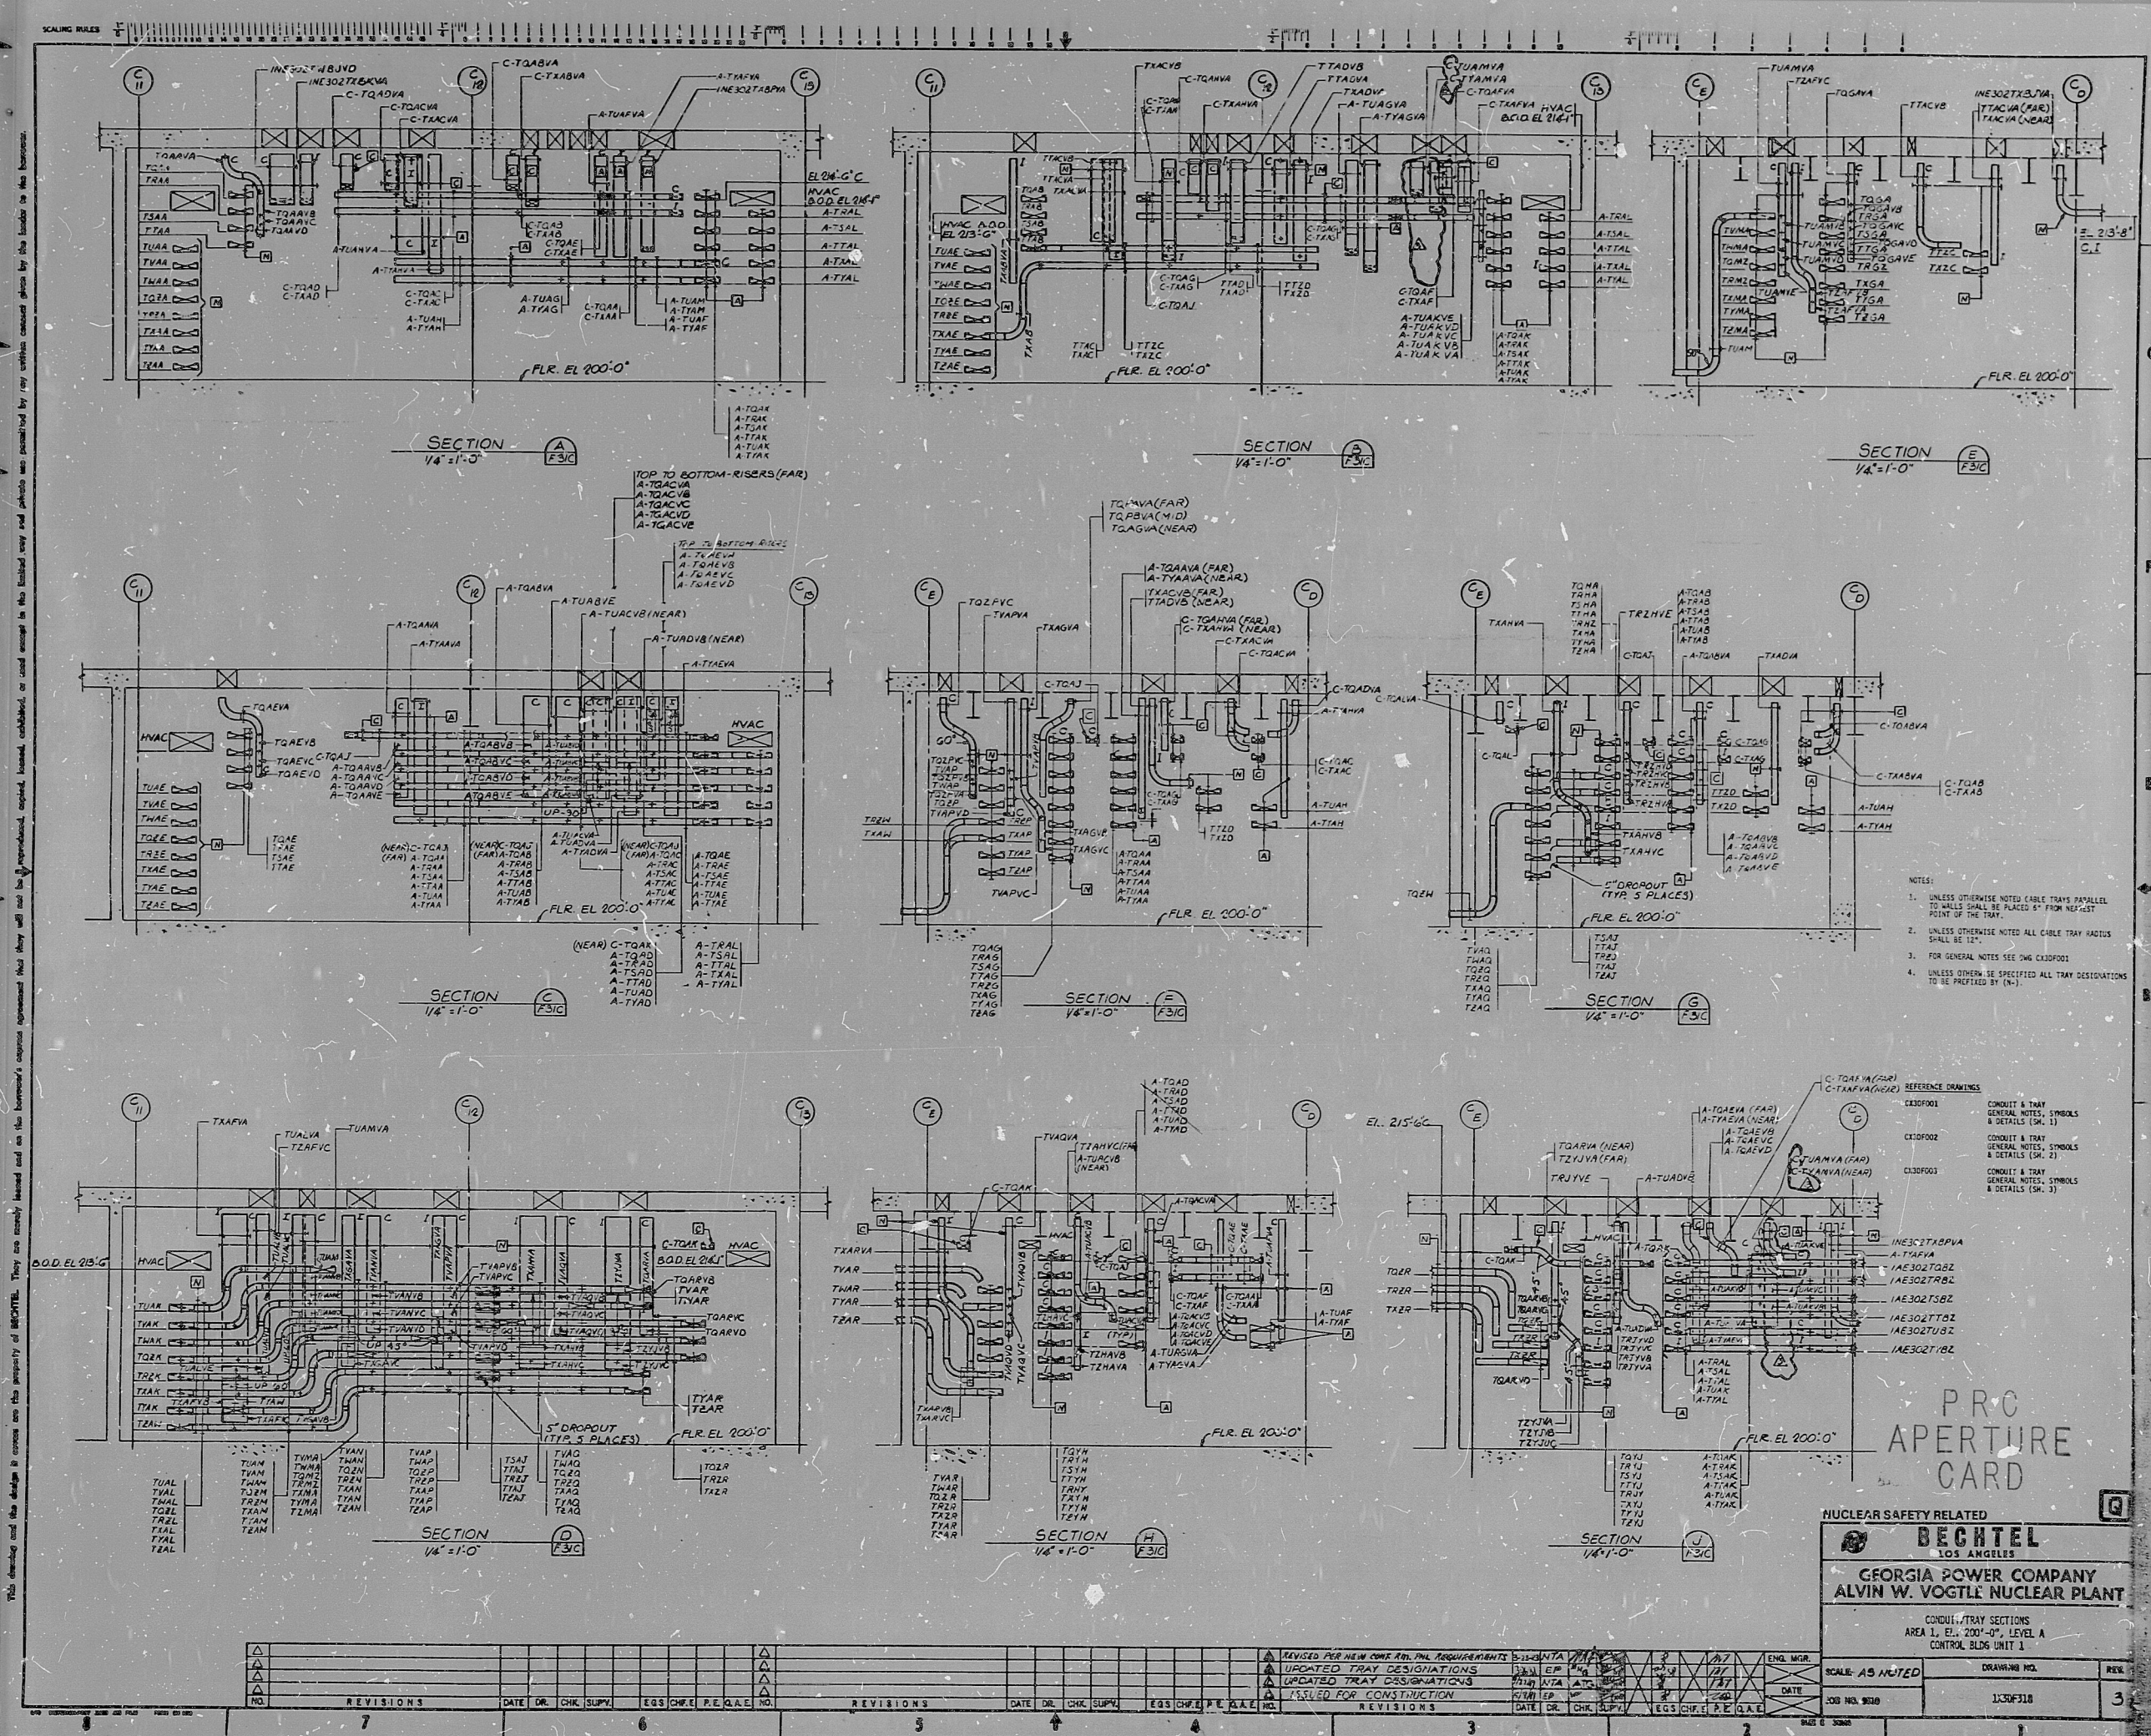

This drawing and the design it contains are the property of BECHTEL. They are hereby loaned to you on the borrower's express representation that they will not be reproduced, copied, loaned, exhibited, or used except in the limited way and within the limits set forth in the loan agreement.

PRC
APERTURE
CARD

NUCLEAR SAFETY RELATED
BECHTEL
LOS ANGELES
GEORGIA POWER COMPANY
ALVIN W. VOGTLE NUCLEAR PLANT

CONDUIT & TRAY SECTIONS
AREA 1, EL. 200'-0" LEVEL, A
CONTROL BLDG UNIT 1

REVISIONS				REVISIONS				REVISIONS				REVISIONS			
NO.	REVISIONS	DATE	DR. CHK. SUPV.	NO.	REVISIONS	DATE	DR. CHK. SUPV.	NO.	REVISIONS	DATE	DR. CHK. SUPV.	NO.	REVISIONS	DATE	DR. CHK. SUPV.
1	REVISED PER NEW CON. REQ. FOR REQUIREMENTS	11/14/78	EP	


SCALE: AS NOTED
DRAWING NO. 1130F318
REV. 3

RIDS

8310060144

