

11

11

8.5

8.5

11

17

11

11

8.5

8.5

11




















17





 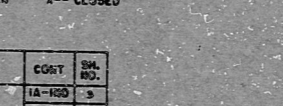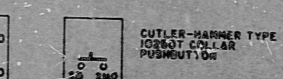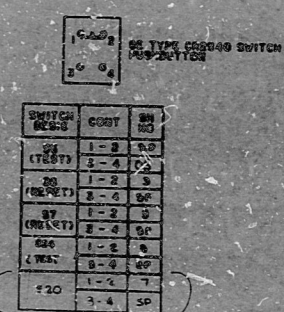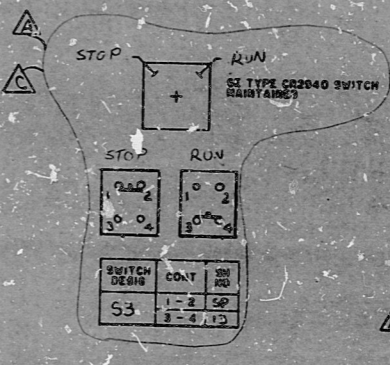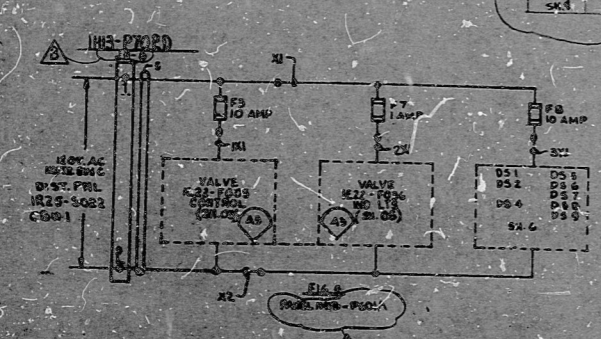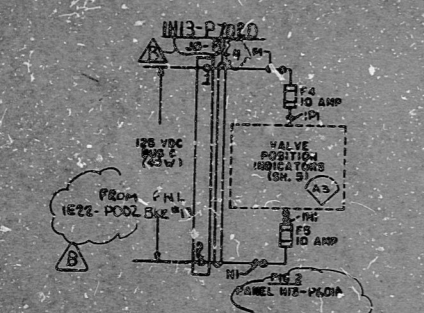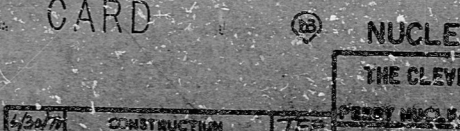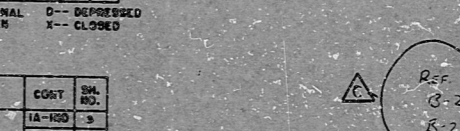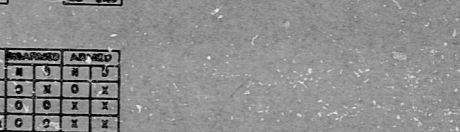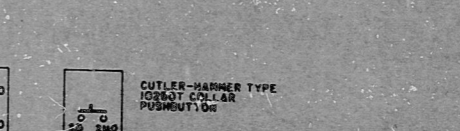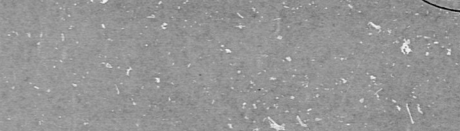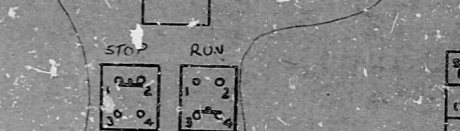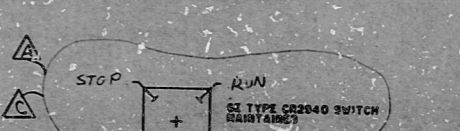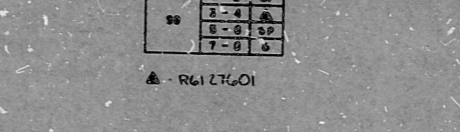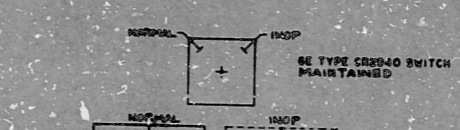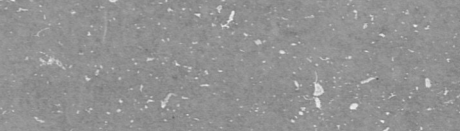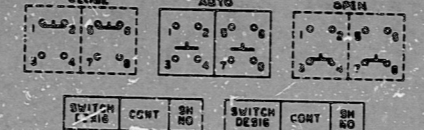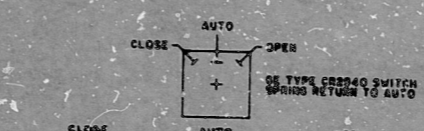

PRC APERTURE CARD

REF: 8-21-1065 SH-15 BLOCK DIAGRAM  
8-21-209 SH-19 BLOCK DIAGRAM

NUCLEAR SAFETY RELATED

THE CLEVELAND ELECTRIC ILLUMINATING CO.

CONSTRUCTION

DATE

REVISIONS

ENGINEERS AND CHECKERS

DATE

REVISIONS

DATE

REVISIONS

ADDED WFO CIRCUITRY PER GE DATA SHEET	REVISED SH-15 SH-19 REV. PANEL; ADDED REFERENCES REL. WINDING SS, AS PER GE BLOCK DIAG.	ADDED FITS INFORMATION CHANGED JUNC BOXES	REVISED RELAY TABULATIONS, NAMEPLATE DESIG. FOR S3, AND ADDED S30	READING	PA	CHLORNEY ASSOCIATES, INC.	ENGINEERS AND CHECKERS
REV. 1	REV. 2	REV. 3	REV. 4	REV. 5	REV. 6	REV. 7	REV. 8

RIPS

82L2160511

