

11

11

8.5

8.5

11

17

11


11

8.5

8.5

11

17

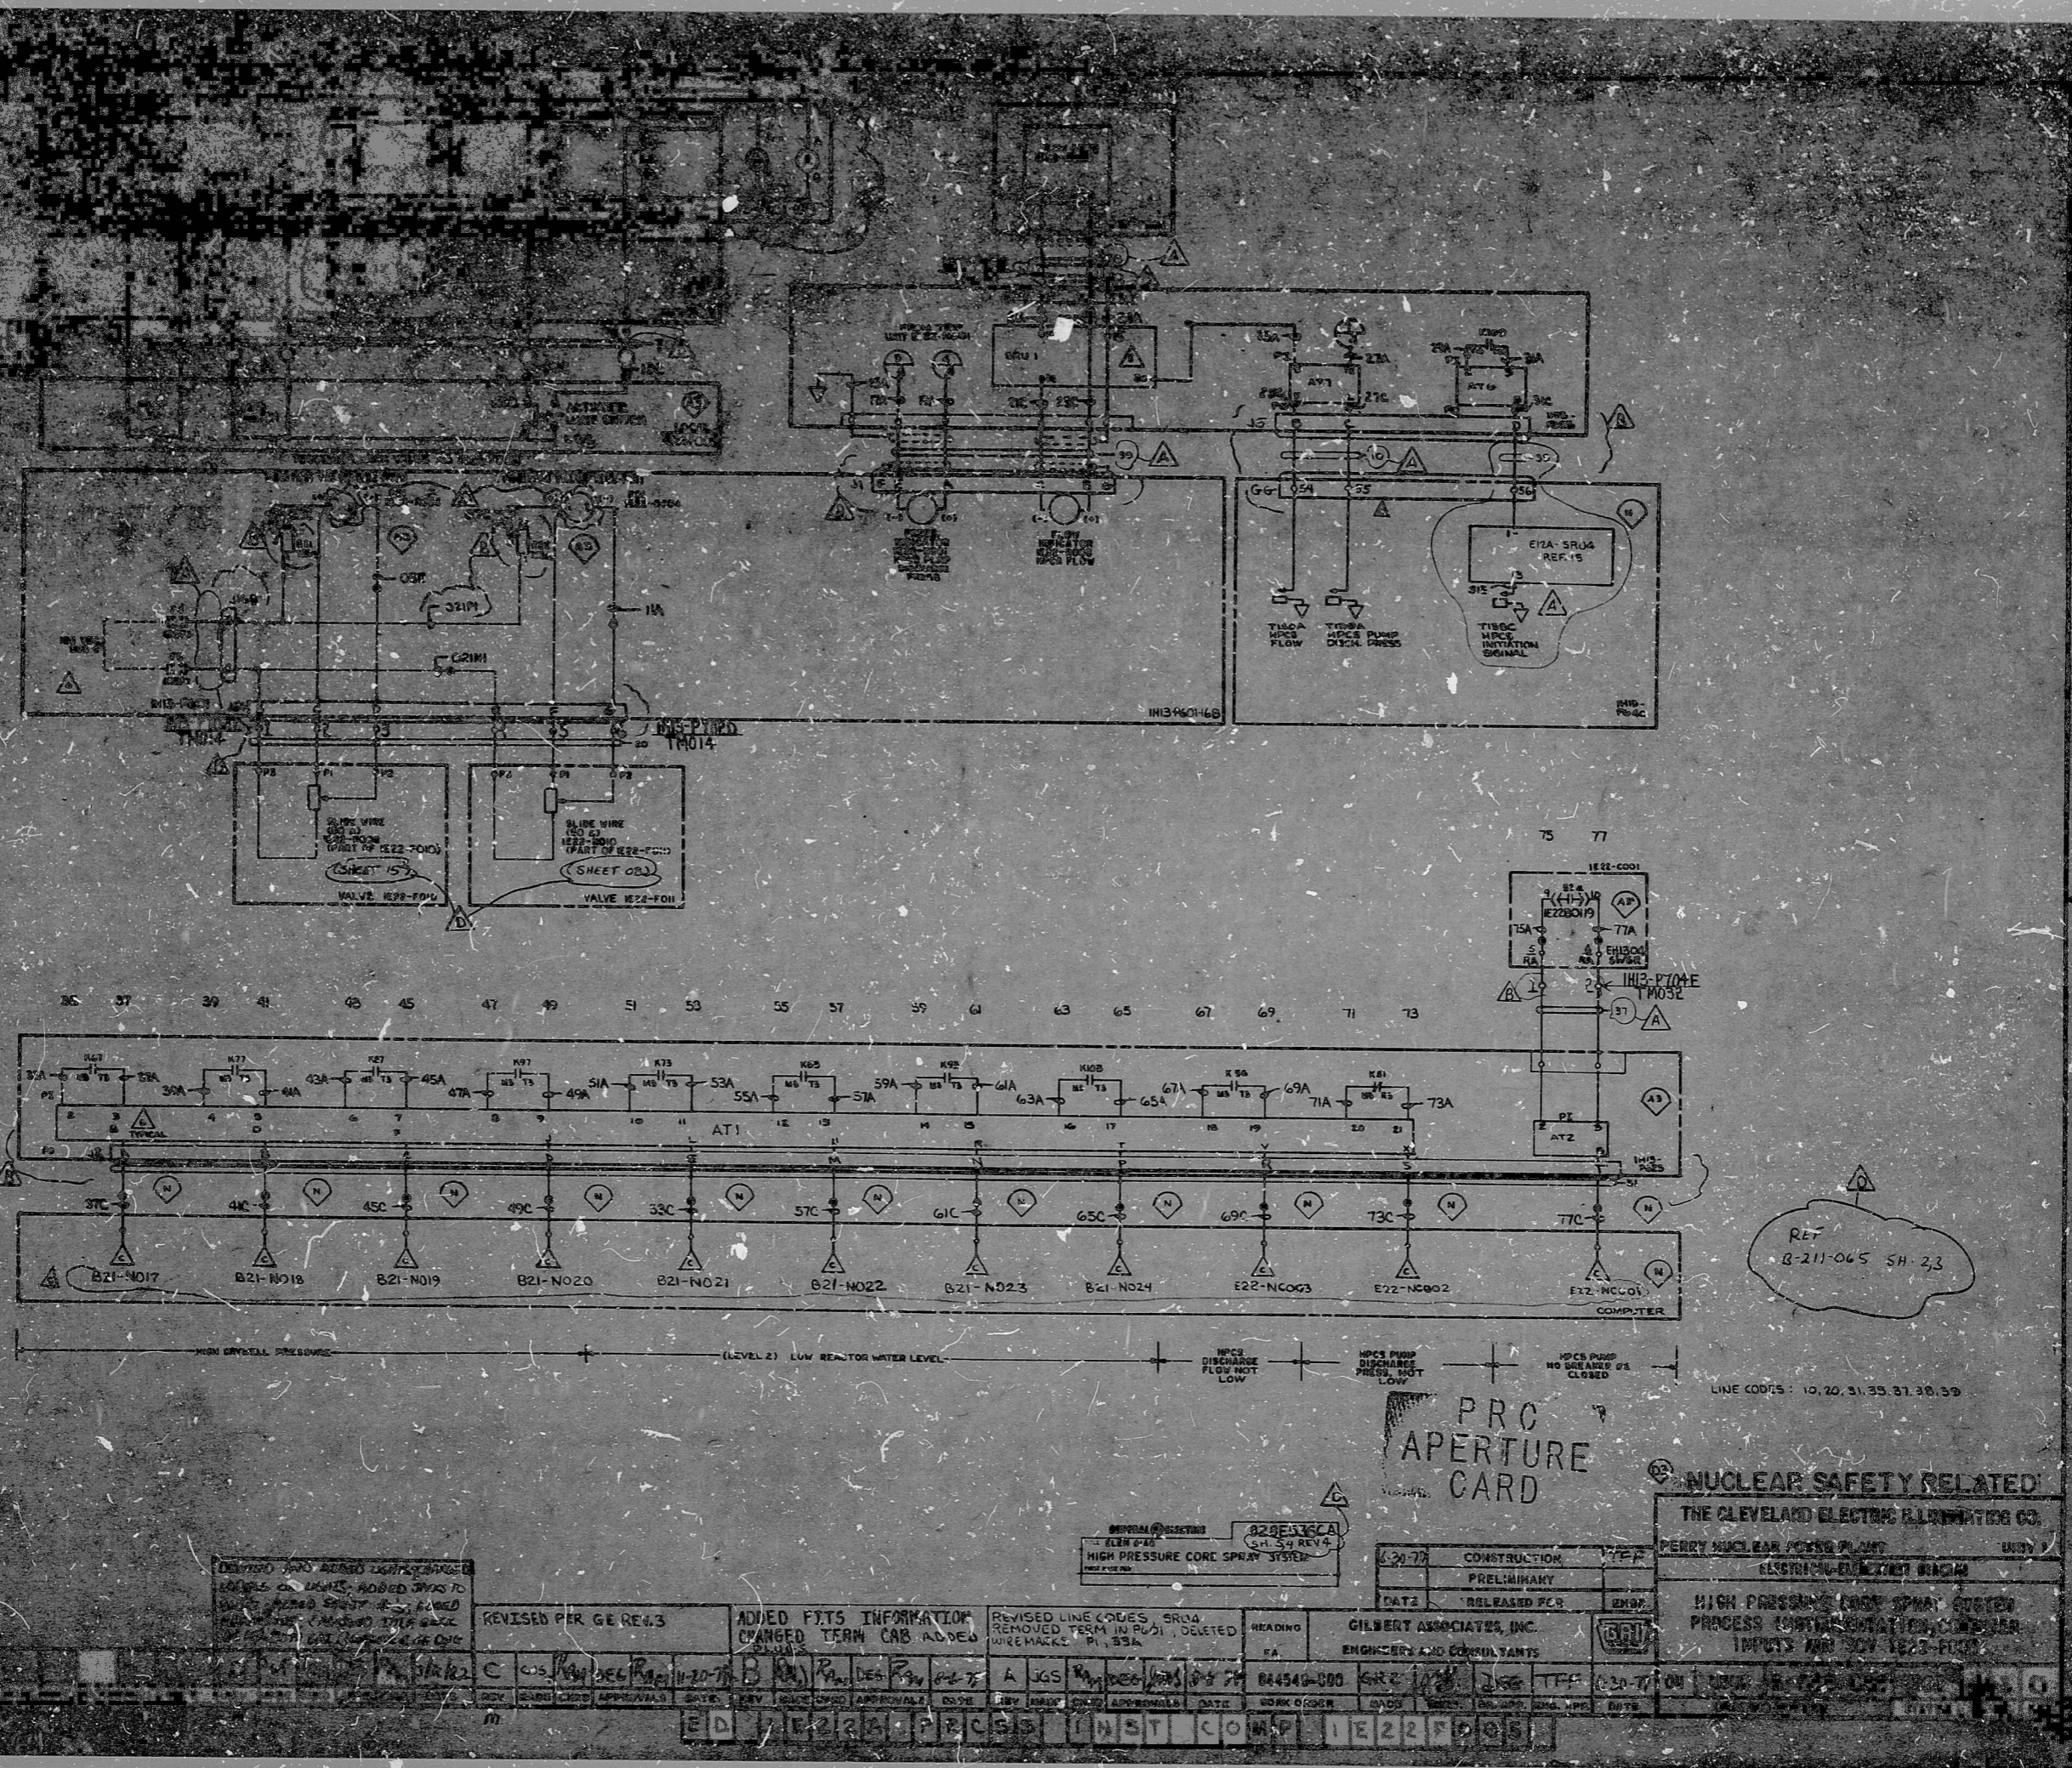

REVISIONS AND REVISIONS LISTED IN THIS COLUMN ARE UNLESS NOTED OTHERWISE. CHANGES TO THIS DRAWING SHALL BE MADE BY THE DESIGNER OR HIS AUTHORIZED REPRESENTATIVE. DATE OF REVISION SHALL BE INDICATED IN THIS COLUMN.

REVISED PER GE REV.3
 ADDED F7.5 INFORMATION
 CHANGED TERM CAB. NODES

REVISED LINE CODES, SR14
 REMOVED TERM IN PLUS 1, DELETED
 WIRE MARCH, PL. 33A

READING
 FA

GILBERT ASSOCIATES, INC.
 ENGINEERS AND CONSULTANTS

REV	DATE	BY	CHKD	APP'D	DATE	REV	DATE	BY	CHKD	APP'D	DATE	REV	DATE	BY	CHKD	APP'D	DATE
C	11-20-77	B	R	DES	11-20-77	A	JGS	R	DES	11-20-77	A	JGS	R	DES	11-20-77	A	JGS

ED / E22A / PRCS / INST / COMP / IE22 / P005

PRO
 APERTURE
 CARD

NUCLEAR SAFETY RELATED

THE CLEVELAND ELECTRIC ILLUMINATING CO.

PERRY NUCLEAR POWER PLANT

RESISTOR-CALCULATED WINDING

HIGH PRESSURE CORE SPRAY SYSTEM

PROCESS REPRESENTATION COMPUTER

IMPACTS AND 10V IE22-P005

REF
 8-211-065 SH. 2,3

LINE CODES : 10, 20, 31, 35, 31, 30, 39

30

RIDS

82-216057

