

11

11

9.8

8.5

11

17

11


11

9.8

8.5

11

17

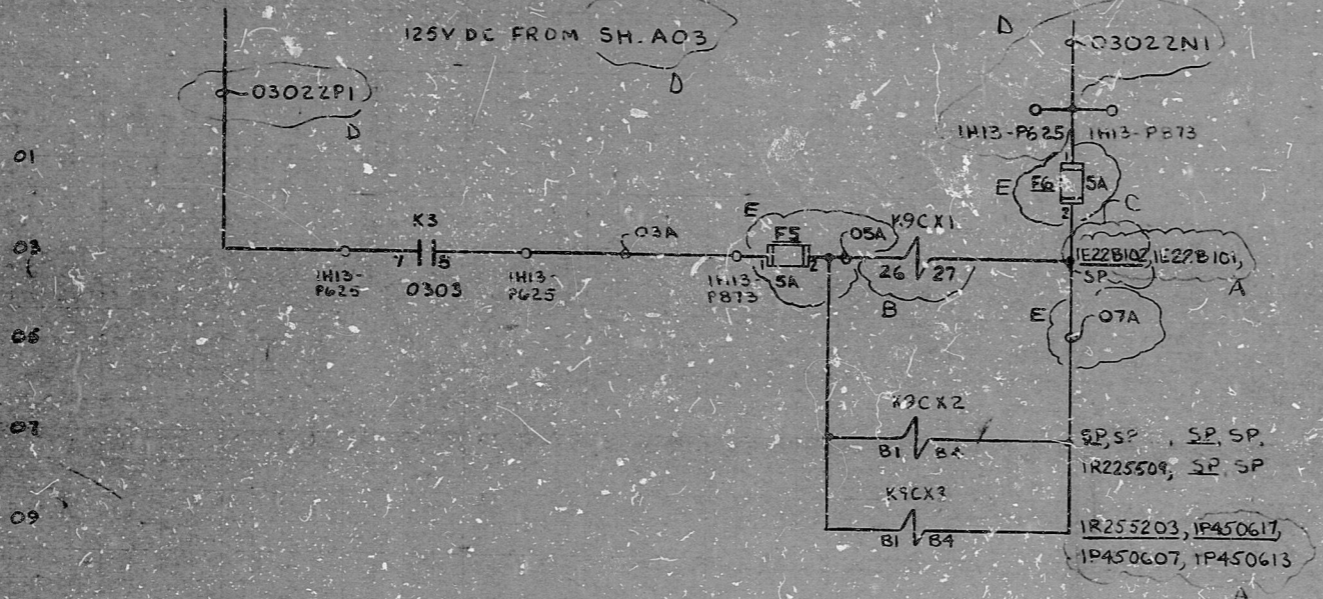

LEGEND:-

INTERNAL WIRE MARK

1H13-P673 AUXILIARY RELAY CABINET

1H13-P712 TERMINATION CABINET

1H13-P625 DIVISION 3 AUXILIARY RELAY PANEL

CLASS 1E DIVISION 3 THIS SHEET

K9CX1 - ITE/GOULD J13PA3012

K9CX2, K9CX3 - AGASTAT GPOGM

NOTES:-

1. ALL DEVICES WITHOUT LOCATION MARKS ARE LOCATED IN 1H13-P673.
2. ALPHABETICAL WIRE MARKS ARE PREFIXED BY: SUBSYSTEM NO., SHEET NO. & LINE NO. (EXAMPLE: E22A1000P).
3. POTENTIAL WIRE MARKS ARE PREFIXED BY: SUBSYSTEM NO. & SHEET NO. (EXAMPLE: E22A100P).
4. DEVICE DESIGNATIONS ARE PREFIXED BY: UNIT AND SUBSYSTEM NO. (EXAMPLE: 1E22A-K9CX1).
5. FOR GRAPHIC STANDARDS, REFER TO DRAWING 0-208-001.
6. FOR RELAY STANDARDS, REFER TO DRAWING 0-208-005.

PRC APERTURE CARD

NUCLEAR SAFETY RELATED

THE CLEVELAND ELECTRIC ILLUMINATING CO.

PERRY NUCLEAR POWER PLANT UNIT 1

ELECTRICAL-ELEMENTARY DIAGRAM

High Pressure Core Spray Sys.

LOCAL SIGNAL


ELEM DIAG COMBINED

RiDs

8212160563

