



**NUCLEAR
SAFETY RELATED
DIVISION 3**

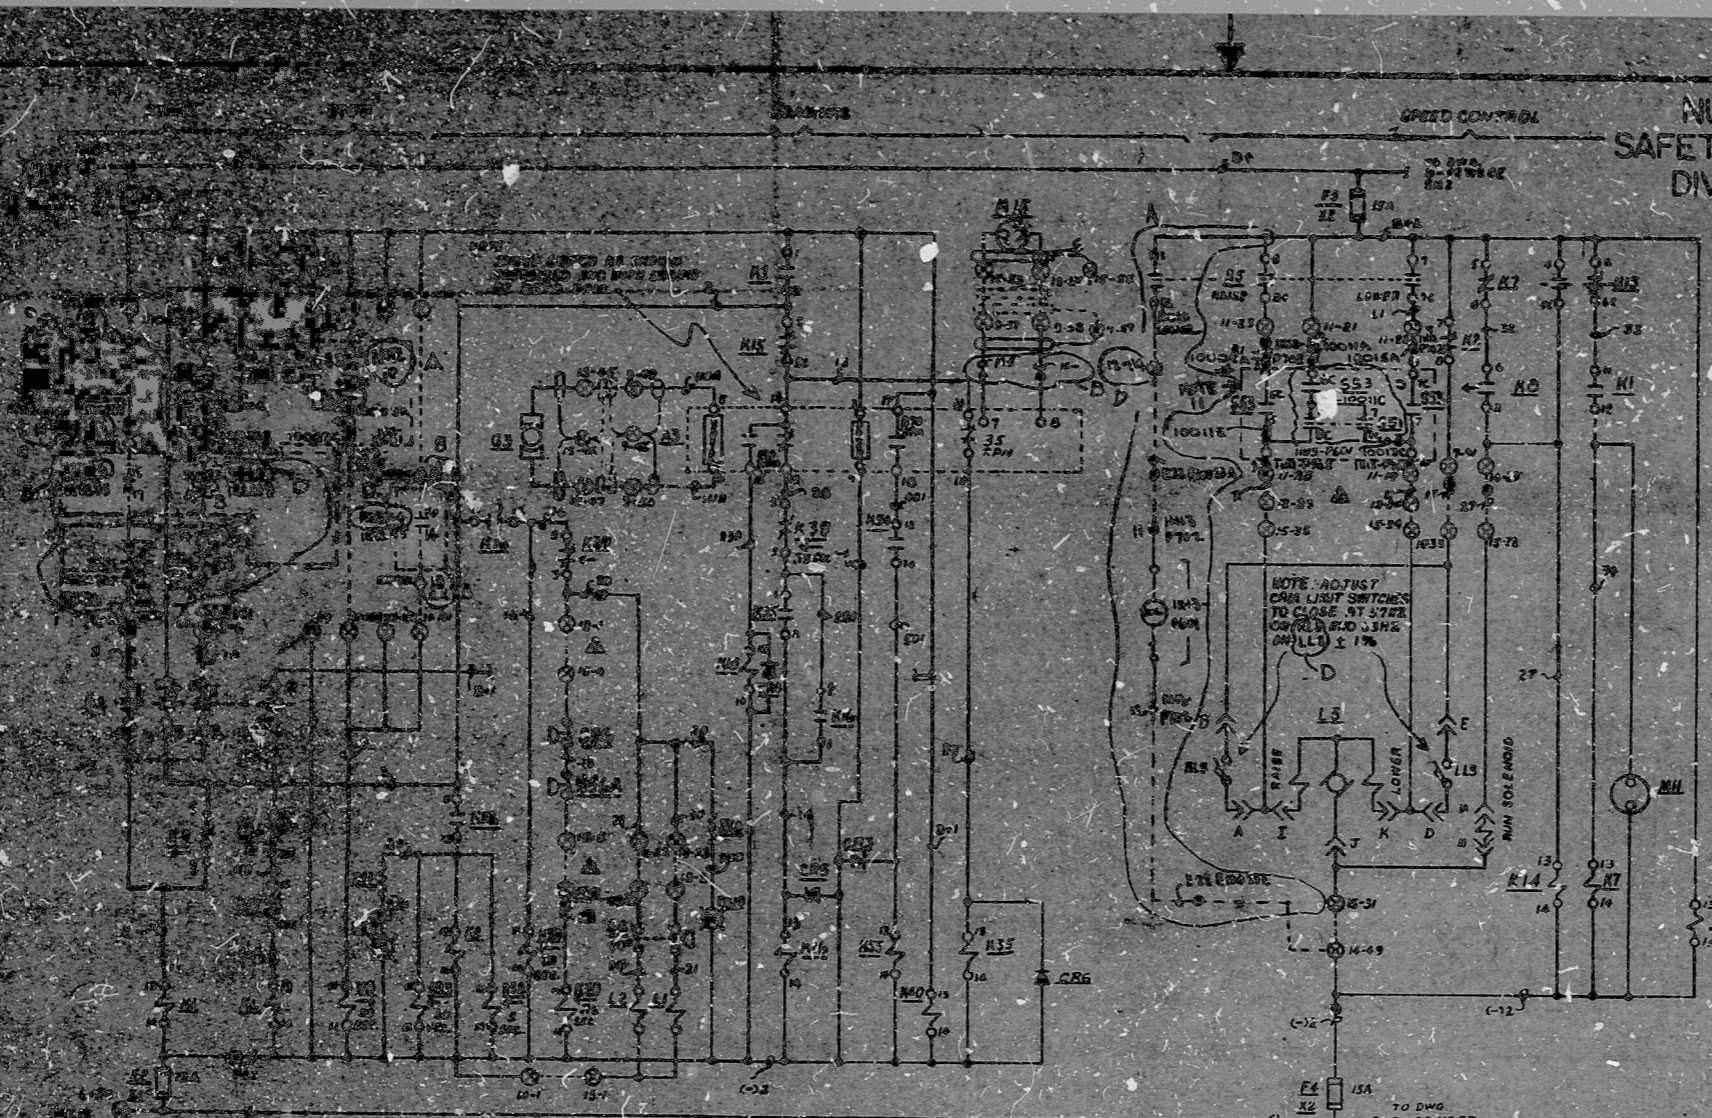

- LEGEND**
- K1 - RELAY, FIELD
 - K2 - RELAY, GOVERNOR AND REGULATOR ASSET
 - K3 - RELAY, AUTO SET UP INDICATION
 - K4 - RELAY, FIELD AUXILIARY
 - K5 - RELAY, STOP TIMER
 - K6 - RELAY, TROUBLE LOCK-OUT
 - K7 - RELAY, FUEL UNIT CHANGING
 - K8 - RELAY, FUEL UNIT CHANGING
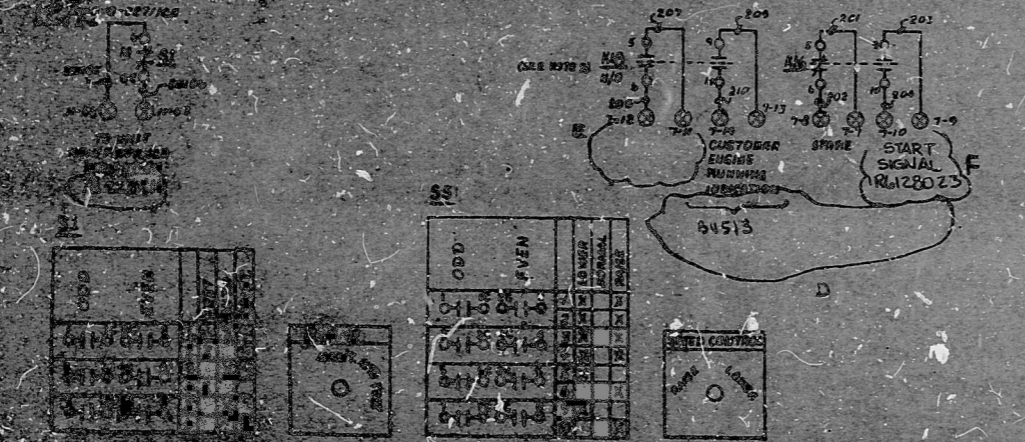




REVISIONS

| | | |
|-----|------|------------------------|
| NO. | DATE | DESCRIPTION |
| 1 | | ISSUE FOR CONSTRUCTION |

PRC APERTURE CARD

STEWART & STEVENSON SERVICES
P.O. BOX 1837 HOUSTON, TEXAS 77062

D.C. CONTROL SCHEMATIC
2400 LBS. 400V. 60 HZ. 3 PH. 3 W. 3 N.
EMERGENCY DIESEL GENERATOR

REVISED REPR. AS SHOWN
DATE: 11/15/55
BY: P. M. DEB...

THE CLEVELAND ELECTRIC COMPANY

216577




RIPS

8212160579

