


B-208-070	SHEET 00	INDEX - LEAK DETECTION SYSTEM
	01	NOTES, REFERENCES, SWITCH DEVELOPMENTS, TABULATIONS
	02	POWER DISTRIBUTION
	03	POWER DISTRIBUTION
	04	RELAY AND ISOLATOR ASSEMBLY TABULATIONS
	05	VALVE LOGIC
	06	VALVE LOGIC
	07	HMCU FLOW CIRCUIT, COMPUTER INPUTS
	08	LEAKAGE FLOW MONITORS
	09	SUMP TIMERS
	10	TEMPERATURE ELEMENTS
	11	TEMPERATURE ELEMENTS
	12	TEMPERATURE ELEMENTS
	13	TEMPERATURE RECORDERS
	14	COMPUTER INPUTS
	15	SENSITIVE SUMP MONITOR
	16	ANNUNCIATOR INPUTS

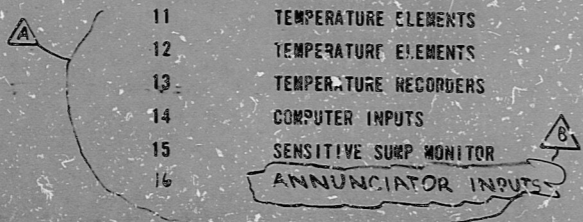

B-208-070	SHEET 200	TURBINE POWER COMPLEX TEMPERATURE
	201	TURBINE BUILDING TEMPERATURE
	202	POWER DISTRIBUTION AND LOGIC
	203	VALVE STEM LEAK-OFF TEMPERATURES
	204	VALVE STEM LEAK-OFF TEMPERATURES
	205	VALVE STEM LEAK-OFF TEMPERATURES
	206	VALVE STEM LEAK-OFF TEMPERATURES
	207	VALVE STEM LEAK-OFF TEMPERATURES
	208	VALVE STEM LEAK-OFF TEMPERATURES
	209	VALVE STEM LEAK-OFF TEMPERATURES
	210	VALVE STEM LEAK-OFF TEMPERATURES
	211	VALVE STEM LEAK-OFF TEMPERATURES
	212	VALVE STEM LEAK-OFF TEMPERATURES

100	DRAIN VALVES 1E31A-F400 THRU 1E31A-F426
101	DRAIN VALVES 1E31A-F407 THRU 1E31A-F414
102	DRAIN VALVES 1E31A-F415 THRU 1E31A-F421
103	DRAIN VALVES 1E31A-F422 THRU 1E31A-F428

PRC  
APERTURE  
CARD

REVISIONS - ALL WORK SHOWN	
LEAK DETECTION SYSTEM INDEX	
<table border="1"> <tr> <td>DATE</td> <td>RELEASED FOR</td> <td>ENGINEER</td> </tr> <tr> <td></td> <td></td> <td></td> </tr> </table>												DATE	RELEASED FOR	ENGINEER	
DATE	RELEASED FOR	ENGINEER	
<table border="1"> <tr> <td>READING</td> <td colspan="2">GILBERT ASSOCIATES, INC.</td> <td colspan="2">ENGINEERS AND CONSULTANTS</td> </tr> <tr> <td>DATE</td> <td>BY</td> <td>MADE</td> <td>CHKD</td> <td>APPROVALS</td> </tr> <tr> <td></td> <td>B. YZ</td> <td>T. Am</td> <td>D. Ram</td> <td>1/1/82</td> </tr> </table>												READING	GILBERT ASSOCIATES, INC.		ENGINEERS AND CONSULTANTS		DATE	BY	MADE	CHKD	APPROVALS		B. YZ	T. Am	D. Ram	1/1/82	
READING	GILBERT ASSOCIATES, INC.		ENGINEERS AND CONSULTANTS	
DATE	BY	MADE	CHKD	APPROVALS	
	B. YZ	T. Am	D. Ram	1/1/82	
<table border="1"> <tr> <td>REV</td> <td>DATE</td> <td>BY</td> <td>MADE</td> <td>CHKD</td> <td>APPROVALS</td> <td>DATE</td> <td>REV</td> <td>MADE</td> <td>CHKD</td> <td>APPROVALS</td> <td>DATE</td> </tr> <tr> <td></td> <td></td> <td></td> <td></td> <td></td> <td></td> <td></td> <td></td> <td></td> <td></td> <td></td> <td></td> </tr> </table>												REV	DATE	BY	MADE	CHKD	APPROVALS	DATE	REV	MADE	CHKD	APPROVALS	DATE	
REV	DATE	BY	MADE	CHKD	APPROVALS	DATE	REV	MADE	CHKD	APPROVALS	DATE	
<table border="1"> <tr> <td>WORK ORDER</td> <td>DATE</td> <td>MADE</td> <td>CHKD</td> <td>OR. APP.</td> <td>ENG. APP.</td> <td>DATE</td> </tr> <tr> <td></td> <td></td> <td></td> <td></td> <td></td> <td></td> <td></td> </tr> </table>												WORK ORDER	DATE	MADE	CHKD	OR. APP.	ENG. APP.	DATE	
WORK ORDER	DATE	MADE	CHKD	OR. APP.	ENG. APP.	DATE	
<table border="1"> <tr> <td>ELEM</td> <td>DIAG</td> <td>1E31A</td> <td>INDEX</td> </tr> </table>												ELEM	DIAG	1E31A	INDEX	
ELEM	DIAG	1E31A	INDEX	
 </table>												NO. 00	NO. 01	NO. 02	
NO. 00	NO. 01	NO. 02	

17"

11"

8.5"

8.5"

11"

17"

17"

11"

8.5"

8.5"

11"

17"



RIDS

8212160598

