

11

11

9.8

8.5"

11"

17"

11


11

9.8

8.5"

11"

17"

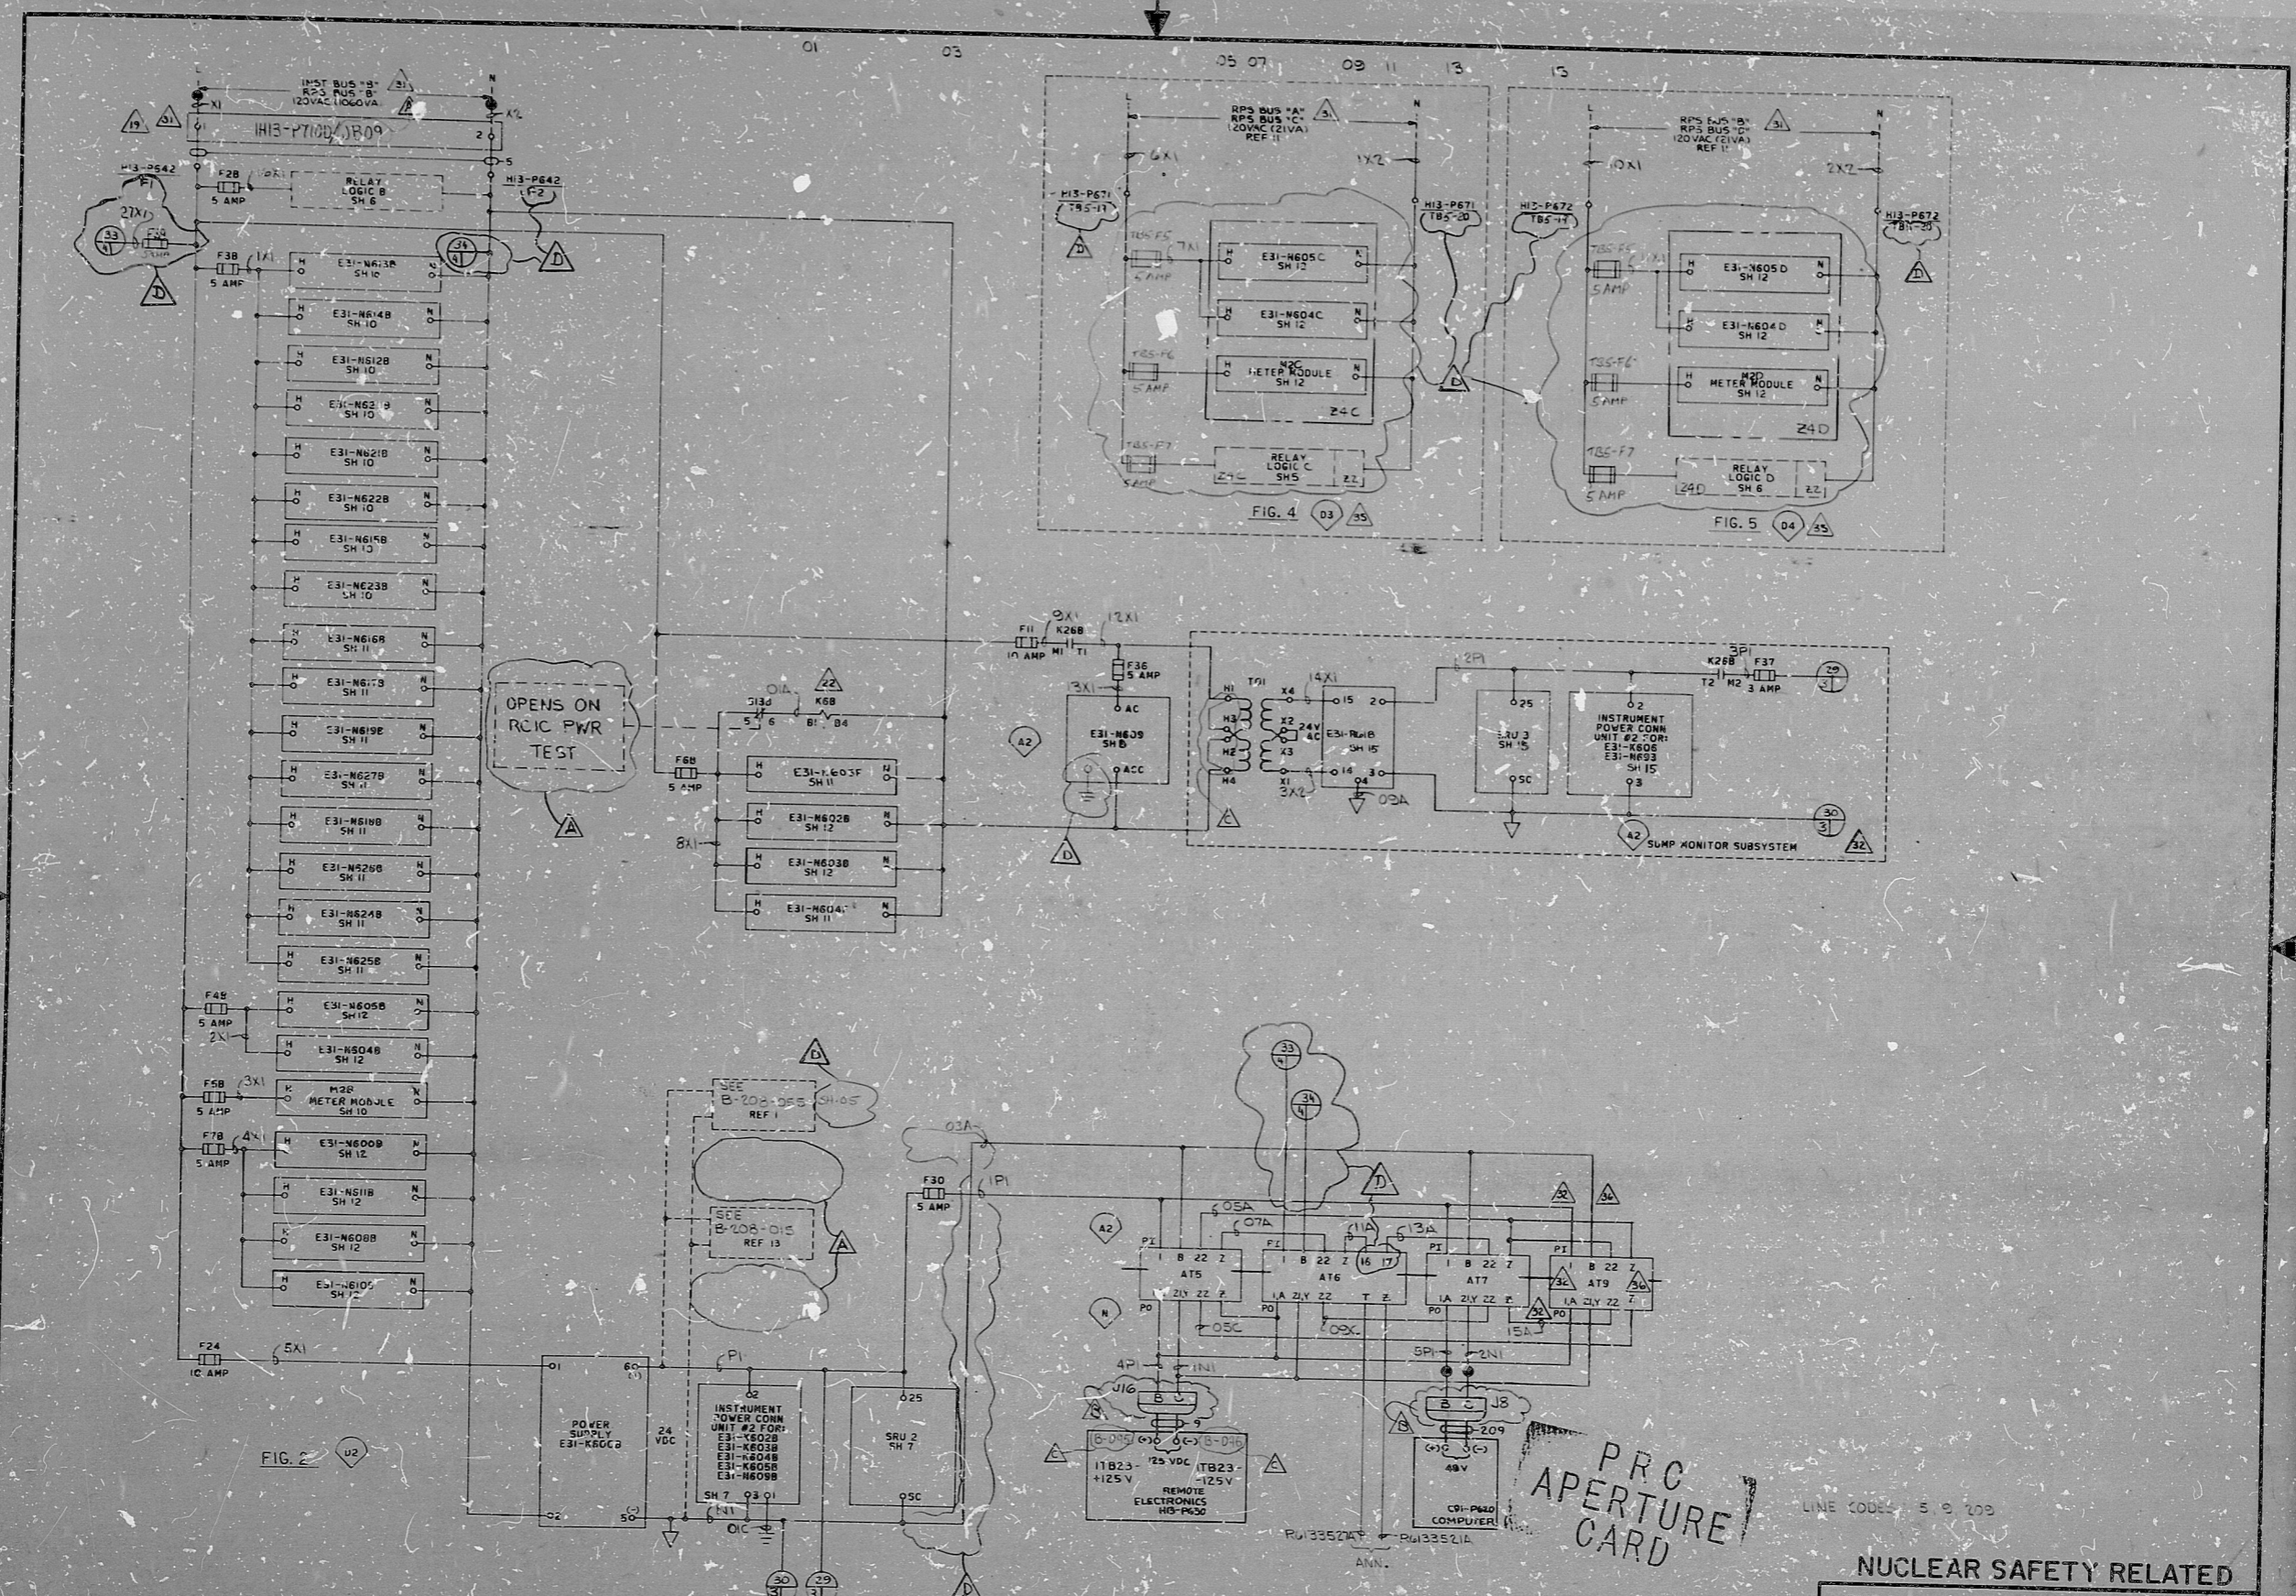

CHANGED FUSE DESIGN & ADDED CABINET FUSE #15, ADDED GROUND TO T0 (C-100), ADDED JIG #12 AS PER GE DWG AND WHAT BLUELINE

CHANGED CONNECT. POINTS IN T01 ADD TERM B-095 & B-096 TO H3-P630

REV JIG & ADDED JB PER GE REVISION 1

ADDED FITS INFORMATION CHANGED JUNG BOX REV. AS PER GE REVISION 0

REV	MADE	CHKD	APPROVALS	DATE	REV	MADE	CHKD	APPROVALS	DATE	REV	MADE	CHKD	APPROVALS	DATE	REV	MADE	CHKD	APPROVALS	DATE	
D	6	TAM	DEG	RAM	3/19/82	C	NYZ	RAM	10-1-80	B	CAG	RAM	DEG	RAM	11-2-79	A	RAM	DEG	RAM	8-10-79

GENERAL ELECTRIC 851ES02CA  
ELEM DIAG  
LEAK DETECTION SYSTEM  
REV. 4 REV. 5

PRC APERTURE CARD

NUCLEAR SAFETY RELATED

THE CLEVELAND ELECTRIC ILLUMINATING CO.

PERRY NUCLEAR POWER PLANT UNIT 1

ELECTRICAL-ELEMENTARY DIAGRAM

LEAK DETECTION SYSTEM POWER DISTRIBUTION

3/6/78	CONSTRUCTION	gms
	PRELIMINARY	
DATE	RELEASED FOR	ENGR.

GILBERT ASSOCIATES, INC.  
ENGINEERS AND CONSULTANTS

READING PA  
044549-000  
JGS RAM DEG MMD 3/6/78

04 4549 B-208-070 E31 A03 D

ELEM DIAG 11E31A POWER DISTRIBUTION

RIDS

82L2160602

