


8.5"
11"
17"

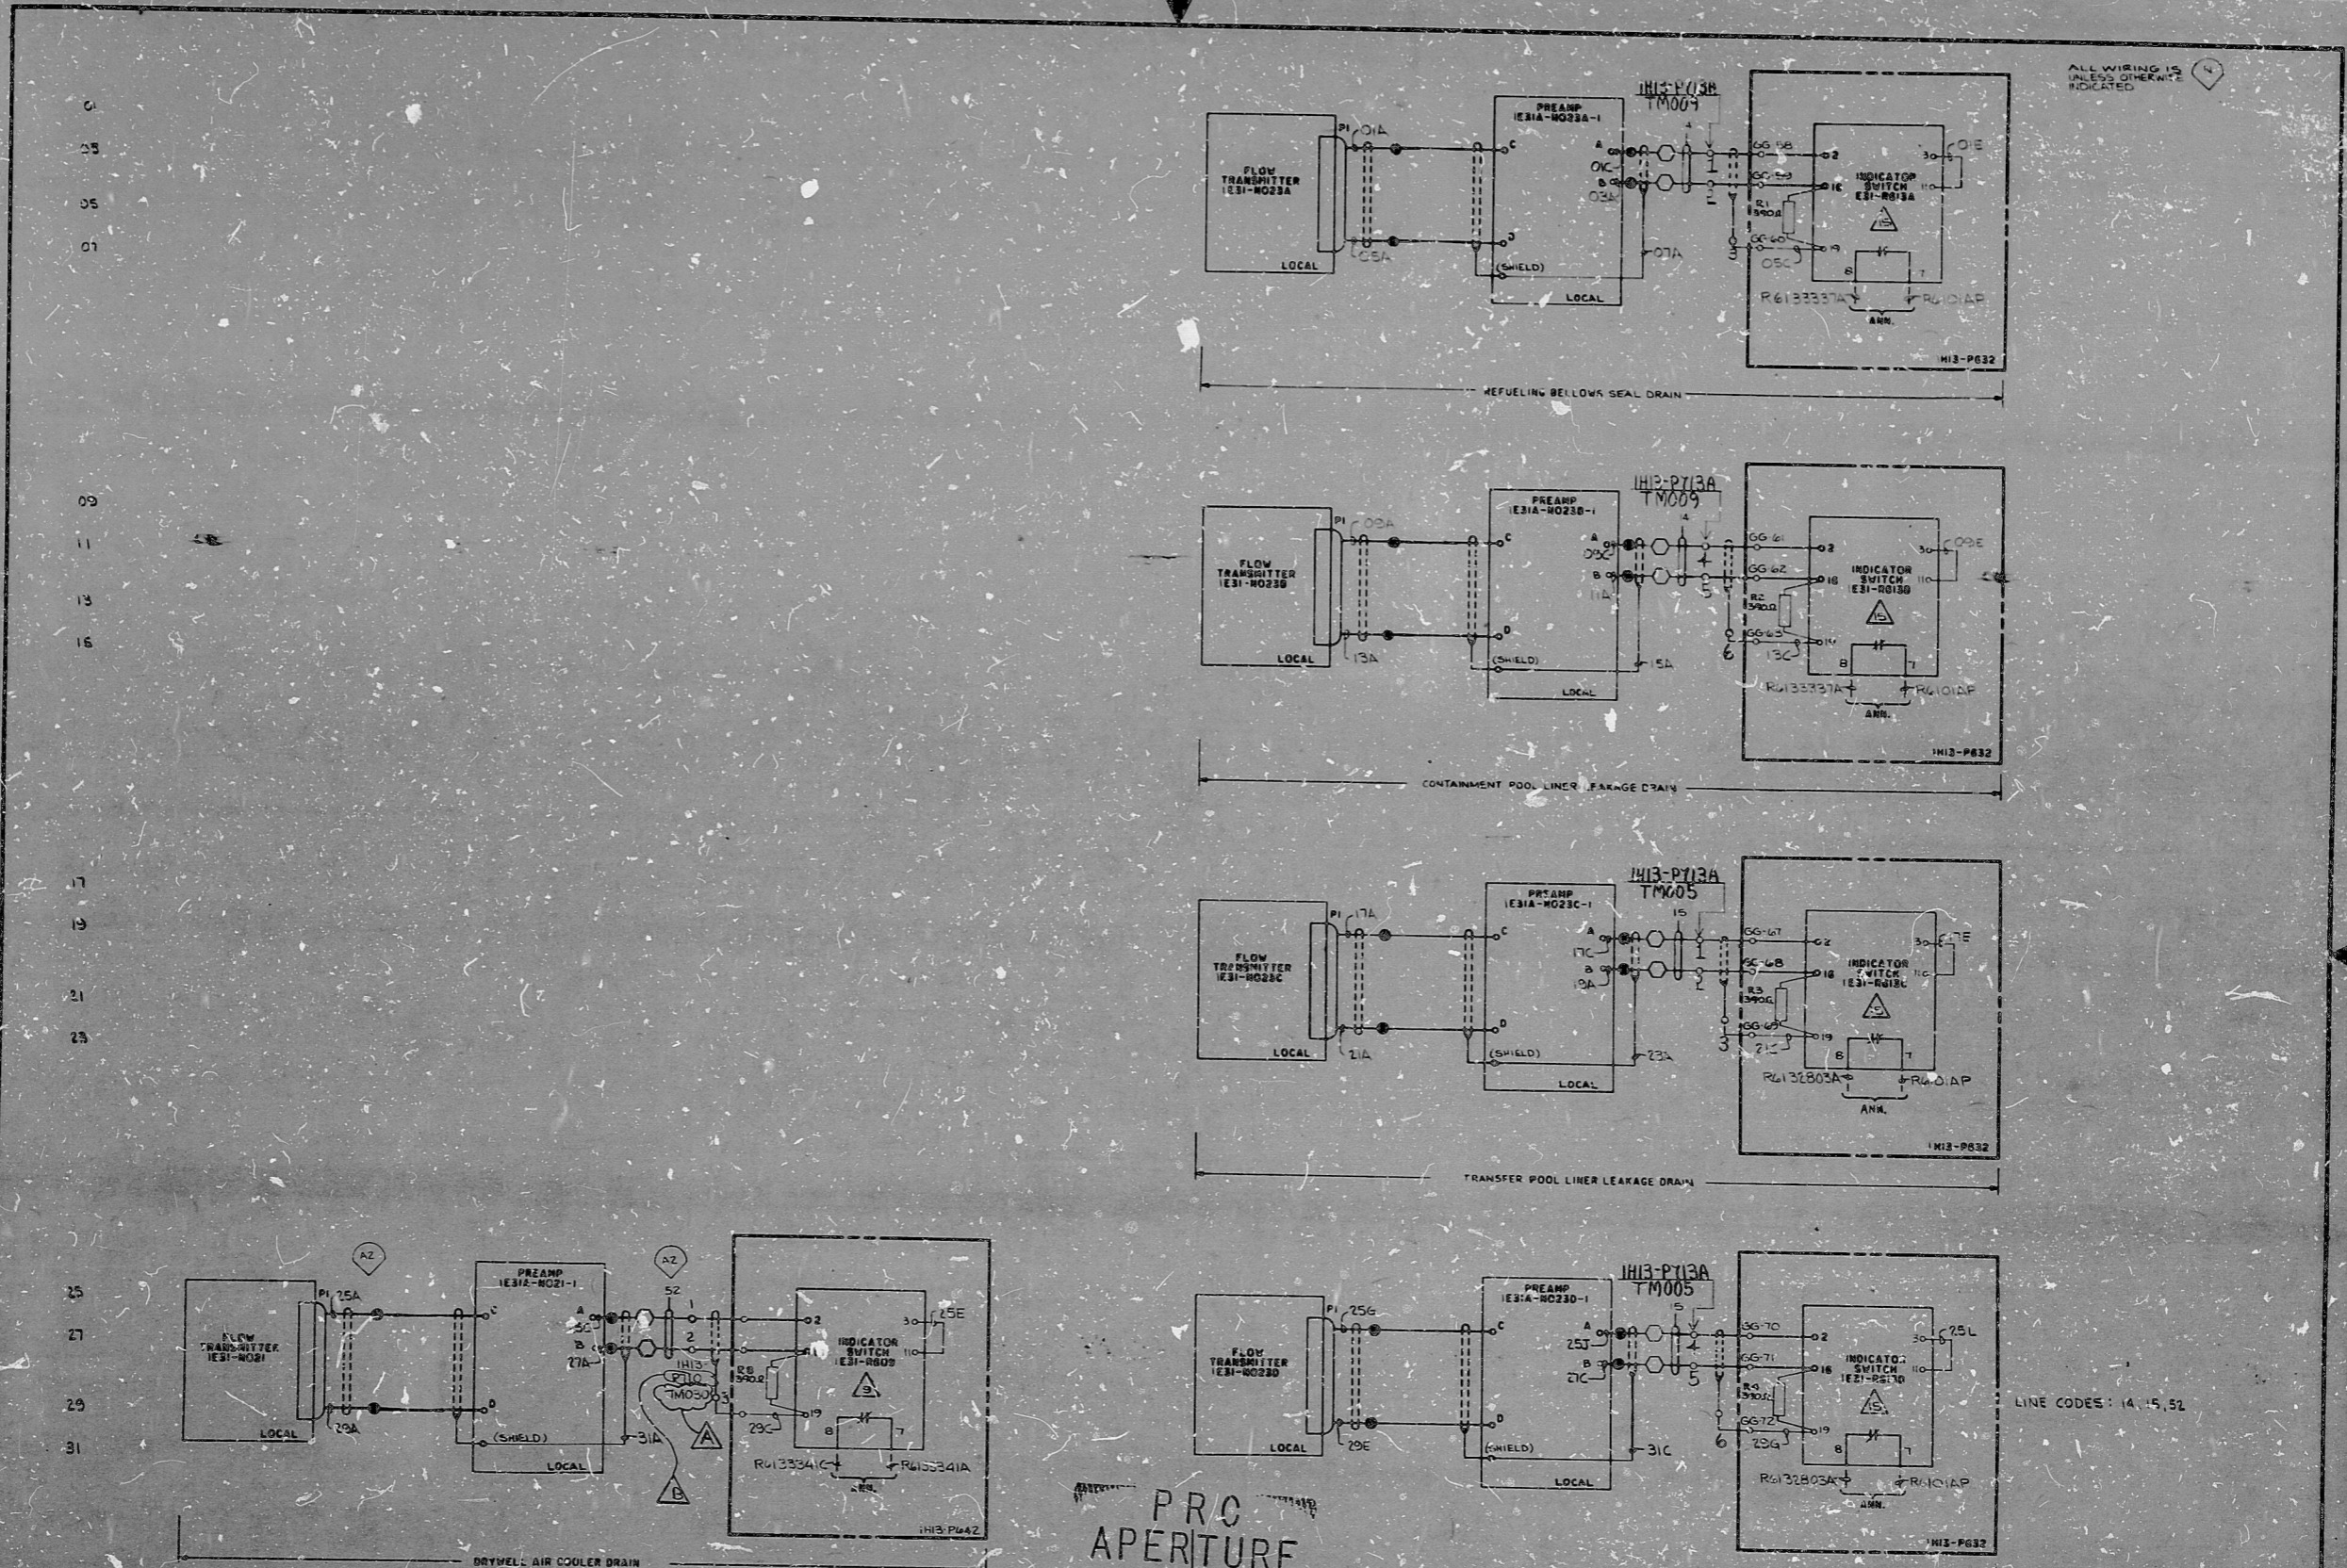

PROC APERTURE CARD

GENERAL ELECTRIC
LEAK DETECTION SYSTEM
REV. 10-79

NUCLEAR SAFETY RELATED
THE CLEVELAND ELECTRIC ILLUMINATING CO.
PERRY NUCLEAR POWER PLANT UNIT 1
ELECTRICAL-FUNDAMENTAL DIAGRAM

REV	DATE	BY	CHKD	APPROVALS	DATE	REV	DATE	BY	CHKD	APPROVALS	DATE	REV	DATE	BY	CHKD	APPROVALS	DATE	REV	DATE	BY	CHKD	APPROVALS	DATE
1						1						1						1					
2						2						2						2					
3						3						3						3					
31						31						31						31					

ELECTRICAL IESIA LEAKAGE FLOW MON

NUCLEAR SAFETY RELATED
THE CLEVELAND ELECTRIC ILLUMINATING CO.
PERRY NUCLEAR POWER PLANT UNIT 1
ELECTRICAL-FUNDAMENTAL DIAGRAM
LEAK DETECTION SYSTEM
LEAKAGE FLOW MONITORS

REVISIONS
REV 1 3/1/78
REV 2 3/1/78
DATE 3/1/78
CONSTRUCTION 1/78
PRELIMINARY
RELEASED FOR ENGR.

CHILBERT ASSOCIATES, INC.
ENGINEERS AND CONSULTANTS
844549-000
JES RAM DEG JMD
3/1/78
4549 15-208-070 E31 A08
DRAWING NUMBER SYSTEM OR INC. OR

RIPS

82L2160615

