


17"
11"
8.5"
8.5"
11"
17"

17"
11"
8.5"
8.5"
11"
17"

01 03 05 07

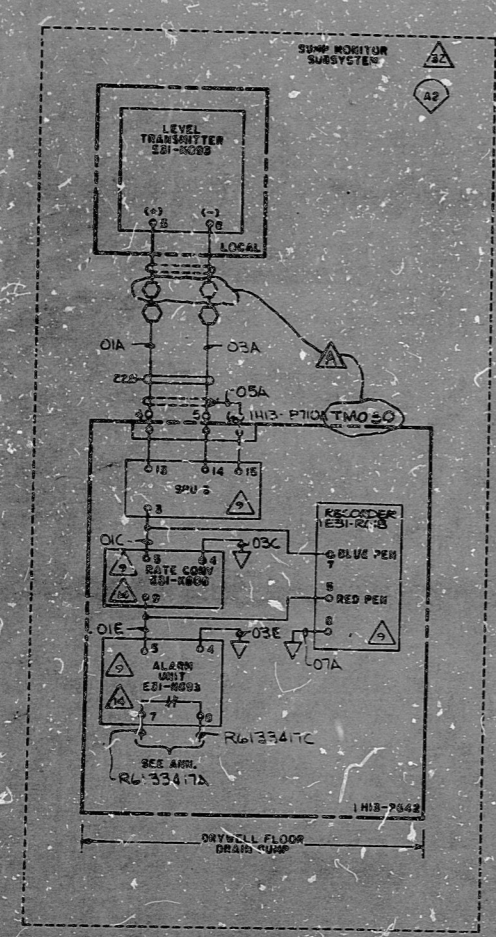

PRC APERTURE CARD

LINE CODE: 210

GENERAL ELECTRIC
CLEAR DIAG
LEAK DETECTION SYSTEM
851E702
SW 16 REL 4

NUCLEAR SAFETY RELATED
THE CLEVELAND ELECTRIC ILLUMINATING CO.
PERRY NUCLEAR POWER PLANT UNIT 1
ELECTRICAL-ELEMENTARY DIAGRAM

REVISED TITLE BLOCK AS PER GE DRAWING	REVISED AS PER GE REVISION 0	READING PA	GILBERT ASSOCIATES, INC. ENGINEERS AND CONSULTANTS	3/6/78	CONSTRUCTION PRELIMINARY	3/6/78	DATE RELEASED FOR ENGR.														
B. J. TAN	DEC. 21/75	A. CAG	DEC. 21/75	04510-008	JGS	RAM	DEC. 21/75														
REV	MADE	CHKD	APPROVALS	DATE	REV	MADE	CHKD	APPROVALS	DATE	WORK ORDER	MADE	CHKD.	DR. APP.	ENGR. APP.	DATE	04	3510	9-208-070	E31	A15	B
ELECTRICAL DIAGRAM												LEAK DETECTION SYSTEM		SENSITIVE SUMM MONITOR		DRAWING NUMBER		SYSTEM		UNIT	

RIDS

8212160632

