


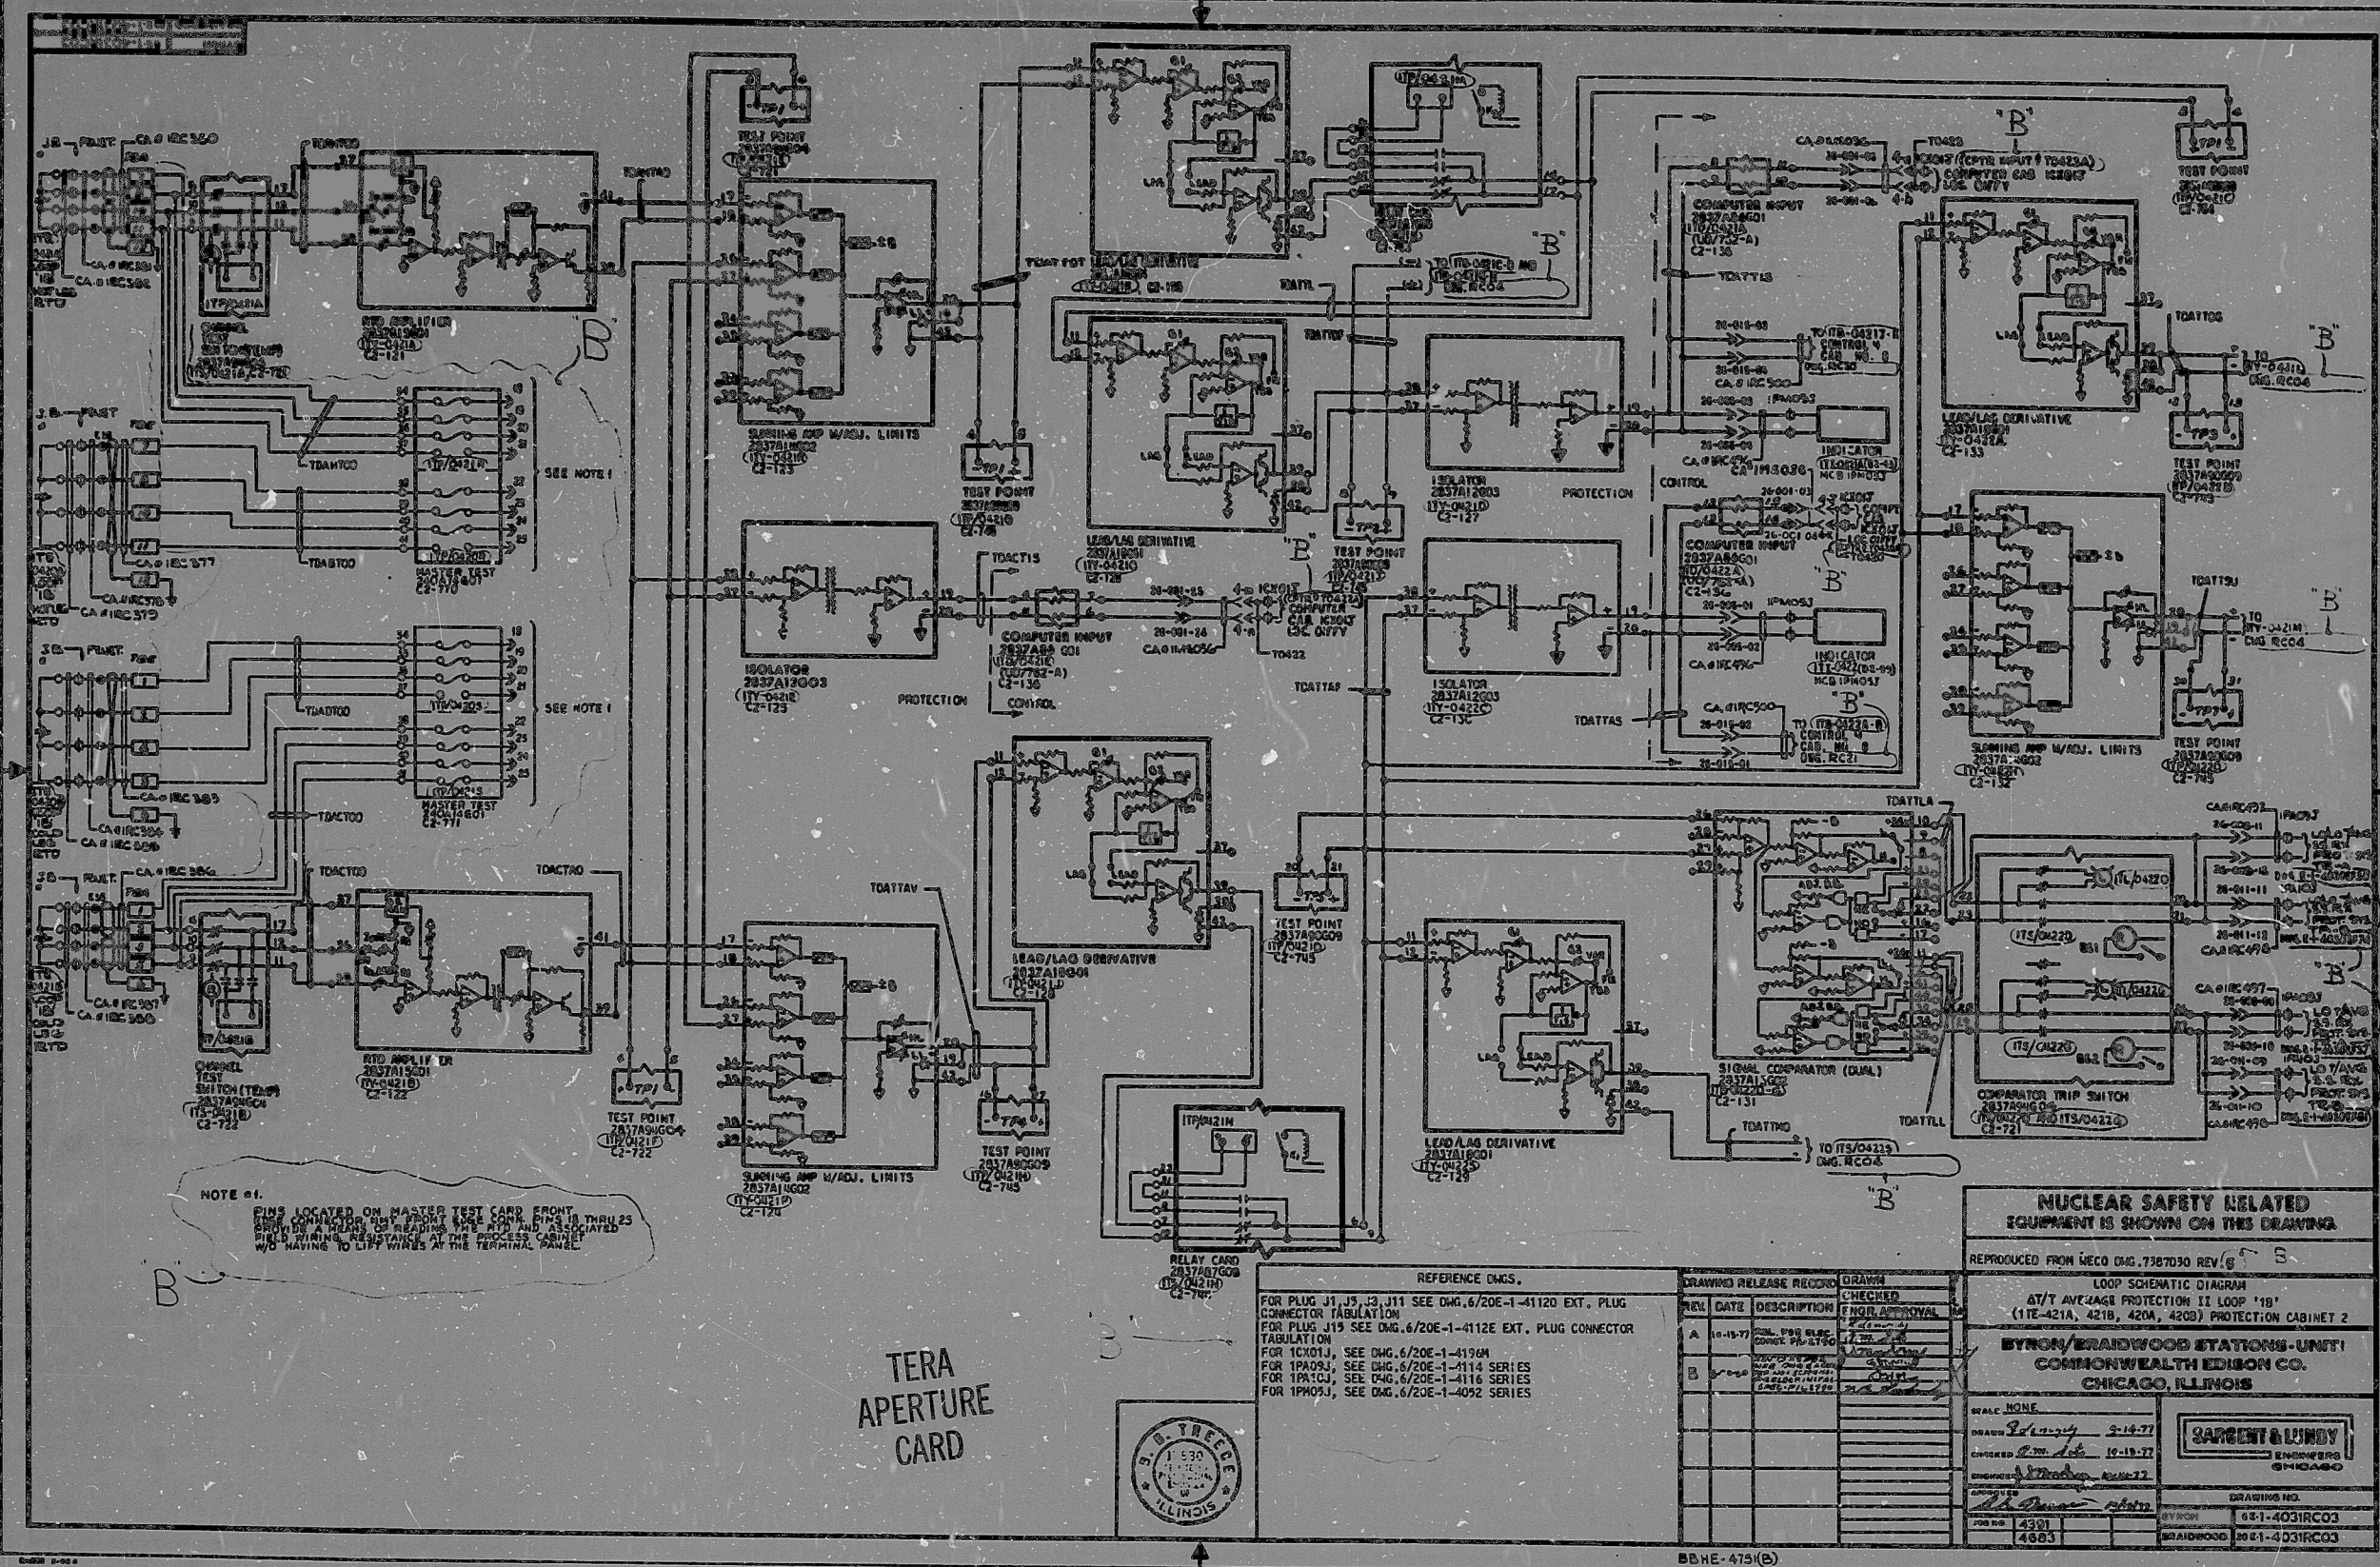

Tera
Aperture
Card

**NUCLEAR SAFETY RELATED
EQUIPMENT IS SHOWN ON THIS DRAWING**

REPRODUCED FROM WECO Dwg. 7387030 REV. 5
LOOP SCHEMATIC DIAGRAM
6T/T AVERAGE PROTECTION II LOOP '18'
(11E-421A, 421B, 420A, 420B) PROTECTION CABINET 2
BYRON/BRAIDWOOD STATIONS-UNIT 1
COMMONWEALTH EDISON CO.
CHICAGO, ILLINOIS

REFERENCE DWG.
FOR PLUG J1, J3, J11 SEE Dwg. 6/20E-1-4112D EXT. PLUG
CONNECTOR TABULATION
FOR PLUG J19 SEE Dwg. 6/20E-1-4112E EXT. PLUG CONNECTOR
TABULATION
FOR 1C101J, SEE Dwg. 6/20E-1-4119M
FOR 1P100J, SEE Dwg. 6/20E-1-4114 SERIES
FOR 1P101J, SEE Dwg. 6/20E-1-4116 SERIES
FOR 1P103J, SEE Dwg. 6/20E-1-4092 SERIES

REL.	DATE	DESCRIPTION	CHECKED	APPROVAL
A	10-19-77	REL. PDR REL. PDR REL. PDR		
B				


8107080136

