


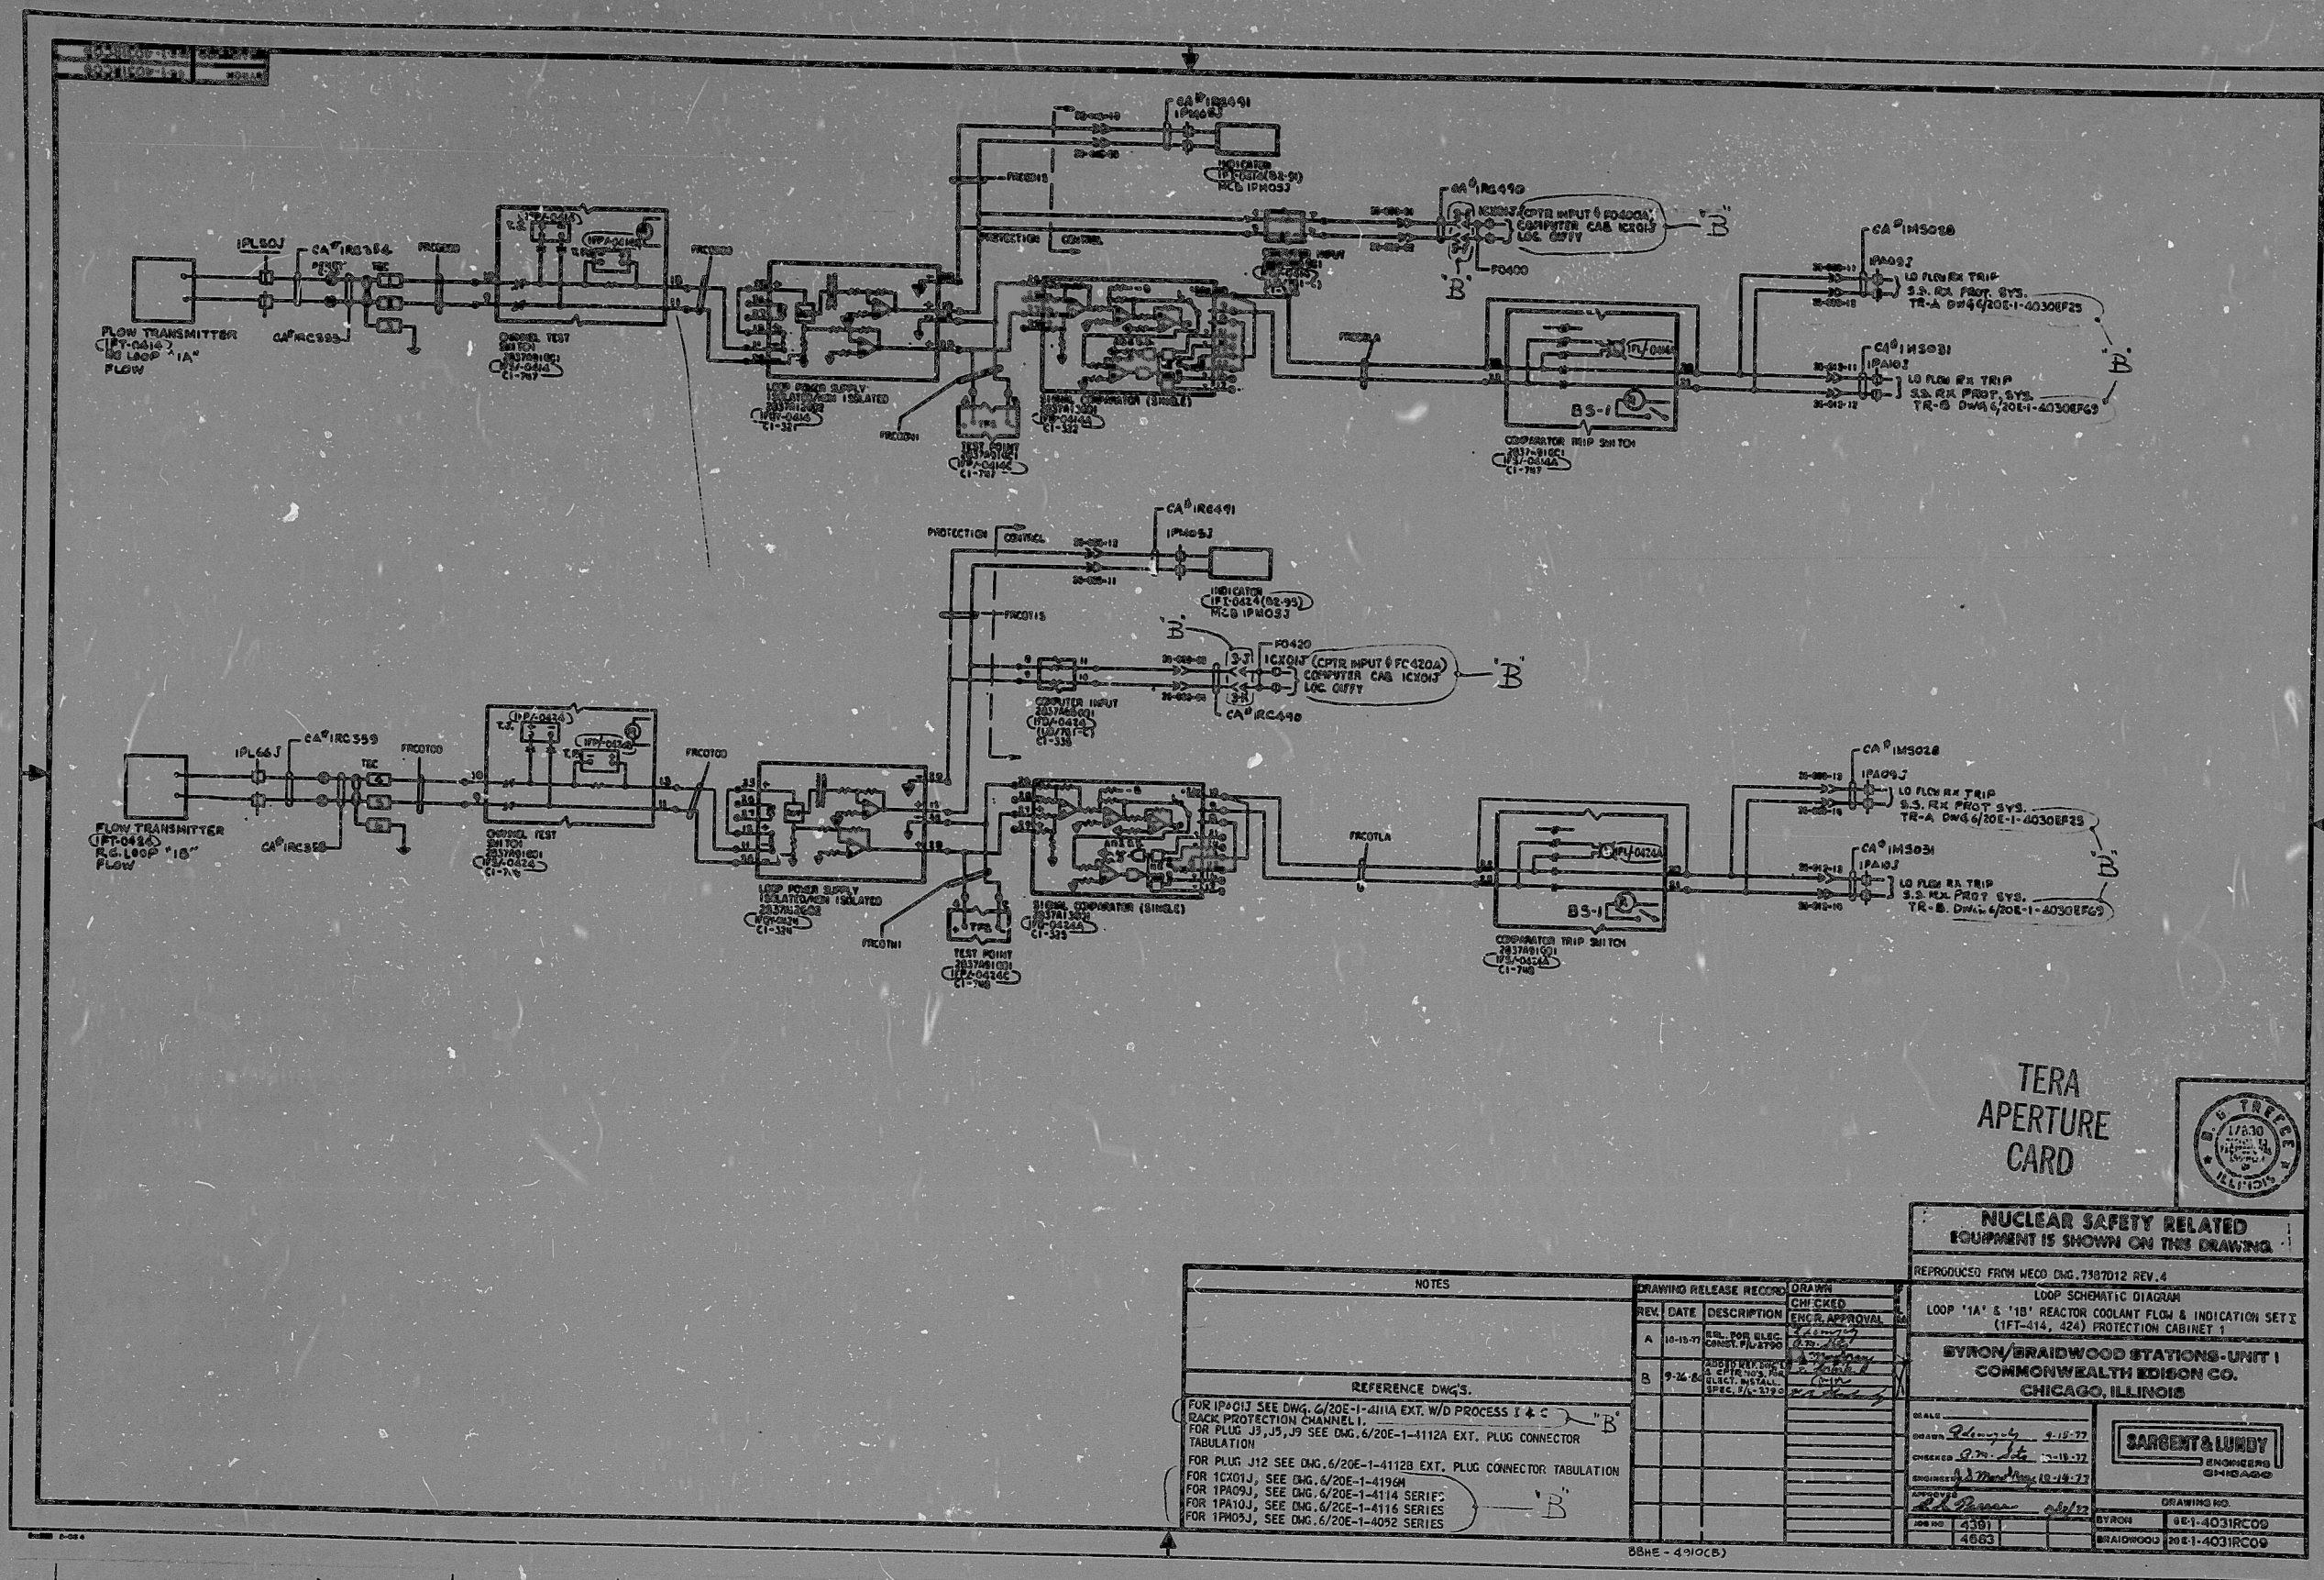



8107080150

