


01 03 05 -07 09 11 13 15 17 19 21 23 25 27 29 31 33 35 37 39 41

TRANSIENT TEST POINTS

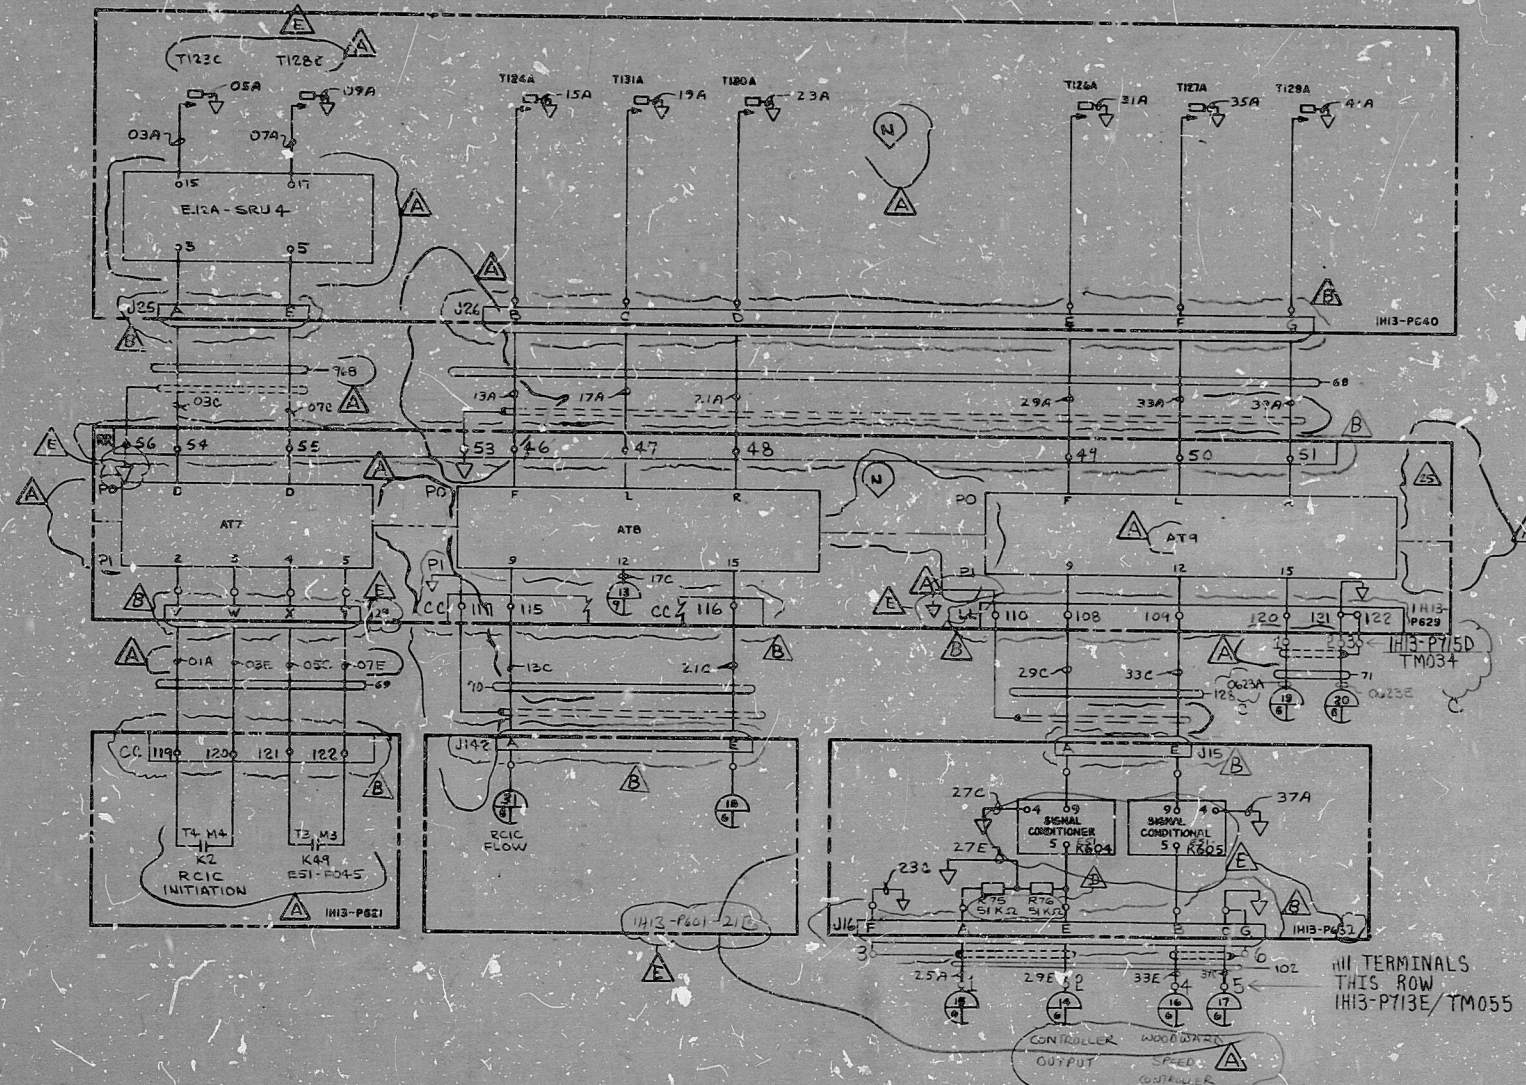

ALL WIRING IS (A) UNLESS OTHERWISE SPECIFIED ON THIS SHEET

LINE CODES: 68-71, 102, 968, 128

PRC APERTURE CARD

GENERAL NOTES: 020539CA
 REACTOR CORE ISLN COOLING SYS

NUCLEAR SAFETY RELATED
 THE CLEVELAND ELECTRIC ILLUMINATING CO.
 PERRY NUCLEAR POWER PLANT UNIT 1
 ELECTRICAL ELEMENTARY DIAGRAM
 REACTOR CORE ISOLATION COOLING SYSTEM
 TRANSIENT TEST POINTS

CHANGED REFS, ADDED REFS, ADDED CADDINGS AS PER GE DRAWING	REVISED R75 & R76 AND ADDED LINE CODES	REVISED TERM. CAB. AND WIRE MARK	ADDED FITS & PLUG INS CHANGED TERM. CABINET	REVISED LINE CODES, GRDS, WIRE MARKS, RELAY CONTACTS, RECTIFIED WIRE-PIN	READING PA	344549-000	7-28-77	CONSTRUCTION PRELIMINARY	TEF
E SEP AM DEC 9 1977	D YZ RM DEC 9 1977	C RAM OPS DEC 9 1977	B RAM RAM DEC 9 1977	A WIM RAM DEC 9 1977	GILBERT ASSOCIATES, INC. ENGINEERS AND CONSULTANTS	7-28-77	7-28-77	DATE RELEASED FOR	EMGR
REV MADE CHKD APPROVALS DATE	REV MADE CHKD APPROVALS DATE	REV MADE CHKD APPROVALS DATE	REV MADE CHKD APPROVALS DATE	REV MADE CHKD APPROVALS DATE	WORK ORDER	7-28-77	7-28-77	DATE	DATE

ELEM DIAG ESIA TRANS TEST POINTS

11
8.5
8.5
11
17

11
8.5
8.5
11
17

RIDS

8212160700

