


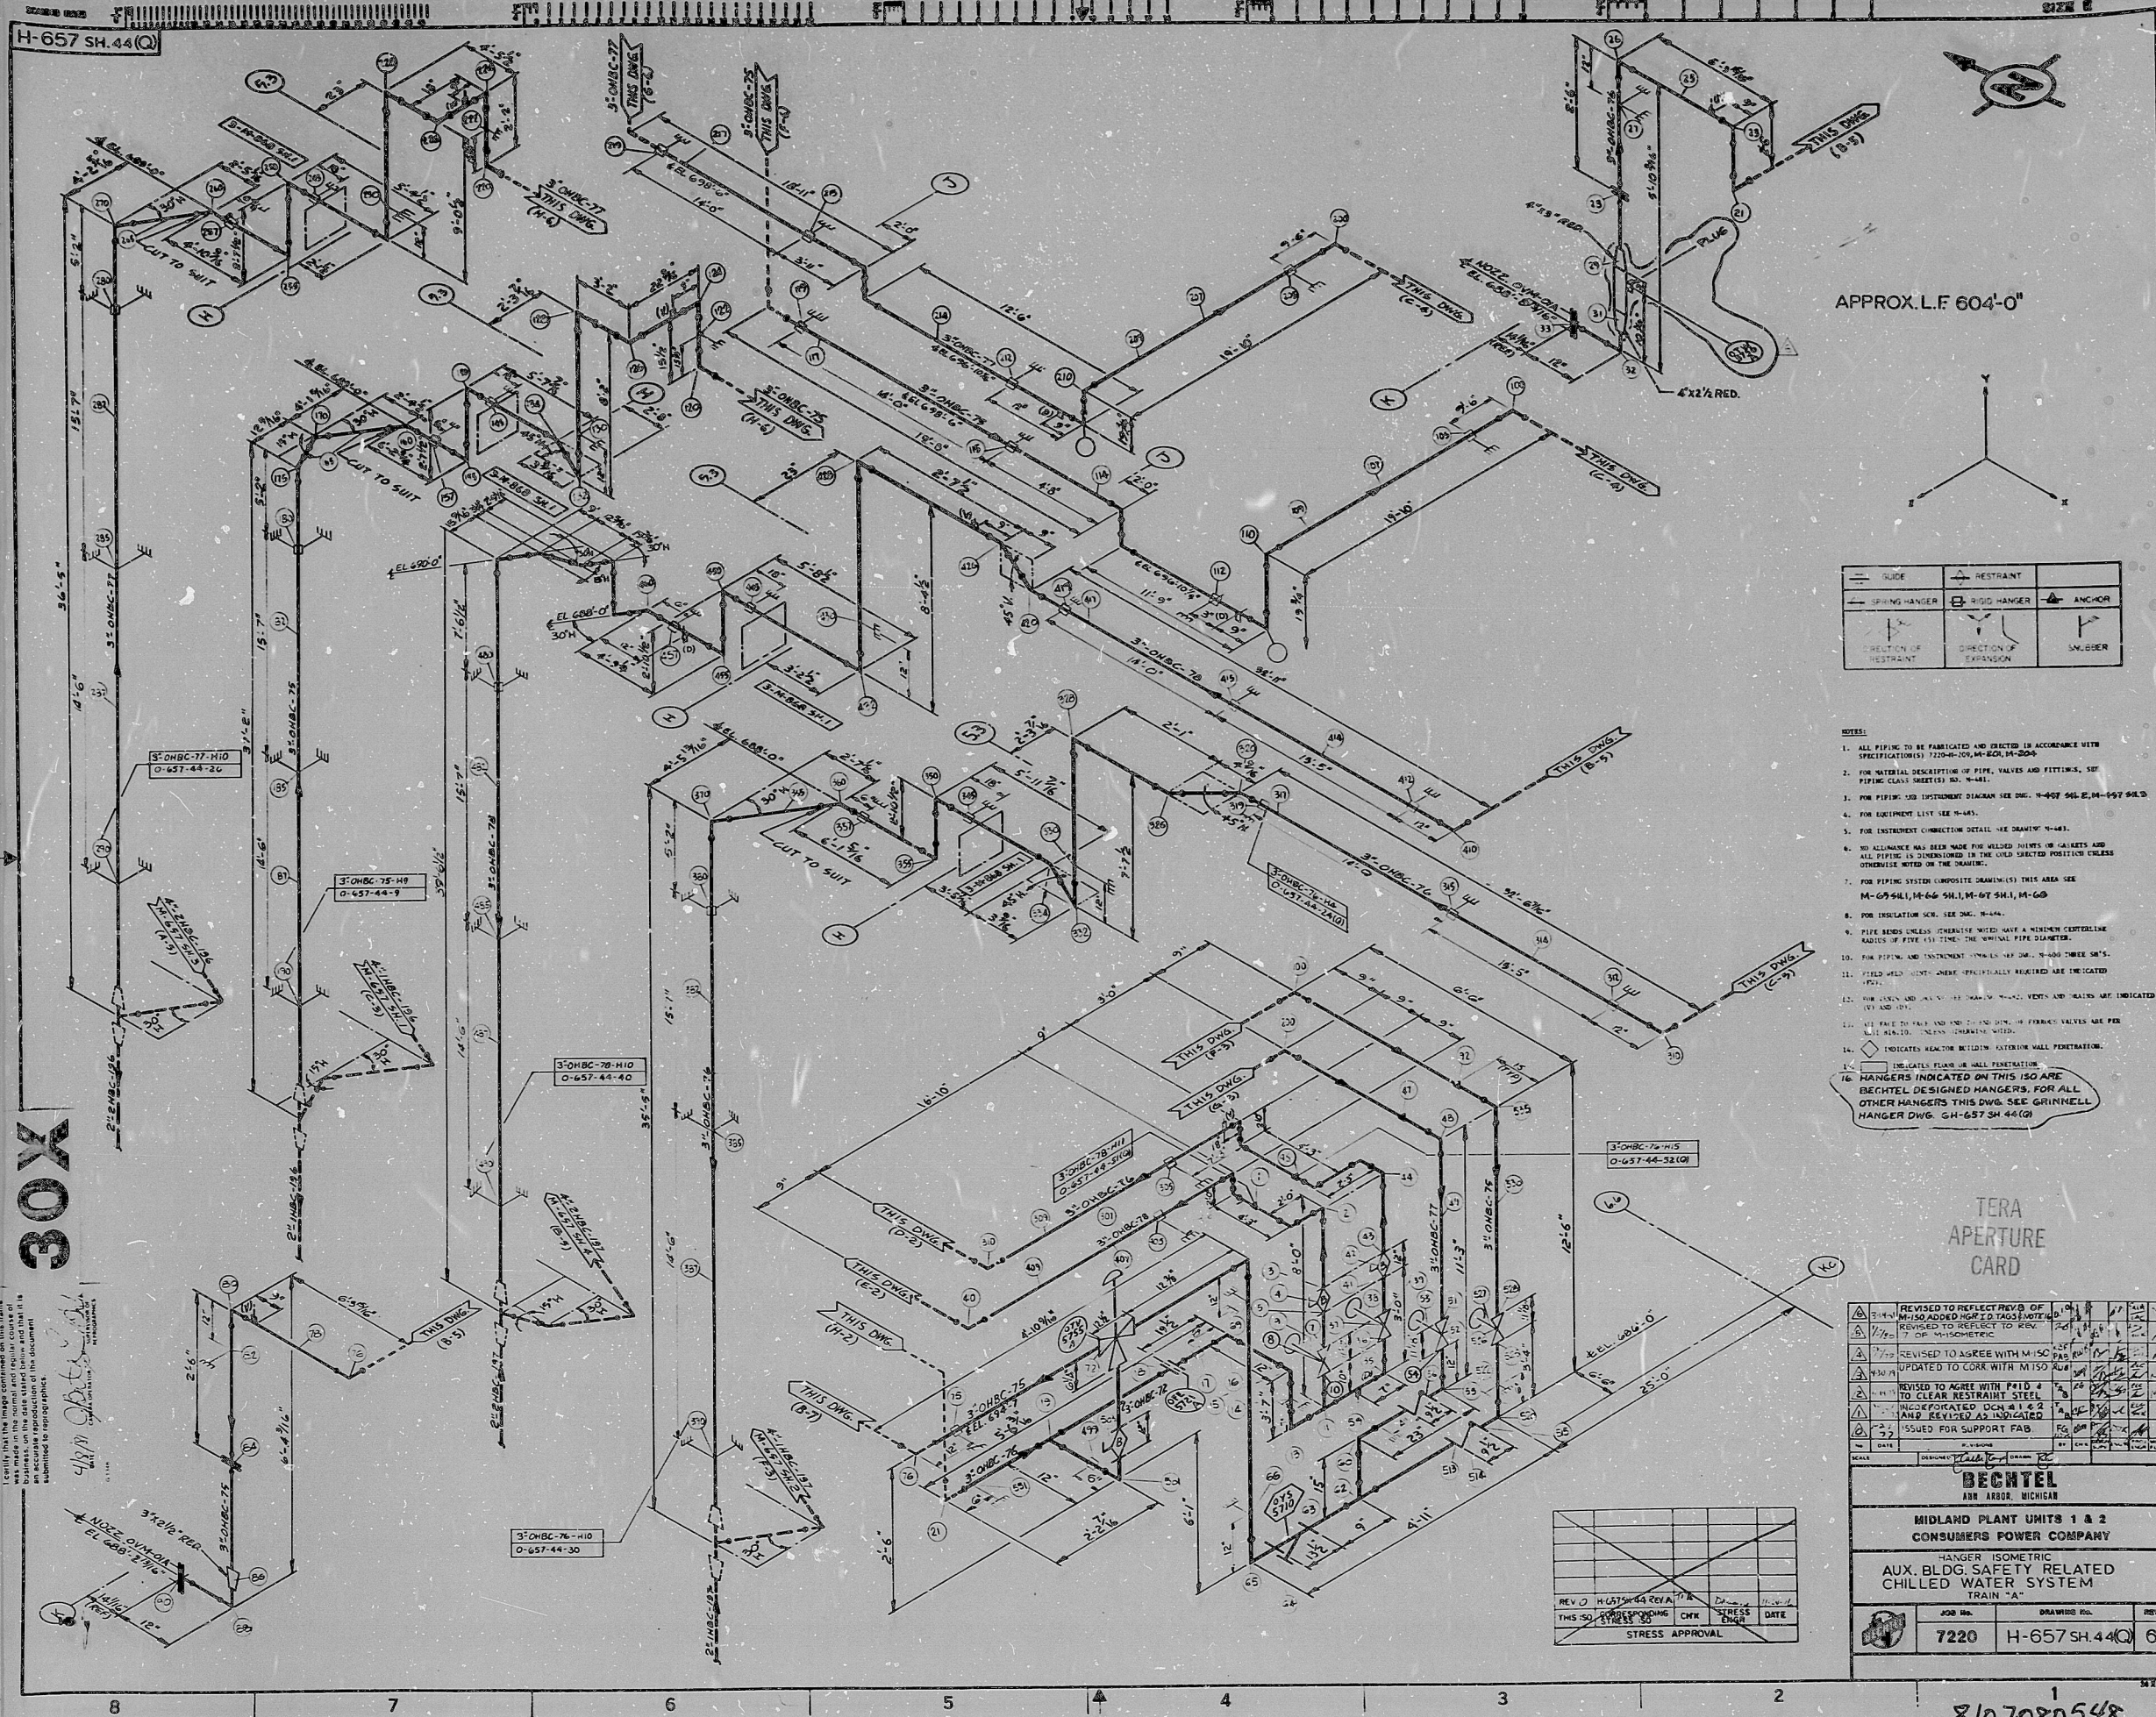

PIPE	RESTRAINT	ANCHOR
SPRING HANGER	RIGID HANGER	ANCHOR
DIRECTION OF RESTRAINT	DIRECTION OF EXPANSION	ANCHOR

- NOTES:
1. ALL PIPING TO BE FABRICATED AND ERRECTED IN ACCORDANCE WITH SPECIFICATIONS 7220-40-100, M-601, M-604.
 2. FOR MATERIAL DESCRIPTION OF PIPE, VALVES AND FITTINGS, SEE PIPING CLASSIFICATION SHEET NO. W-401.
 14. INDICATES REACTOR BUILDING EXTERIOR WALL PENETRATION.
 15. INDICATES PLUMBING WALL PENETRATION.
 16. HANGERS INDICATED ON THIS ISOM ARE BECTEL DESIGNED HANGERS. FOR ALL OTHER HANGERS THIS DWG. SEE GRINNELL HANGER DWG. GH-657 SH 44(Q).

TERA APERTURE CARD


BECTEL
ANN ARBOR, MICHIGAN

MIDLAND PLANT UNITS 1 & 2
CONSUMERS POWER COMPANY

HANGER ISOMETRIC
AUX. BLDG. SAFETY RELATED
CHILLED WATER SYSTEM
TRAIN "A"

JOB NO.	DRAWING NO.	REV.
7220	H-657 SH 44(Q)	6

8107080548

R103

8107080548

