


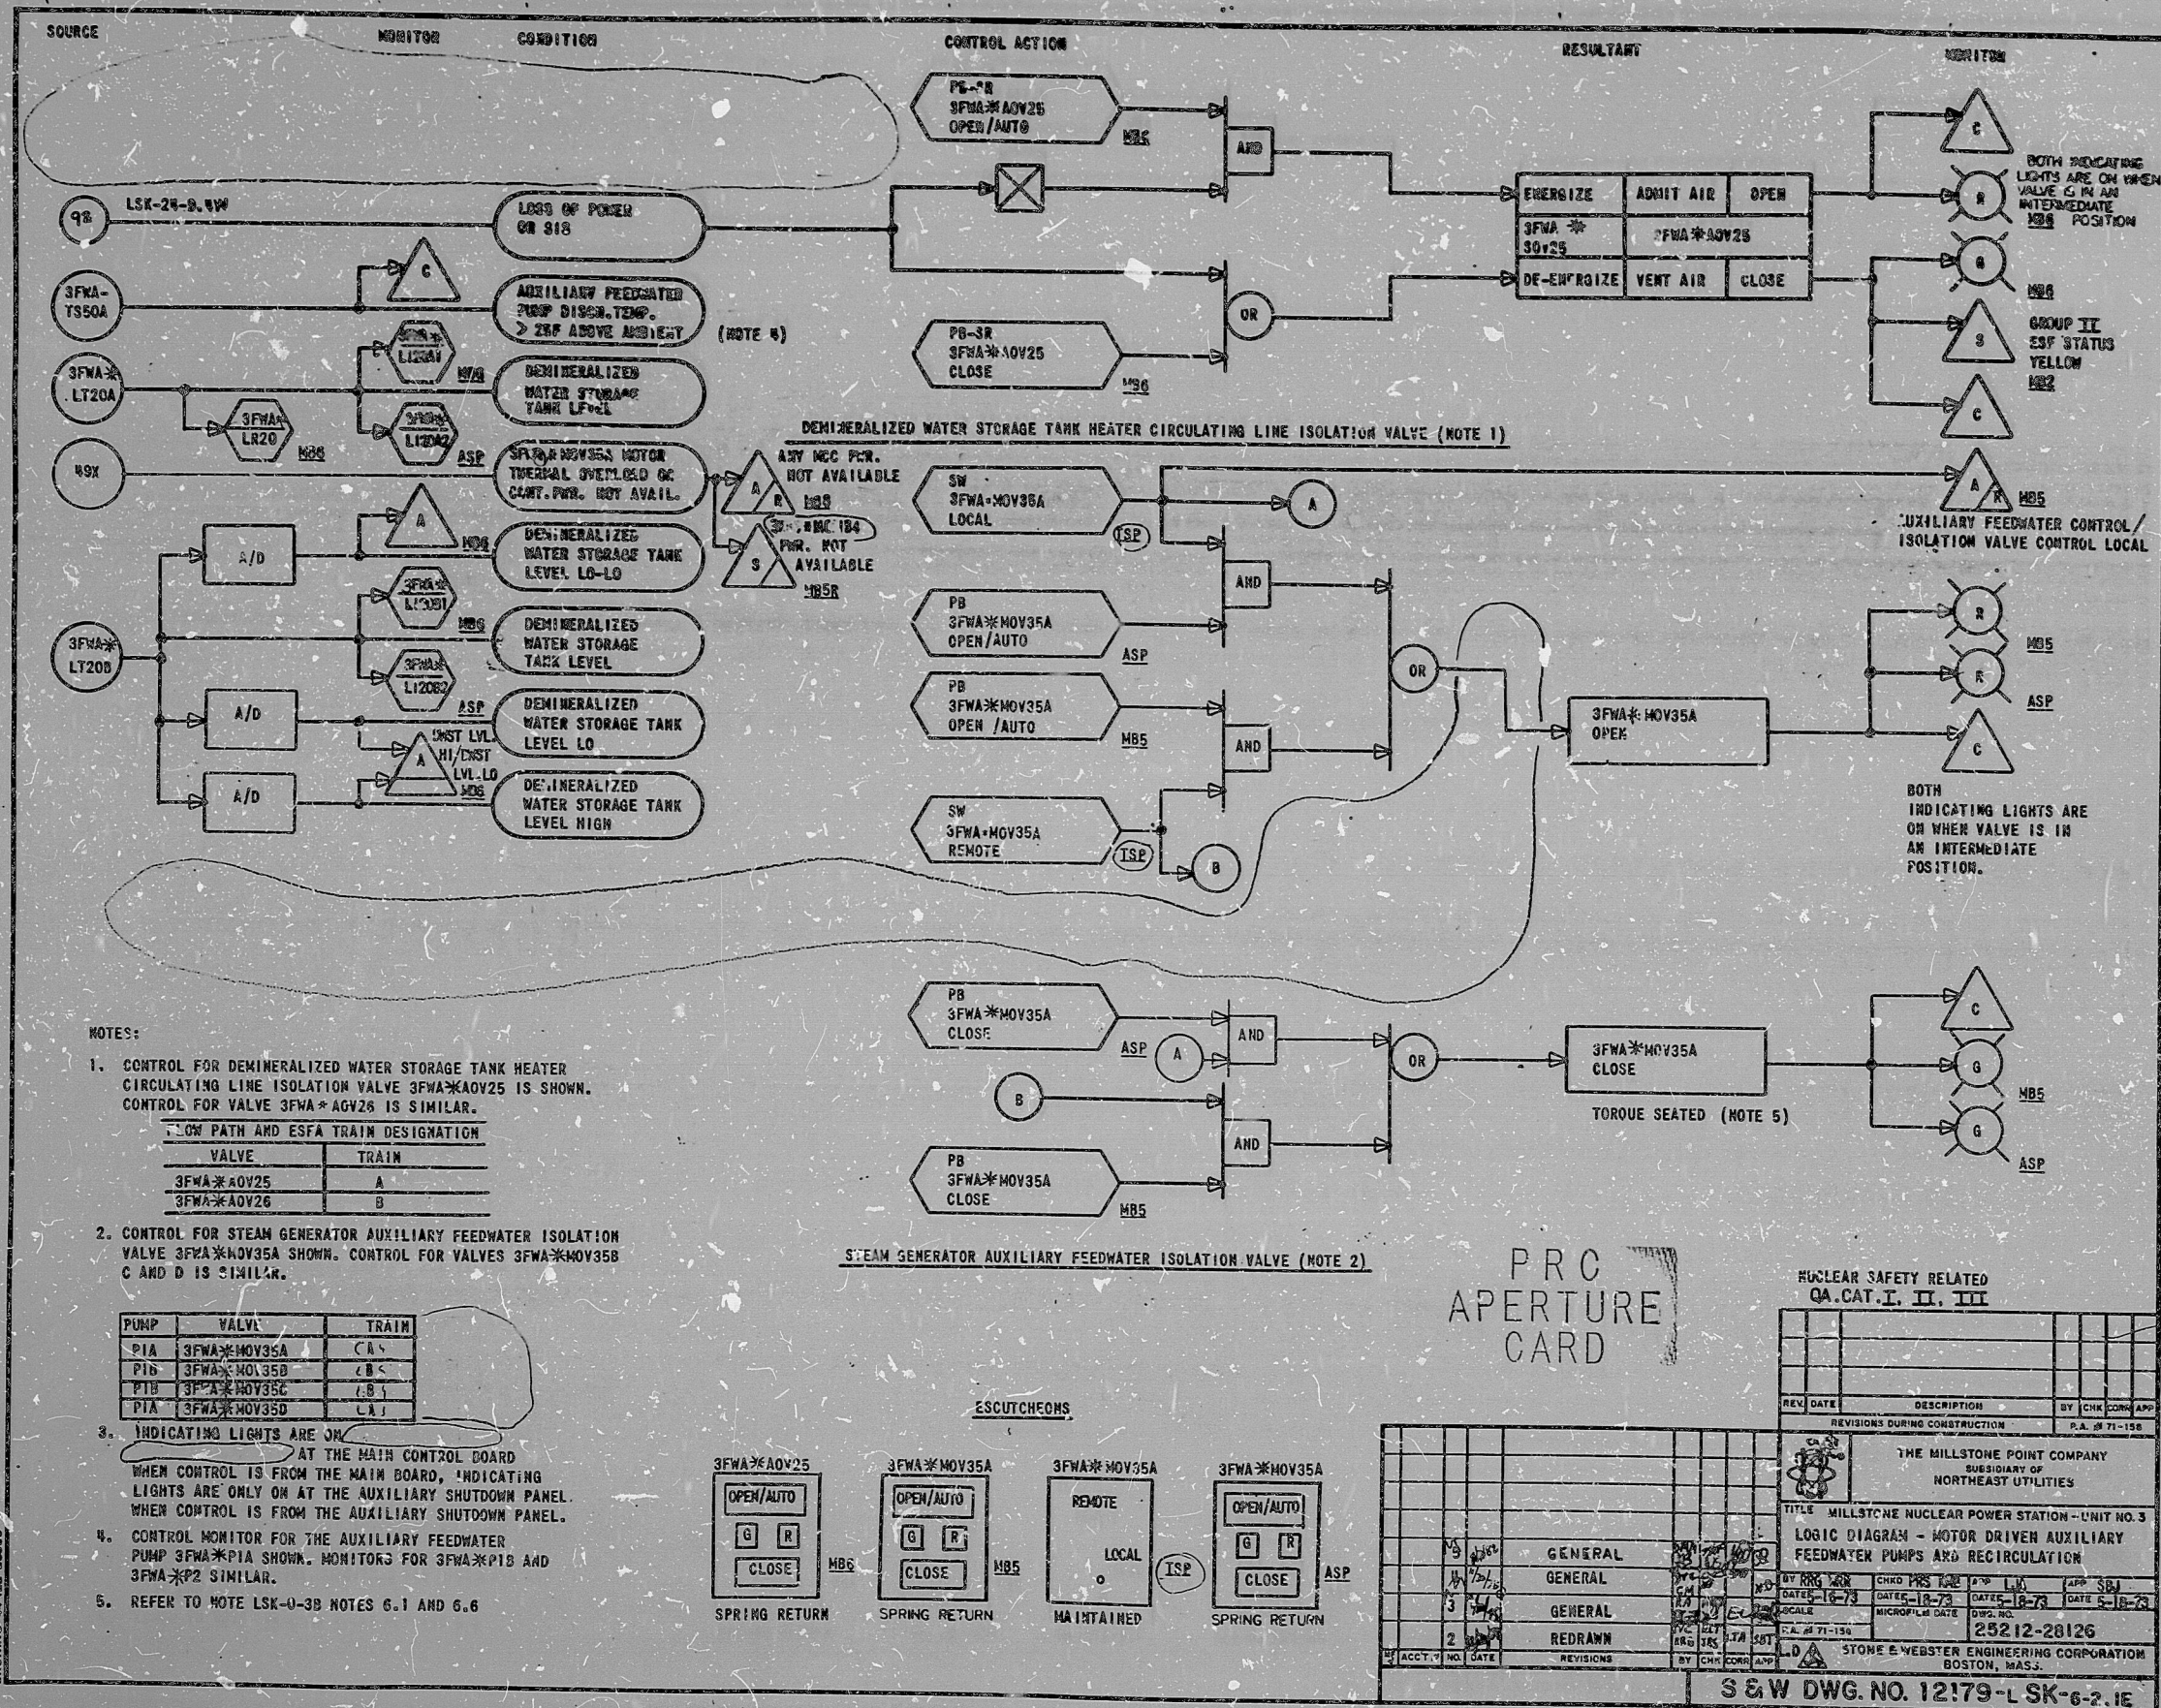



Rids

8212160 774

