

LEGEND:


- ⊙ EXTERNAL WIRE MARK (SEE NOTES 1 & 2)
- ⊙ INTERNAL WIRE MARK (SEE NOTES 1 & 2)
- ⊙ CLASS I/E DIVISION

NOTES:

- ALPHABETICAL WIRE MARKS ARE PREFIXED BY: SYSTEM NO., SHEET NO. & LINE NO. (EXAMPLE M250505A)
- POTENTIAL WIRE MARKS ARE PREFIXED BY: SYSTEM NO. & SHEET NO. (EXAMPLE M2505K1)
- DEVICE DESIGNATIONS ARE PREFIXED BY UNIT AND SYSTEM NO. (EXAMPLE M25-55)
- FOR GRAPHIC STANDARD, REFER TO DRAWING B-208-001
- DEVICES WITHOUT LOCATION MARKS ARE LOCATED IN H13-P969
- FOR RELAY STANDARDS REFER TO B-208-002

REFERENCE:

SYSTEM DIAGRAM - D-712-610
BLOCK DIAGRAM B-211-117 SP.1
B-211-118 SH.1

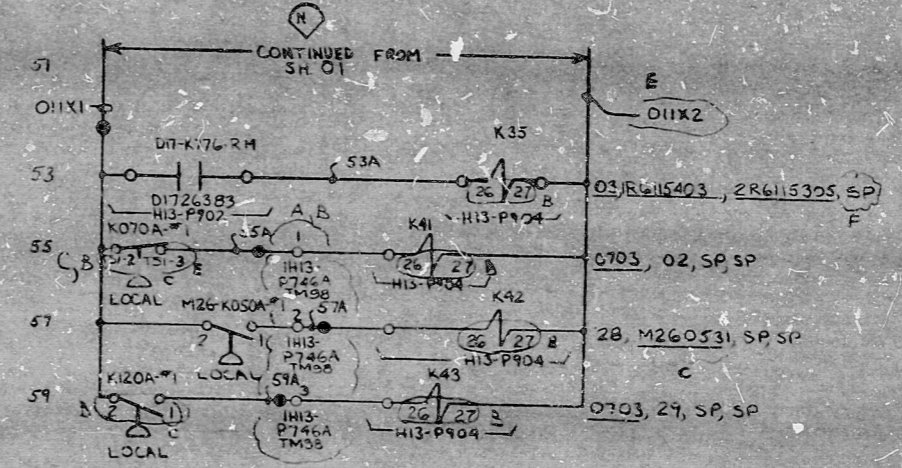

S9/H13-P904		CONTROL SWITCH	
CAM1 CONTACTS		NAMEPLATE (REV.)	
OPERATOR		CLOSE	AUTO/OPEN
TF 1	2	X	
TR 3	4		X
OPER. & BLOCK CR2940-US202A		X-CLOSED CONTACT	
SPRING RETURN TO AUTO			

S5/H13-P904		TRAIN 'A' INITIATE SWITCH	
(CAM1) CONTACTS		NAMEPLATE (REV.)	
OPERATOR		STOP	AUTO/ON
TF 1	2	X	X
TR 3	4	X	
BF 5	6	X	X
BR 7	8		X
OPER. & BLOCK CR2940-US202A		X-CLOSED CONTACT	
SPRING RETURN FROM STOP			

PRC APERTURE CARD

⊙ ⊙ NUCLEAR SAFETY RELATED

REV CONTACT ADDED WIRE MARK.	REVISED CONTACTS ON K20A-#1 REEURE SWI	REVISE RELAY CONTACTS IN K35 ONE TO K45 LINE 23 PER EGM 245-033 01-10	REVISED RELAY TYPE PER ECN 245-033 01-92, REV. FITS INFO	REVISED 4 PLACES AS PER IDCI #212 & ECN 245-033 01-10	READING PA	GILBERT ASSOCIATES, INC. ENGINEERS AND CONSULTANTS	044549-060	TELE SPB DEG TFF R2577	04 4549 B-208-117 M25 05 F										
E T P D M	D P M	C R W R A M D G	B C A G W J C	F E C H R W R P	DATE	DATE	DATE	DATE	DATE										
REV. MADE	CHKD	APPROVALS	DATE	REV. MADE	CHKD	APPROVALS	DATE	REV. MADE	CHKD	APPROVALS	DATE	REV. MADE	CHKD	APPROVALS	DATE	REV. MADE	CHKD	APPROVALS	DATE
E L E M D I A G M 2 5 T R I P L O G I C A										DRAWING NUMBER									

THE CLEVELAND ELECTRIC ILLUMINATING CO.		PERRY NUCLEAR POWER PLANT UNITS 1 & 2	
ELECTRICAL-ELEMENTARY DIAGRAM			
CONTROL ROOM HVAC TRIP LOGIC 'A'			
04	4549	B-208-117	M25 05 F

RIDS

8212170367

