

CLASSIFICATION: CLASS I DIVISION 1, NON SAFETY RELATED

NOTE: 1. ALPHABETICAL WIRE NAMES ARE PROVIDED BY SYSTEM NO., SHEET NO. & LINE NO. (EXAMPLE M25701A).

2. PREFERRED WIRE COLORS ARE OBSERVED BY SYSTEM NO. & SHEET NO. (EXAMPLE M25701A).


3. DEVICE DESIGNATIONS ARE PREFIXED BY UNIT AND SYSTEM NO. (EXAMPLE M25-07).

4. VALVE LIMIT SWITCHES SHOWN WITH SHAPE IN CLOSED POSITION.

5. FIVE GRAPHIC SYMBOLS, REFER TO SEC. B-200-001.

6. ALL REVISED WITHOUT LOCATION NAMES ARE LOCATED IN HIS-P80-0.


7. FOR SP, REFER TO SH.05

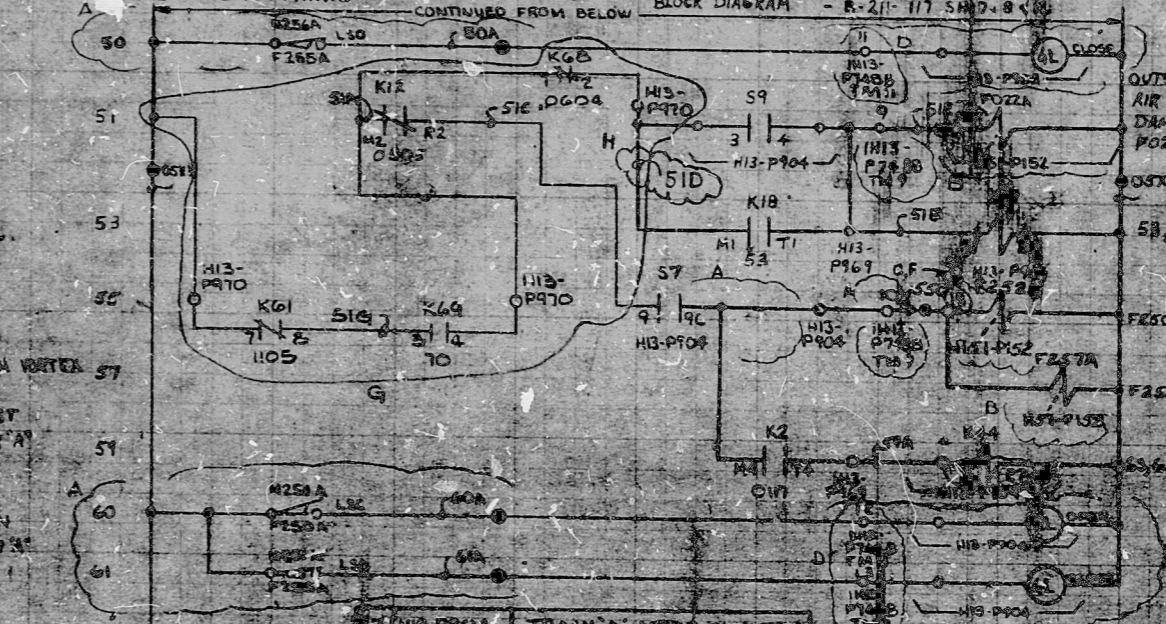

**POOR ORIGINAL**

CONTACTS	TRAIN 'A' MODE SWITCH			
	HANDLE	NAME PLATE (EV)		LOCATION
		SPOKE CLEAR	NORM. EMERG. TEST	
1-2 & 11-12	X	X	3P	
1-2 & 11-12	X	X	3P	
G.E.O. SEM MAINTAINED CONTACTS

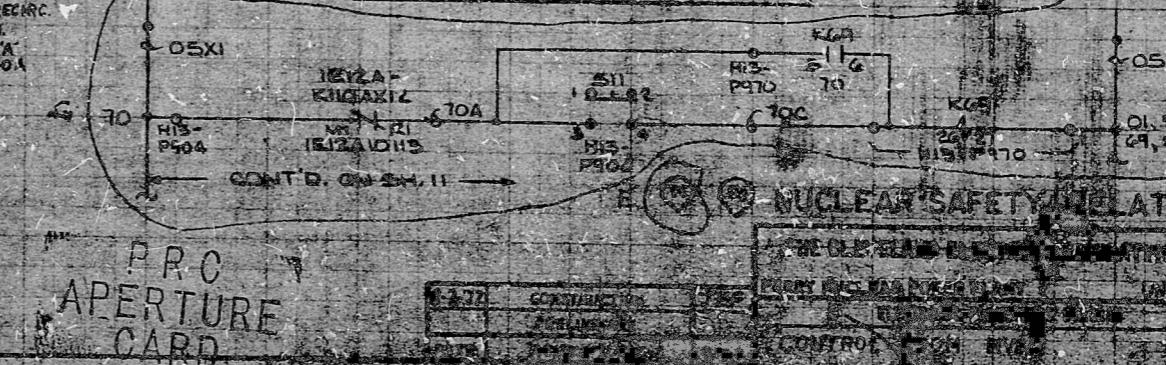

NUCLEAR SAFETY RELATED

PROC APERTURE CARD

ADD'D WIRE MARK 510

NEW TERM. PTS.

CONTROL ON HVA

11

RIDS

82 2170371

