


MOTOR CONTROL CENTER EFICOR COMPT. H
480V, AC, 3P, 60 HZ.

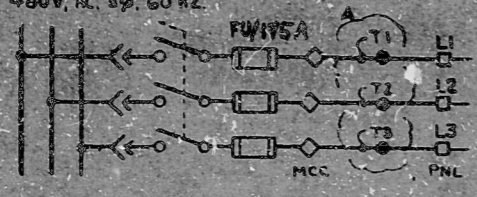

FOR CONTINUATION OF
CIRCUITRY SEE SH. 08

LEGEND:


- EXTERNAL WIRE MARKS (SEE NOTES 2 AND 3)
- INTERNAL WIRE MARKS
- MOTOR CONTROL CENTER TERMINAL
- CLASS 1E DIVISION 1
- AGASTAT RELAY TYPE GP1GM
- HEATER AND PANELBOARD TERMINALS
- H13-P904B COMMON HVAC PANEL
- H13-P969 AUX. RELAY PANEL
- H13-P746E TERMINATION CABINET, T-MOD 24

NOTES:

1. ALL DEVICES WITHOUT LOCATION MARKS ARE LOCATED IN REMOTE PANEL.
2. ALPHABETICAL WIRE MARKS ARE PREFIXED BY: SYSTEM NO., SHEET NO. AND LINE NO. (EXAMPLE M2806CEN).
3. POTENTIAL WIRE MARKS ARE PREFIXED BY: SYSTEM NO. AND SHEET NO. (EXAMPLE M2806L1).
4. DEVICE DESIGNATION ARE PREFIXED BY: SYSTEM NO. (EXAMPLE H26-S4).
5. FOR GRAPHIC STANDARDS, REFER TO DRAWING, B-206-001.

REFERENCES:

- D-912-610 SYSTEM DIAGRAM
- D-211-10-S4.5 BLOCK

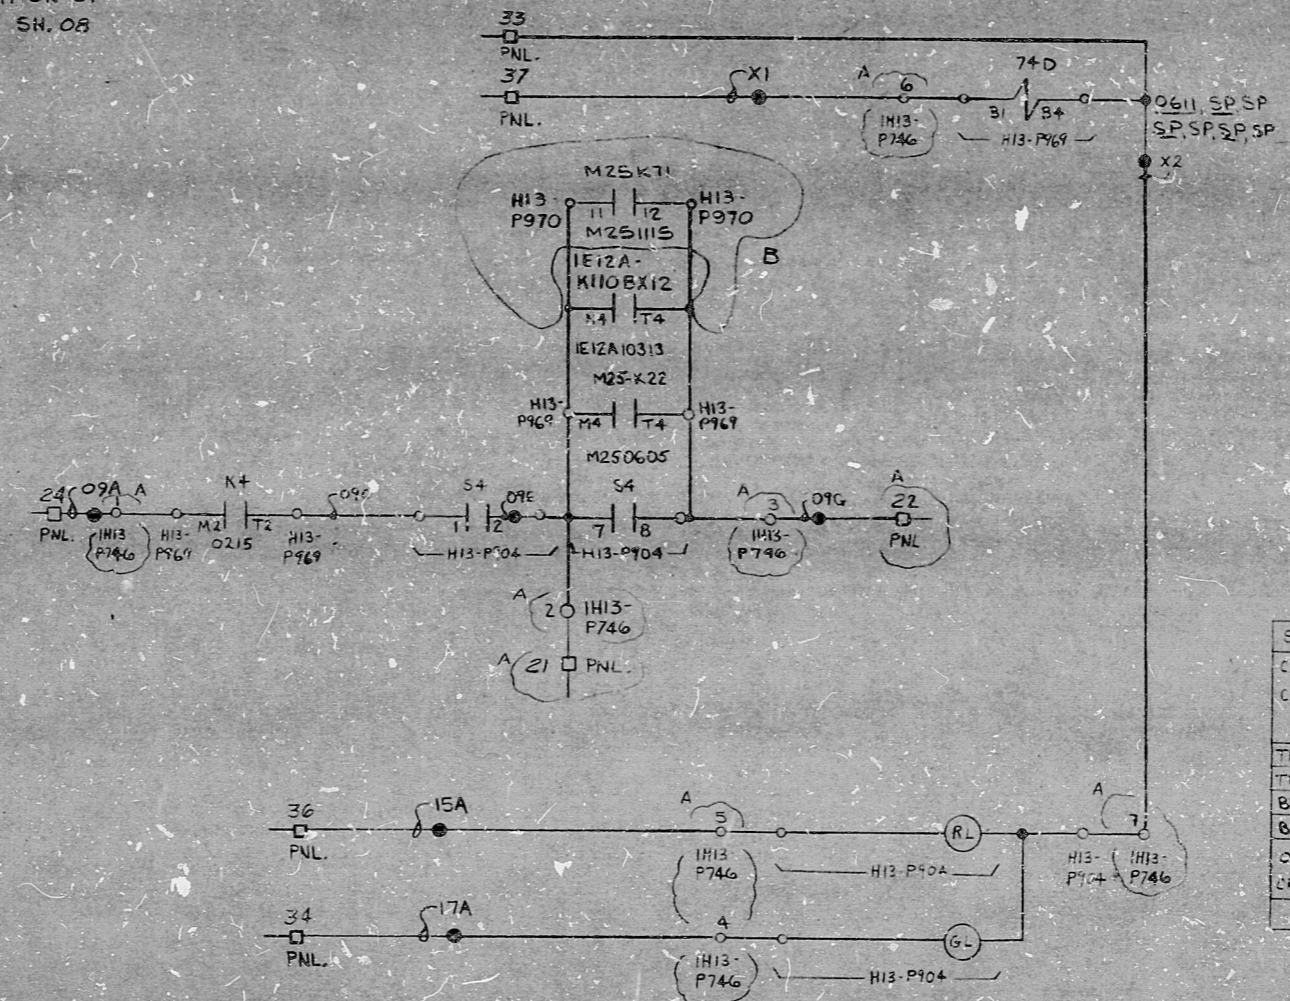

S4/H13-P904 CONTROL SWITCH				
CAM 15 CONTACTS	NAMEPLATE (EN)		CONTACT	
	OPERATOR		STOP	START
			LOCATION	
TF 1	2		X	X 01
TR 3	4	X	X	M2506ZE
BF 5	6	X	X	SP
BR 7	8		X	O9

OPER. & BLOCK
BR2940-US203E

X-CLOSED CONTACTS
SPRING RETURN TO AUTO

PRC
APERTURE
CARD

NUCLEAR SAFETY RELATED
THE CLEVELAND ELECTRIC ILLUMINATING CO.
PERRY NUCLEAR POWER PLANT UNITS 1+2
ELECTRICAL-ELEMENTARY DIAGRAM
CONTROL ROOM EMERG. REC'D.
ELECTRIC HEATING COIL
DOORB

REVISED ONE PLACE
AS PER IDCI #212 &
ECN 245-033
-01-160.

ADDED FITS INFO... CHANGED WIRE MARKS...
REVERSED INSTANT AND PANELBOARD TERMINALS 21+22 PER CIV. 6435-0012.42

GILBERT ASSOCIATES, INC. ENGINEERS AND CONSULTANTS												044549-000 TEL SPA DEG TFF 8-25-77				CH 4549 8-208-118 M26 04 B																						
REV		MADE		CHKD		APPROVALS		DATE		REV		MADE		CHKD		APPROVALS		DATE		WORK ORDER		MADE		CHKD		DR. APP.		ENG. APP.		DATE		DRAWING NUMBER		SYSTEM SH. NO.		REV.		
E L E M D I A G M 2 6 - 0 0 1 B																																						

RIDS

8212170424

