

17"

11"

8.5"

8.5"

11"

17"

17"


11"

8.5"

8.5"

11"

17"

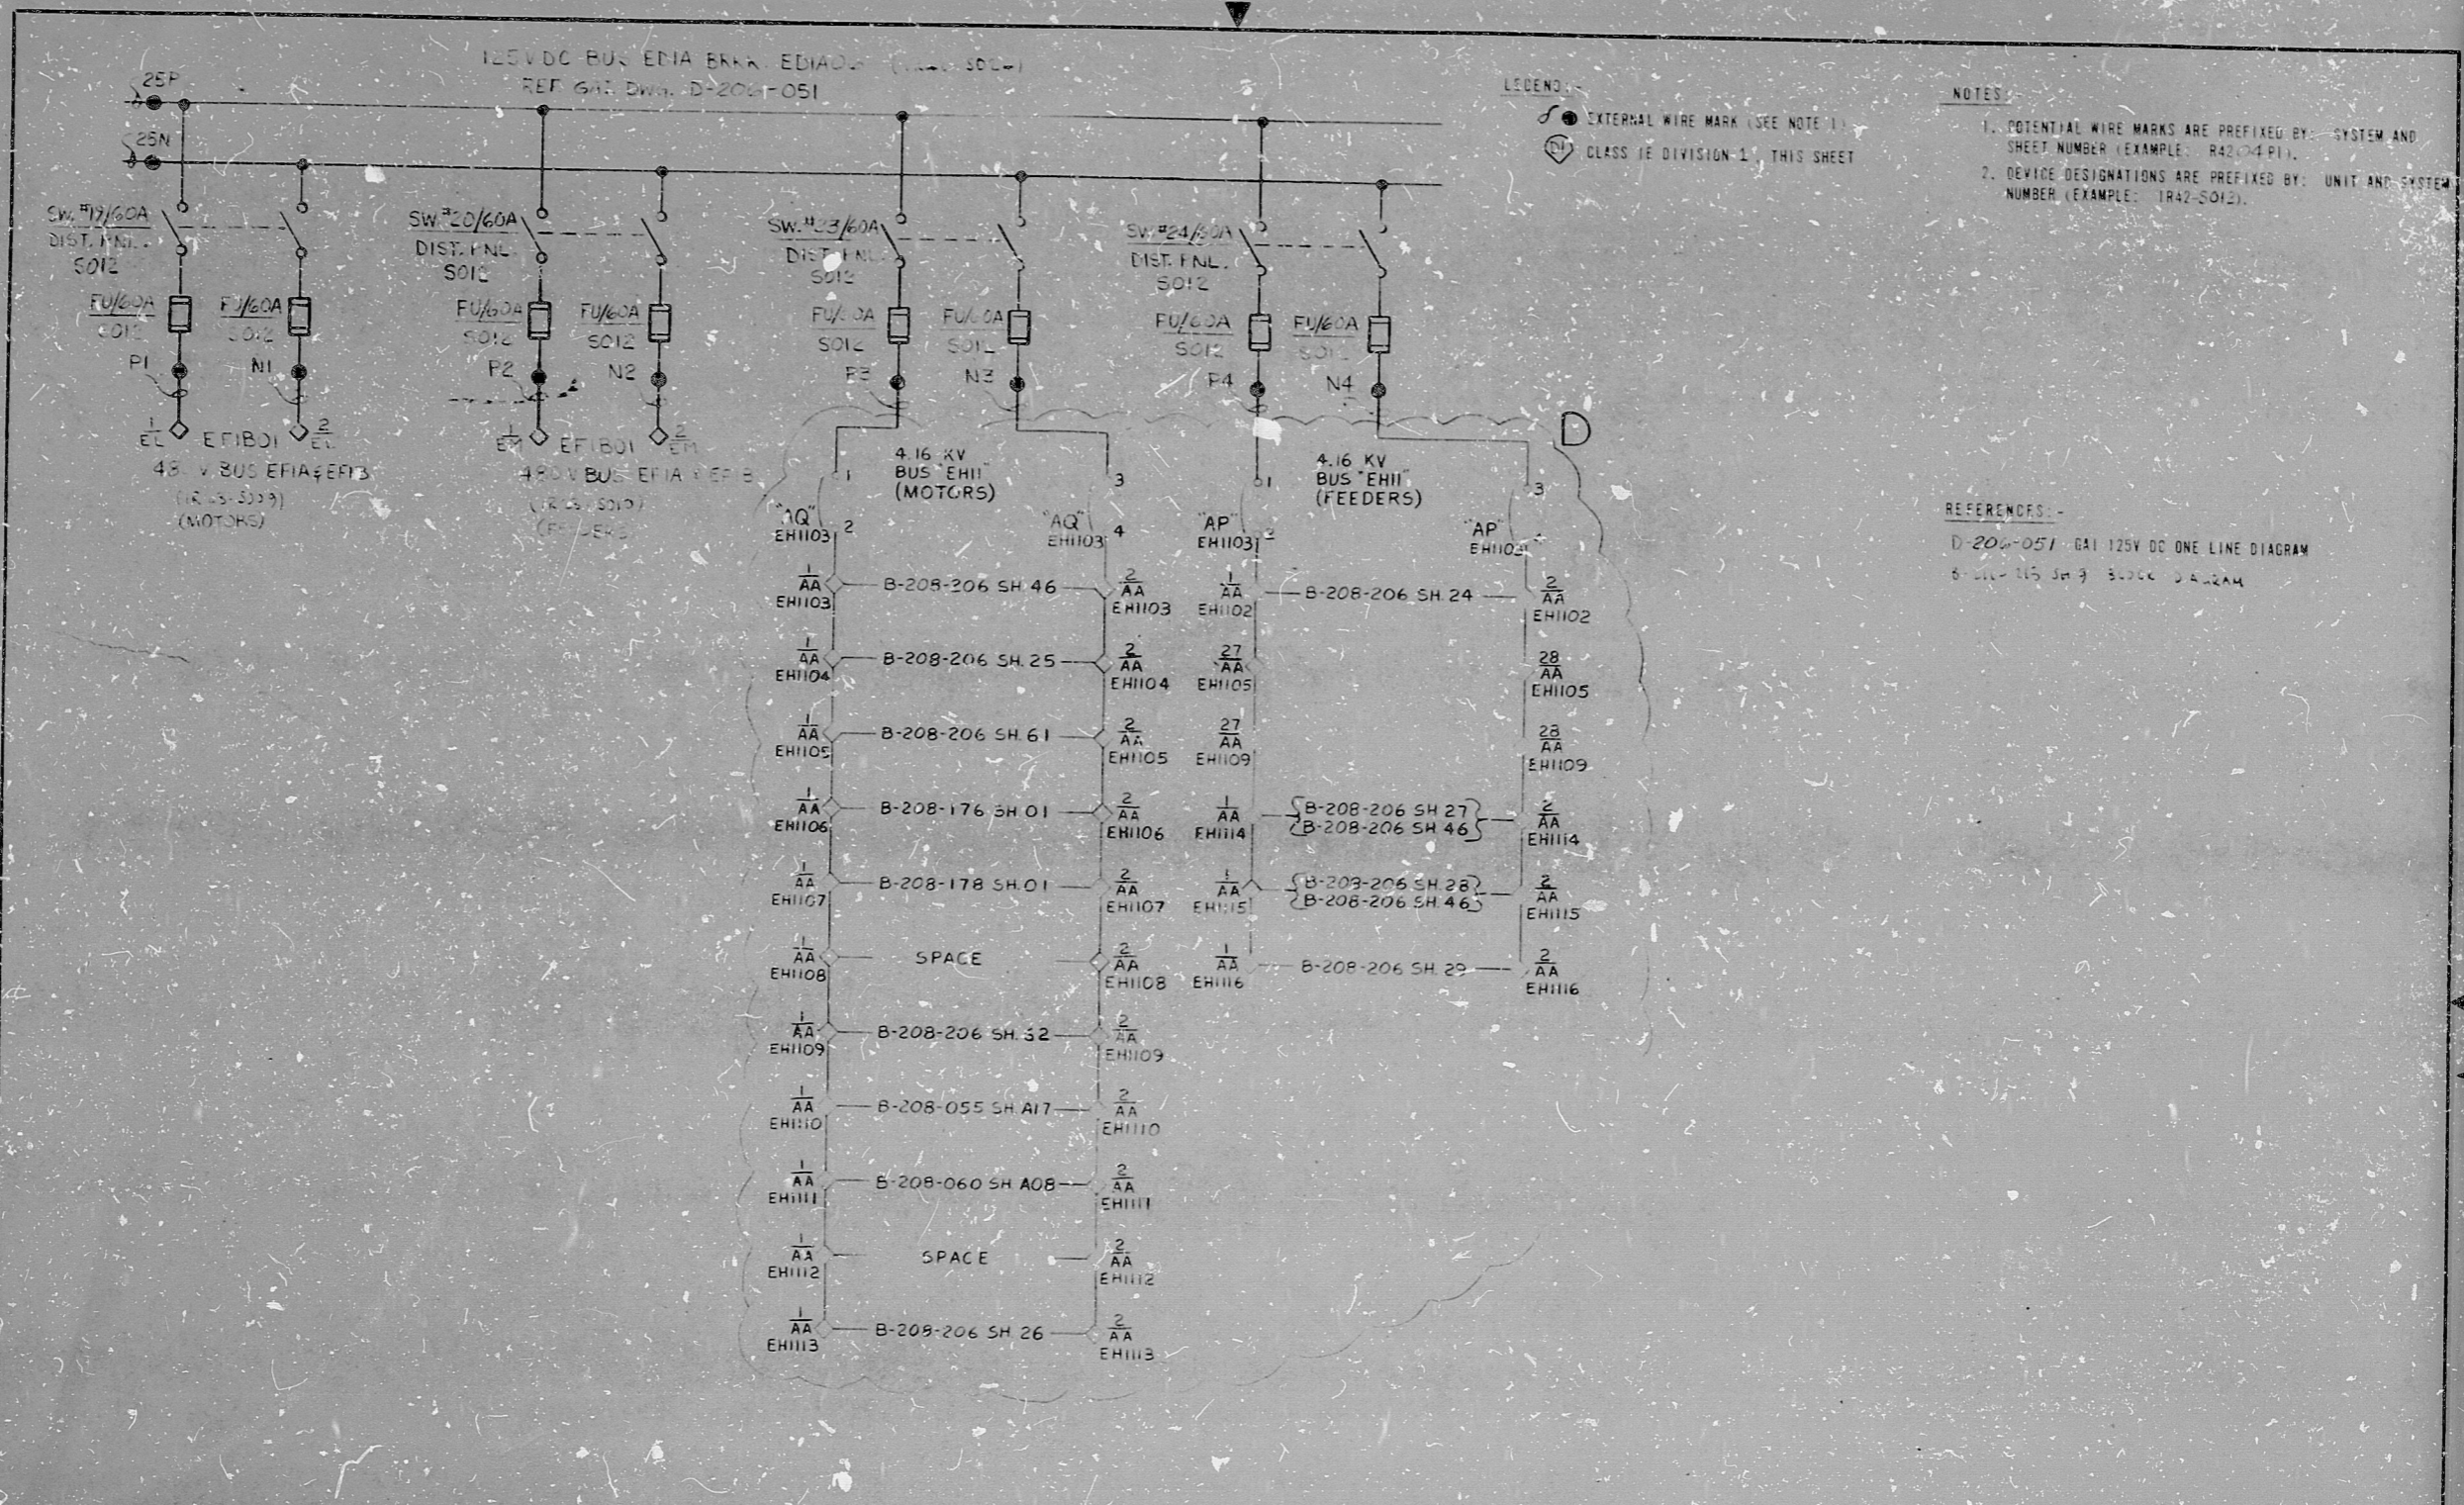

PRC APERTURE CARD

NUCLEAR SAFETY RELATED

THE CLEVELAND ELECTRIC ILLUMINATING CO.

PERRY NUCLEAR POWER PLANT UNIT 1

ELECTRICAL-ELEMENTARY DIAGRAM

D.C. SYSTEM

DISTRIBUTION PANEL R42-S012 SWITCH AND FEEDS

REVISED 1 PLACE PER ECN 8853-86-131	ADDED TERM 2 INT	REV. W 8/10/50	ADDED SW. AT N-3 & SOI. B. AT 208	READING PA	GILBERT ASSOCIATES, INC. ENGINEERS AND CONSULTANTS	044549-000	04	4549	B-208-206	R42	04	D

DRAWING NUMBER SYSTEM SH NO REV

Rids

82L2210554

