


66 11 8.5 11 17

17 11 8.5 11 17

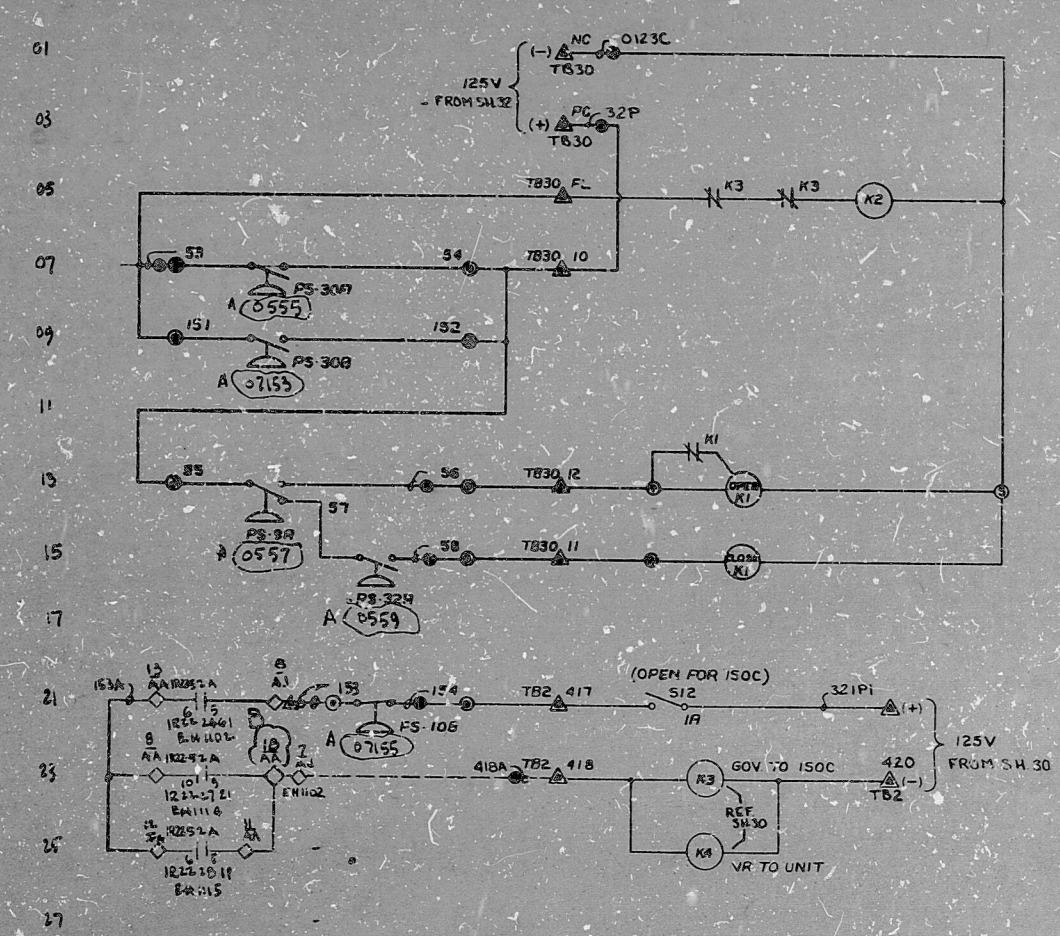

PRC APERTURE CARD

- LEGEND
- ▲ TERMINALS IN BASLER PANEL 1451-POS5A
 - TERMINALS IN DELVAL PANEL 1451-POS4A
 - ⊖ CLASS 1E, DIV. 1
 - ◇ TERMINAL IN SWGR CO BICLE

DELVAL TAPPED P.C.
 DELVAL TAPPED P.C.
 DELVAL TAPPED P.C.
 DELVAL TAPPED P.C.

INTERCONNECT DIAGRAM

52433

NUCLEAR SAFETY RELATED

THE CLEVELAND ELECTRIC ILLUMINATING CO.

PERRY NUCLEAR POWER PLANT UNIT 1

ELECTRICAL-ELEMENTARY DIAGRAM

STANDARD DIESEL GENERATOR
 DIESEL GENERATOR CONTROL
 INTERCONNECTION DIAGRAM
 DIVISION 1

DRAWING NUMBER: 4549 19-208-215
 SYSTEM: 15 B

REV.	MADE	CHKD	APPROVALS	DATE	REV.	MADE	CHKD	APPROVALS	DATE	REV.	MADE	CHKD	APPROVALS	DATE	REV.	MADE	CHKD	APPROVALS	DATE	REV.	MADE	CHKD	APPROVALS	DATE
B	RAM	REG	11-68		A	RAM	REG	11-68																

ELEM DIA 4 INTERCON DIESEL GEN

Rids

821221.058U

